
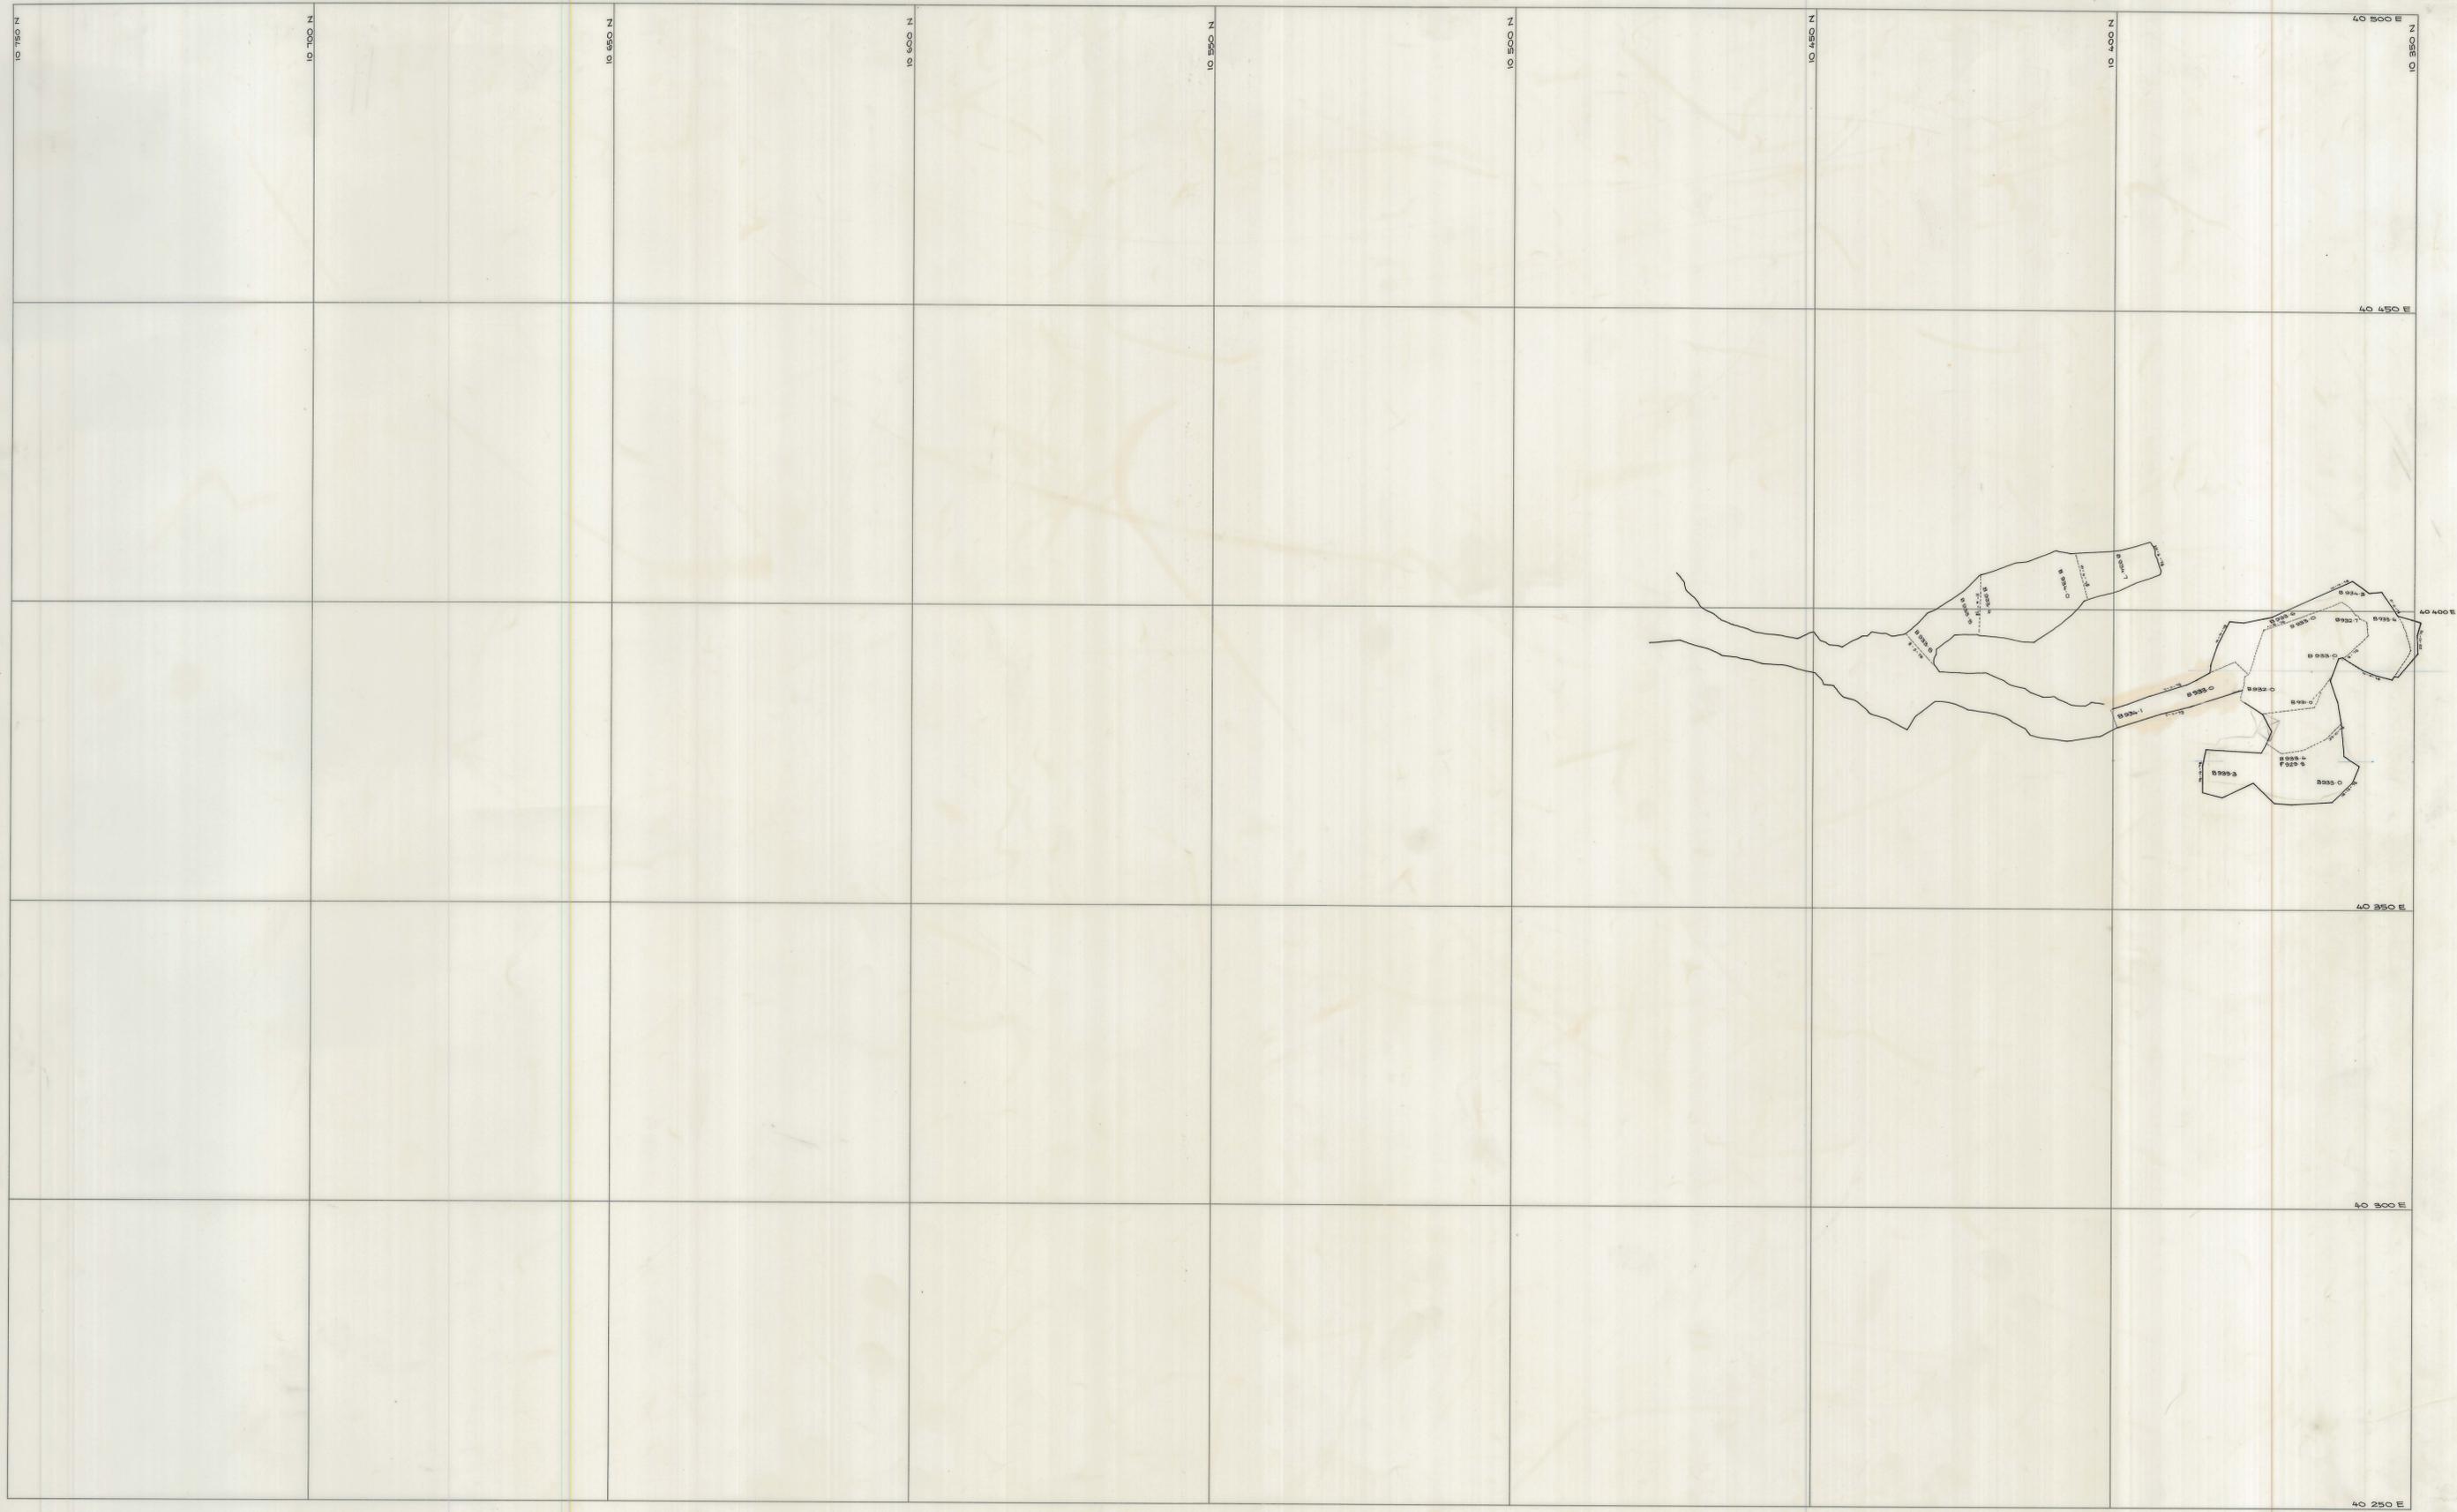


0374-191

04BH15-106-98

2nd Lift

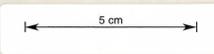

	SCALE 1:500	north	LOCATION BOLD HEAD MINE	 GRASSY KING ISLAND <small>106-98</small>
			SUBJECT 037, 043 STOPES 2nd lift	