


5 cm

04DM16-1001

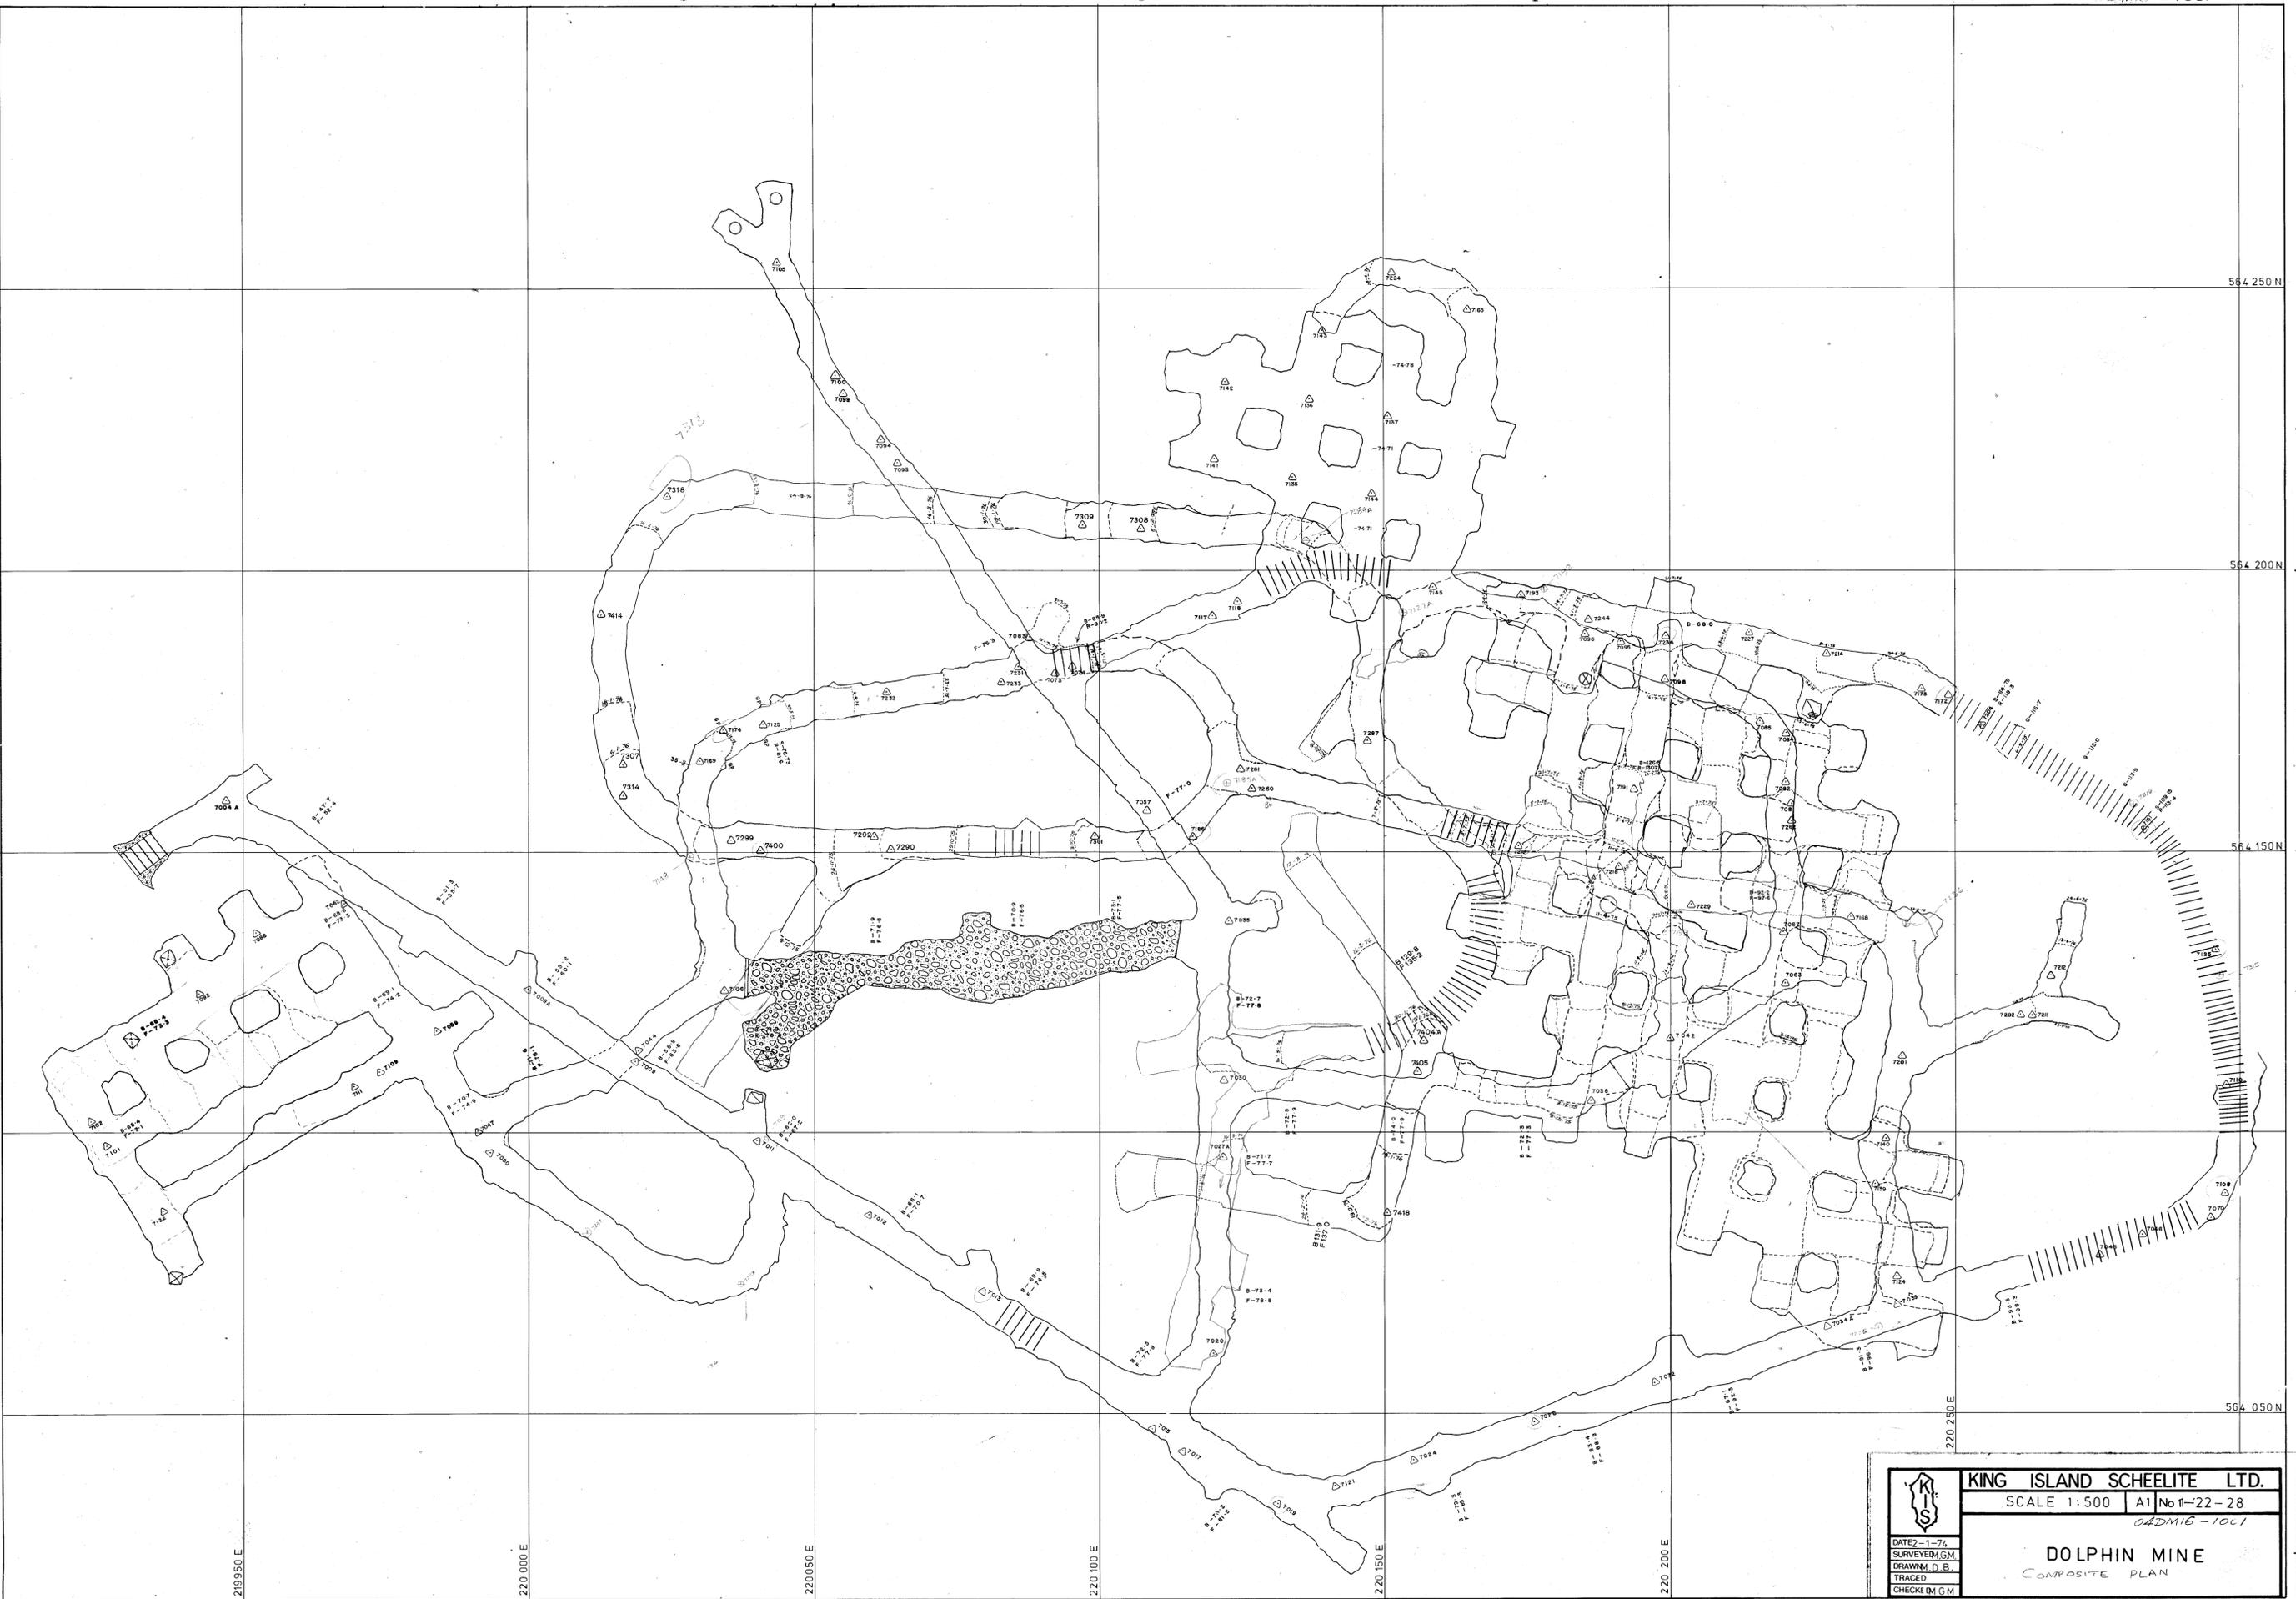

	KING ISLAND SCHEELITE LTD.	
	SCALE 1:500	A1 No 11-22-28
04DM16-1001		
DOLPHIN MINE		
COMPOSITE PLAN		
DATE: 1-74	SURVEYED BY: G.M.	
DRAWN BY: D.B.		CHECKED BY: G.M.

D | E | F | G | H | I | J | K | L | M | N | O | P | Q | R | S

22
21
20
19
18
17
16
15
14
13
12

564 250 N
564 200 N
564 150 N
564 050 N

21950 E
220 000 E
220 050 E
220 100 E
220 150 E
220 200 E
220 250 E