


5m

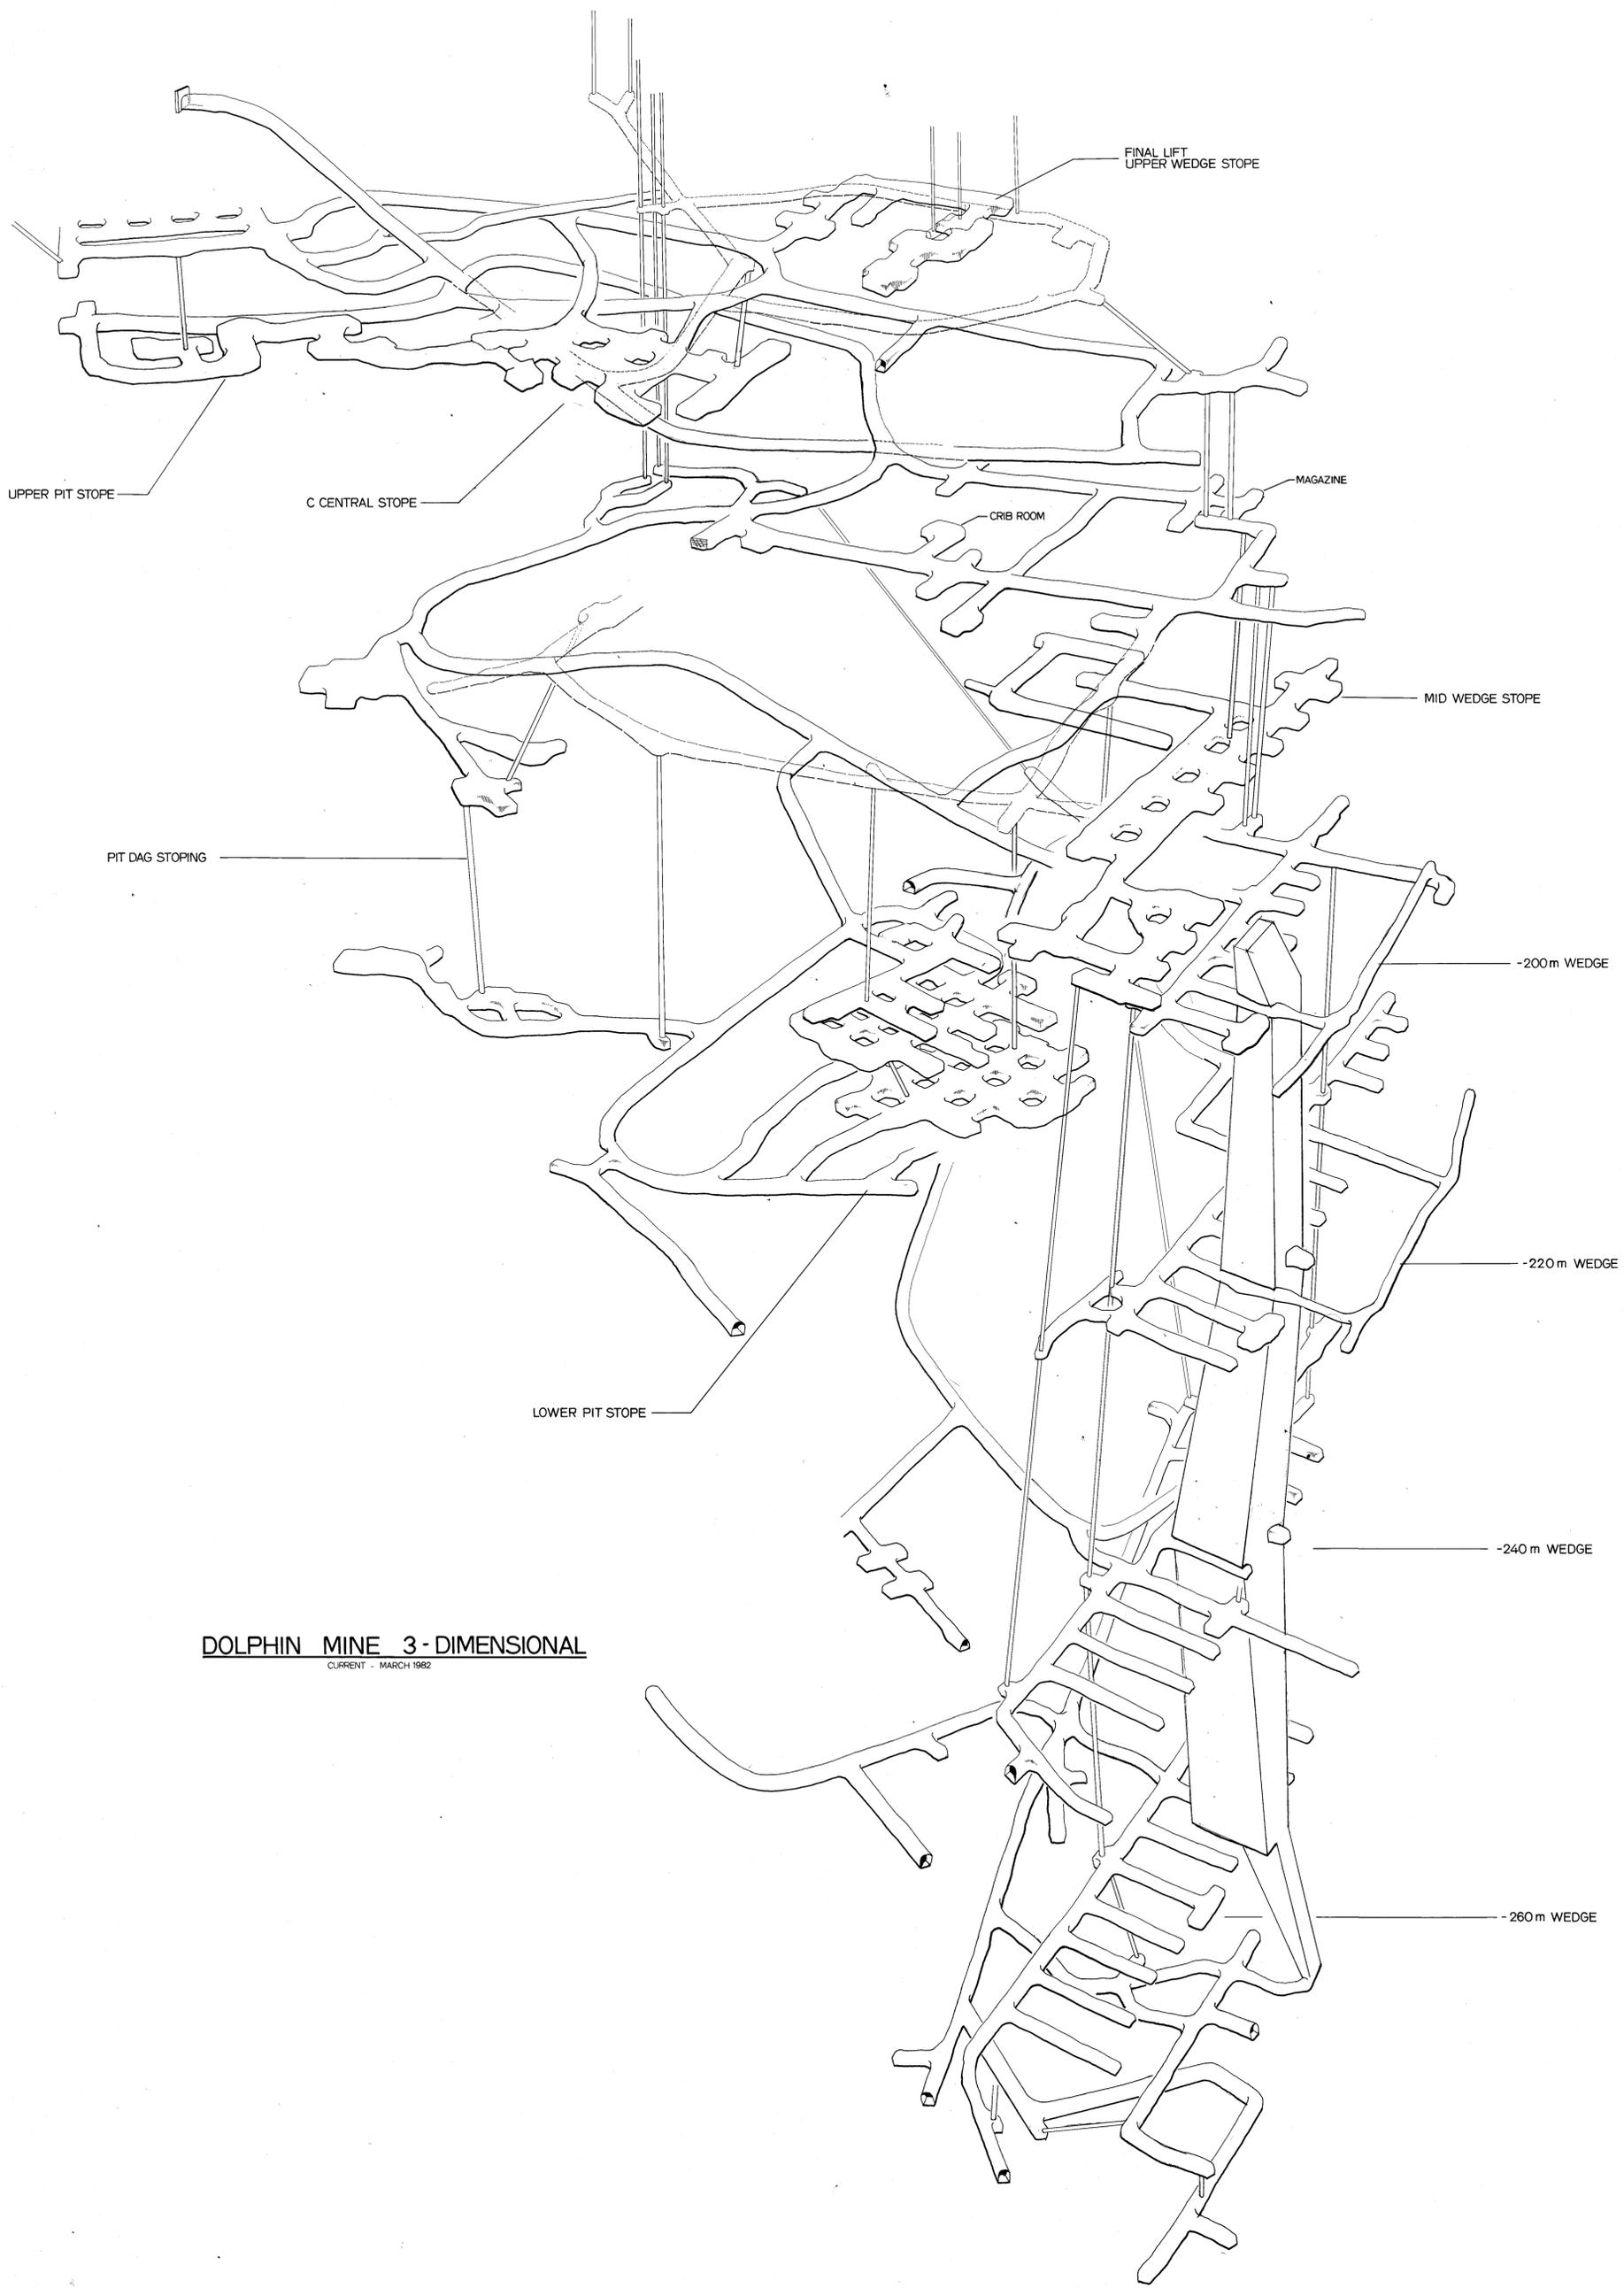

DOLPHIN MINE 3-DIMENSIONAL
CURRENT - MARCH 1982

ROLL 18
ID. 641

CHAMBERS - 1004