


0374-192



SCALE 1:500

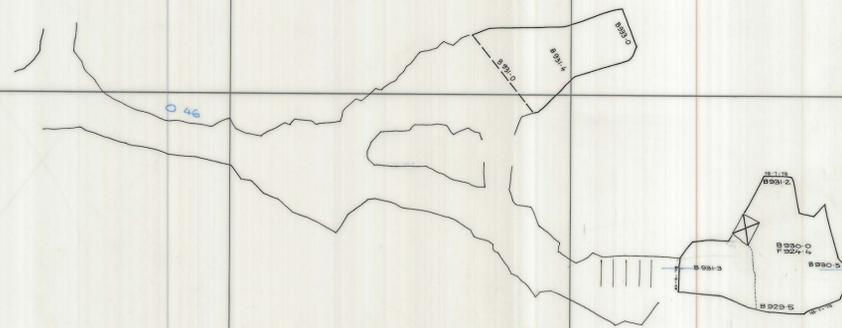

north

LOCATION BOLD HEAD MINE

SUBJECT 043, 037 STOPES
1st lift

KIS KING ISLAND SCHEELITE
A DIVISION OF WARMAN INTERNATIONAL

GRASSY KING ISLAND

PLAN NUMBER 04BH15 - 106 - 99