

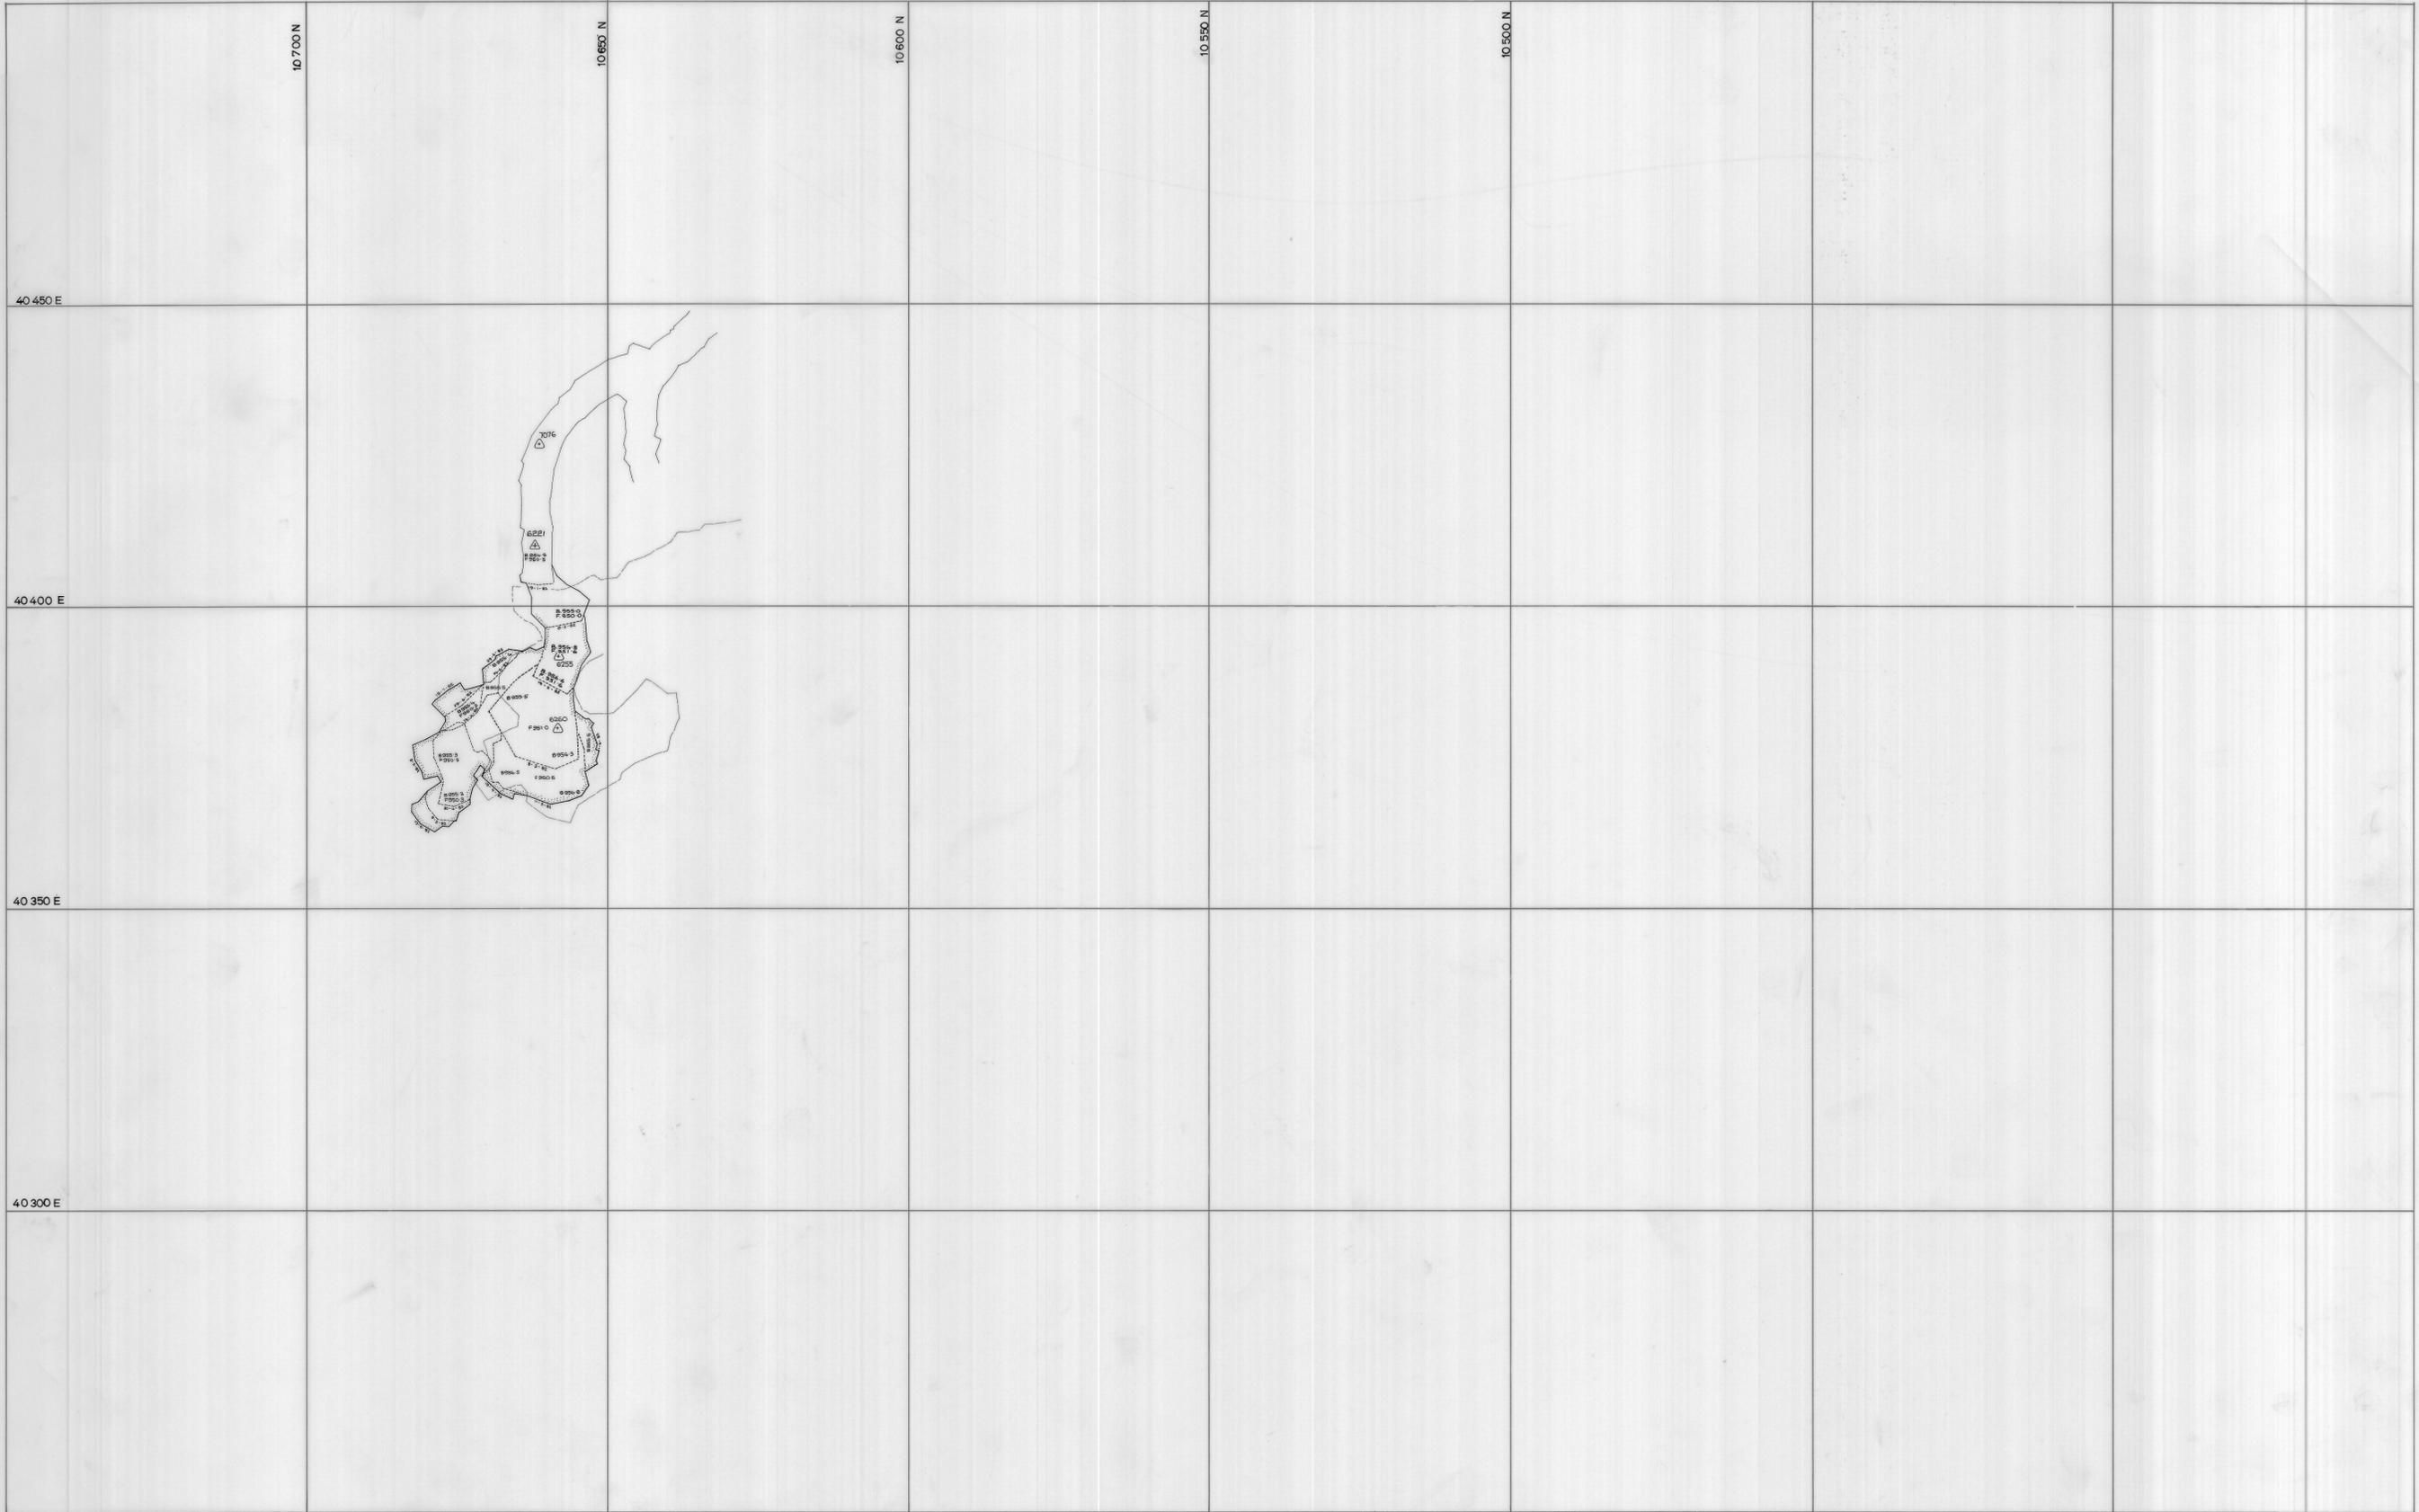


0374-195

04 BH15 - 107 - 92

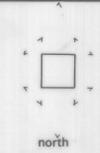

SCALE 1:500

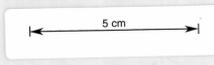

LOCATION BOLD HEAD MINE  
 SUBJECT R 60 STOPE  
 8th lift



04 BH15 - 107 - 92