

0324-186

04BH15-107-93

10 700 N

10 650 N

10 600 N

10 550 N


10 500 N

40 450 E

40 400 E


40 350 E

40 300 E

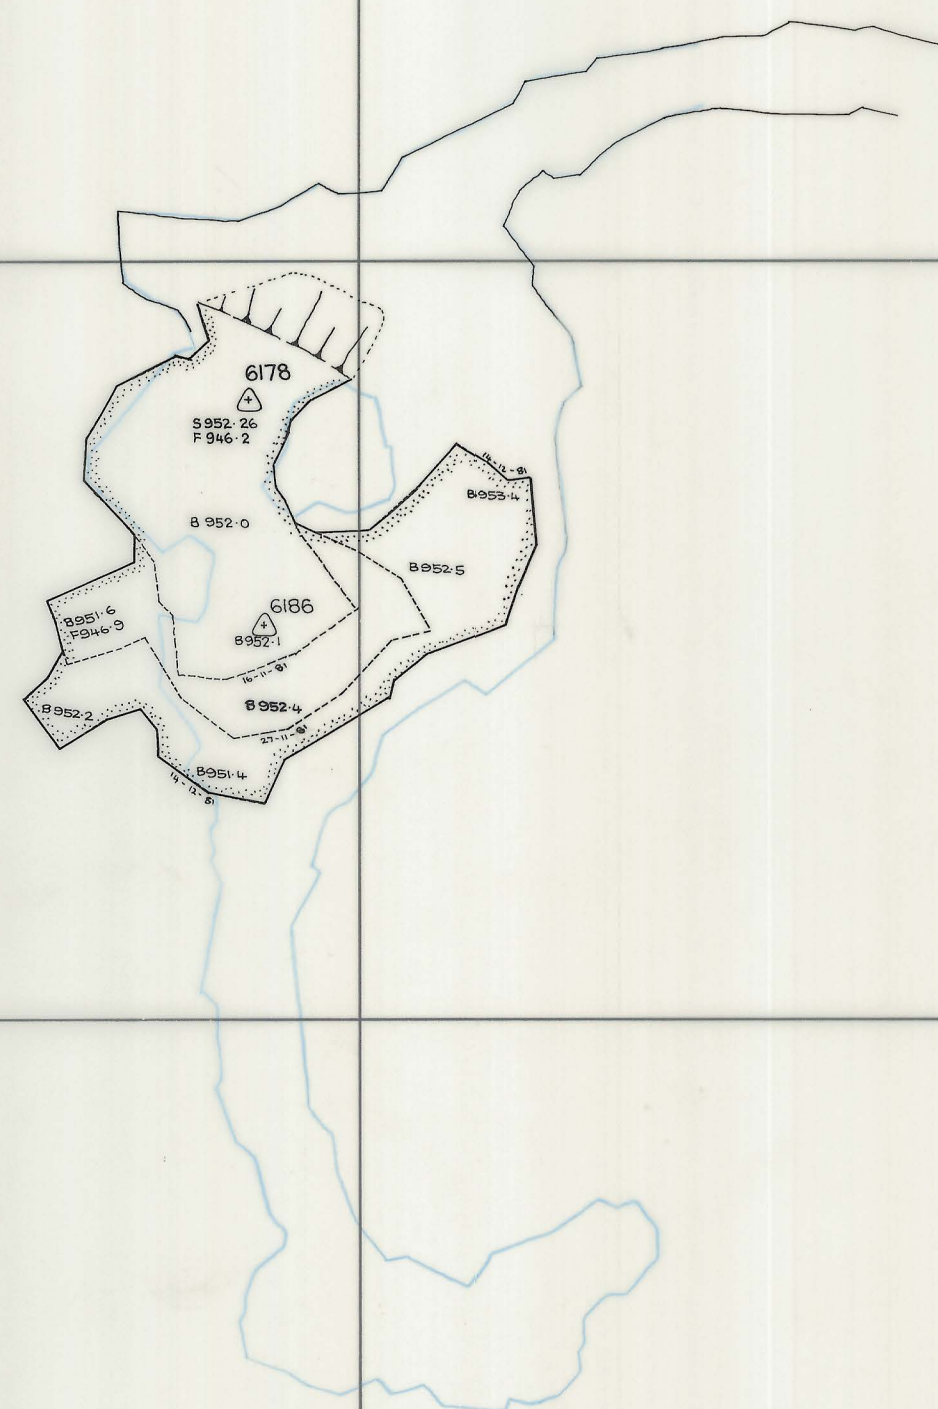

SCALE 1: 500

5 cm

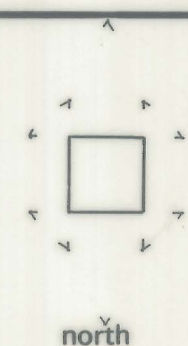

LOCATION

BOLD HEAD MINE

SUBJECT

R 60 STOPE
7 th lift

KIS KING ISLAND SCHEELITE
A DIVISION OF WARMAN INTERNATIONAL

GRASSY 107 - 93 KING ISLAND

PLAN NUMBER

04BH15 - 107 - 93