


5m

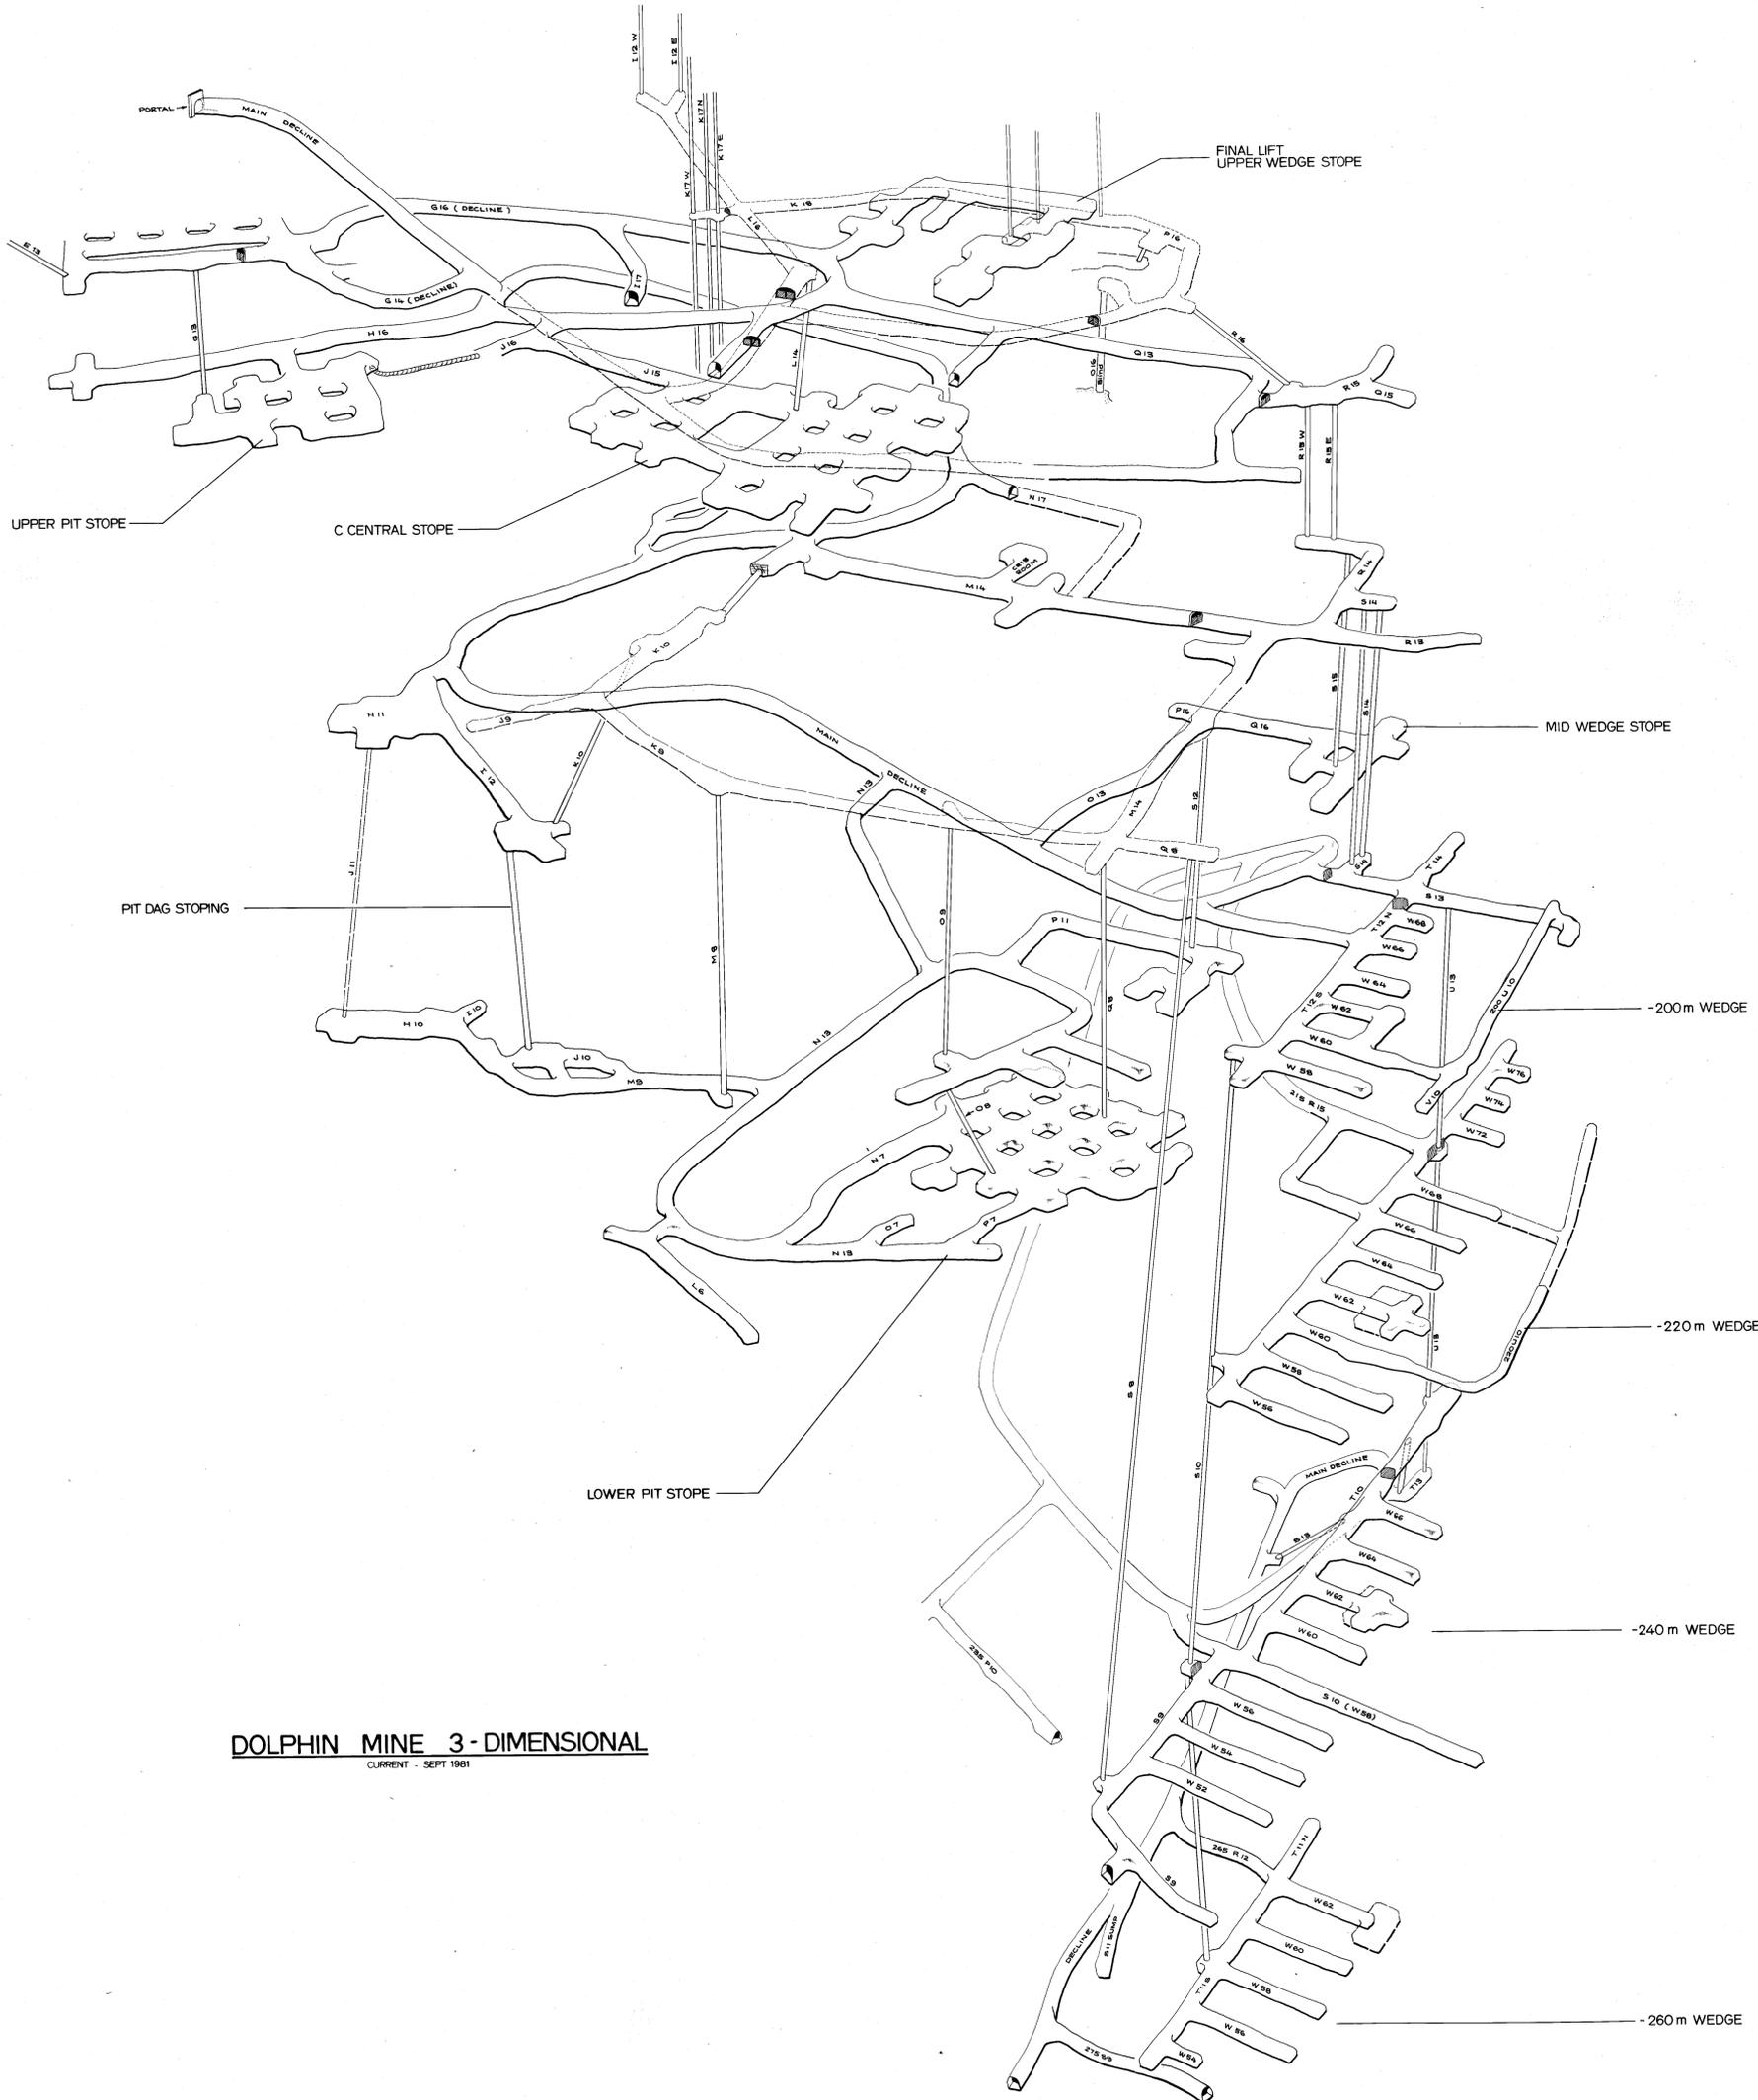

DOLPHIN MINE 3-DIMENSIONAL
CURRENT - SEPT 1981

Roll 48
ID. 2162

05 DINO9 OUS/AM/L

28