


5cm

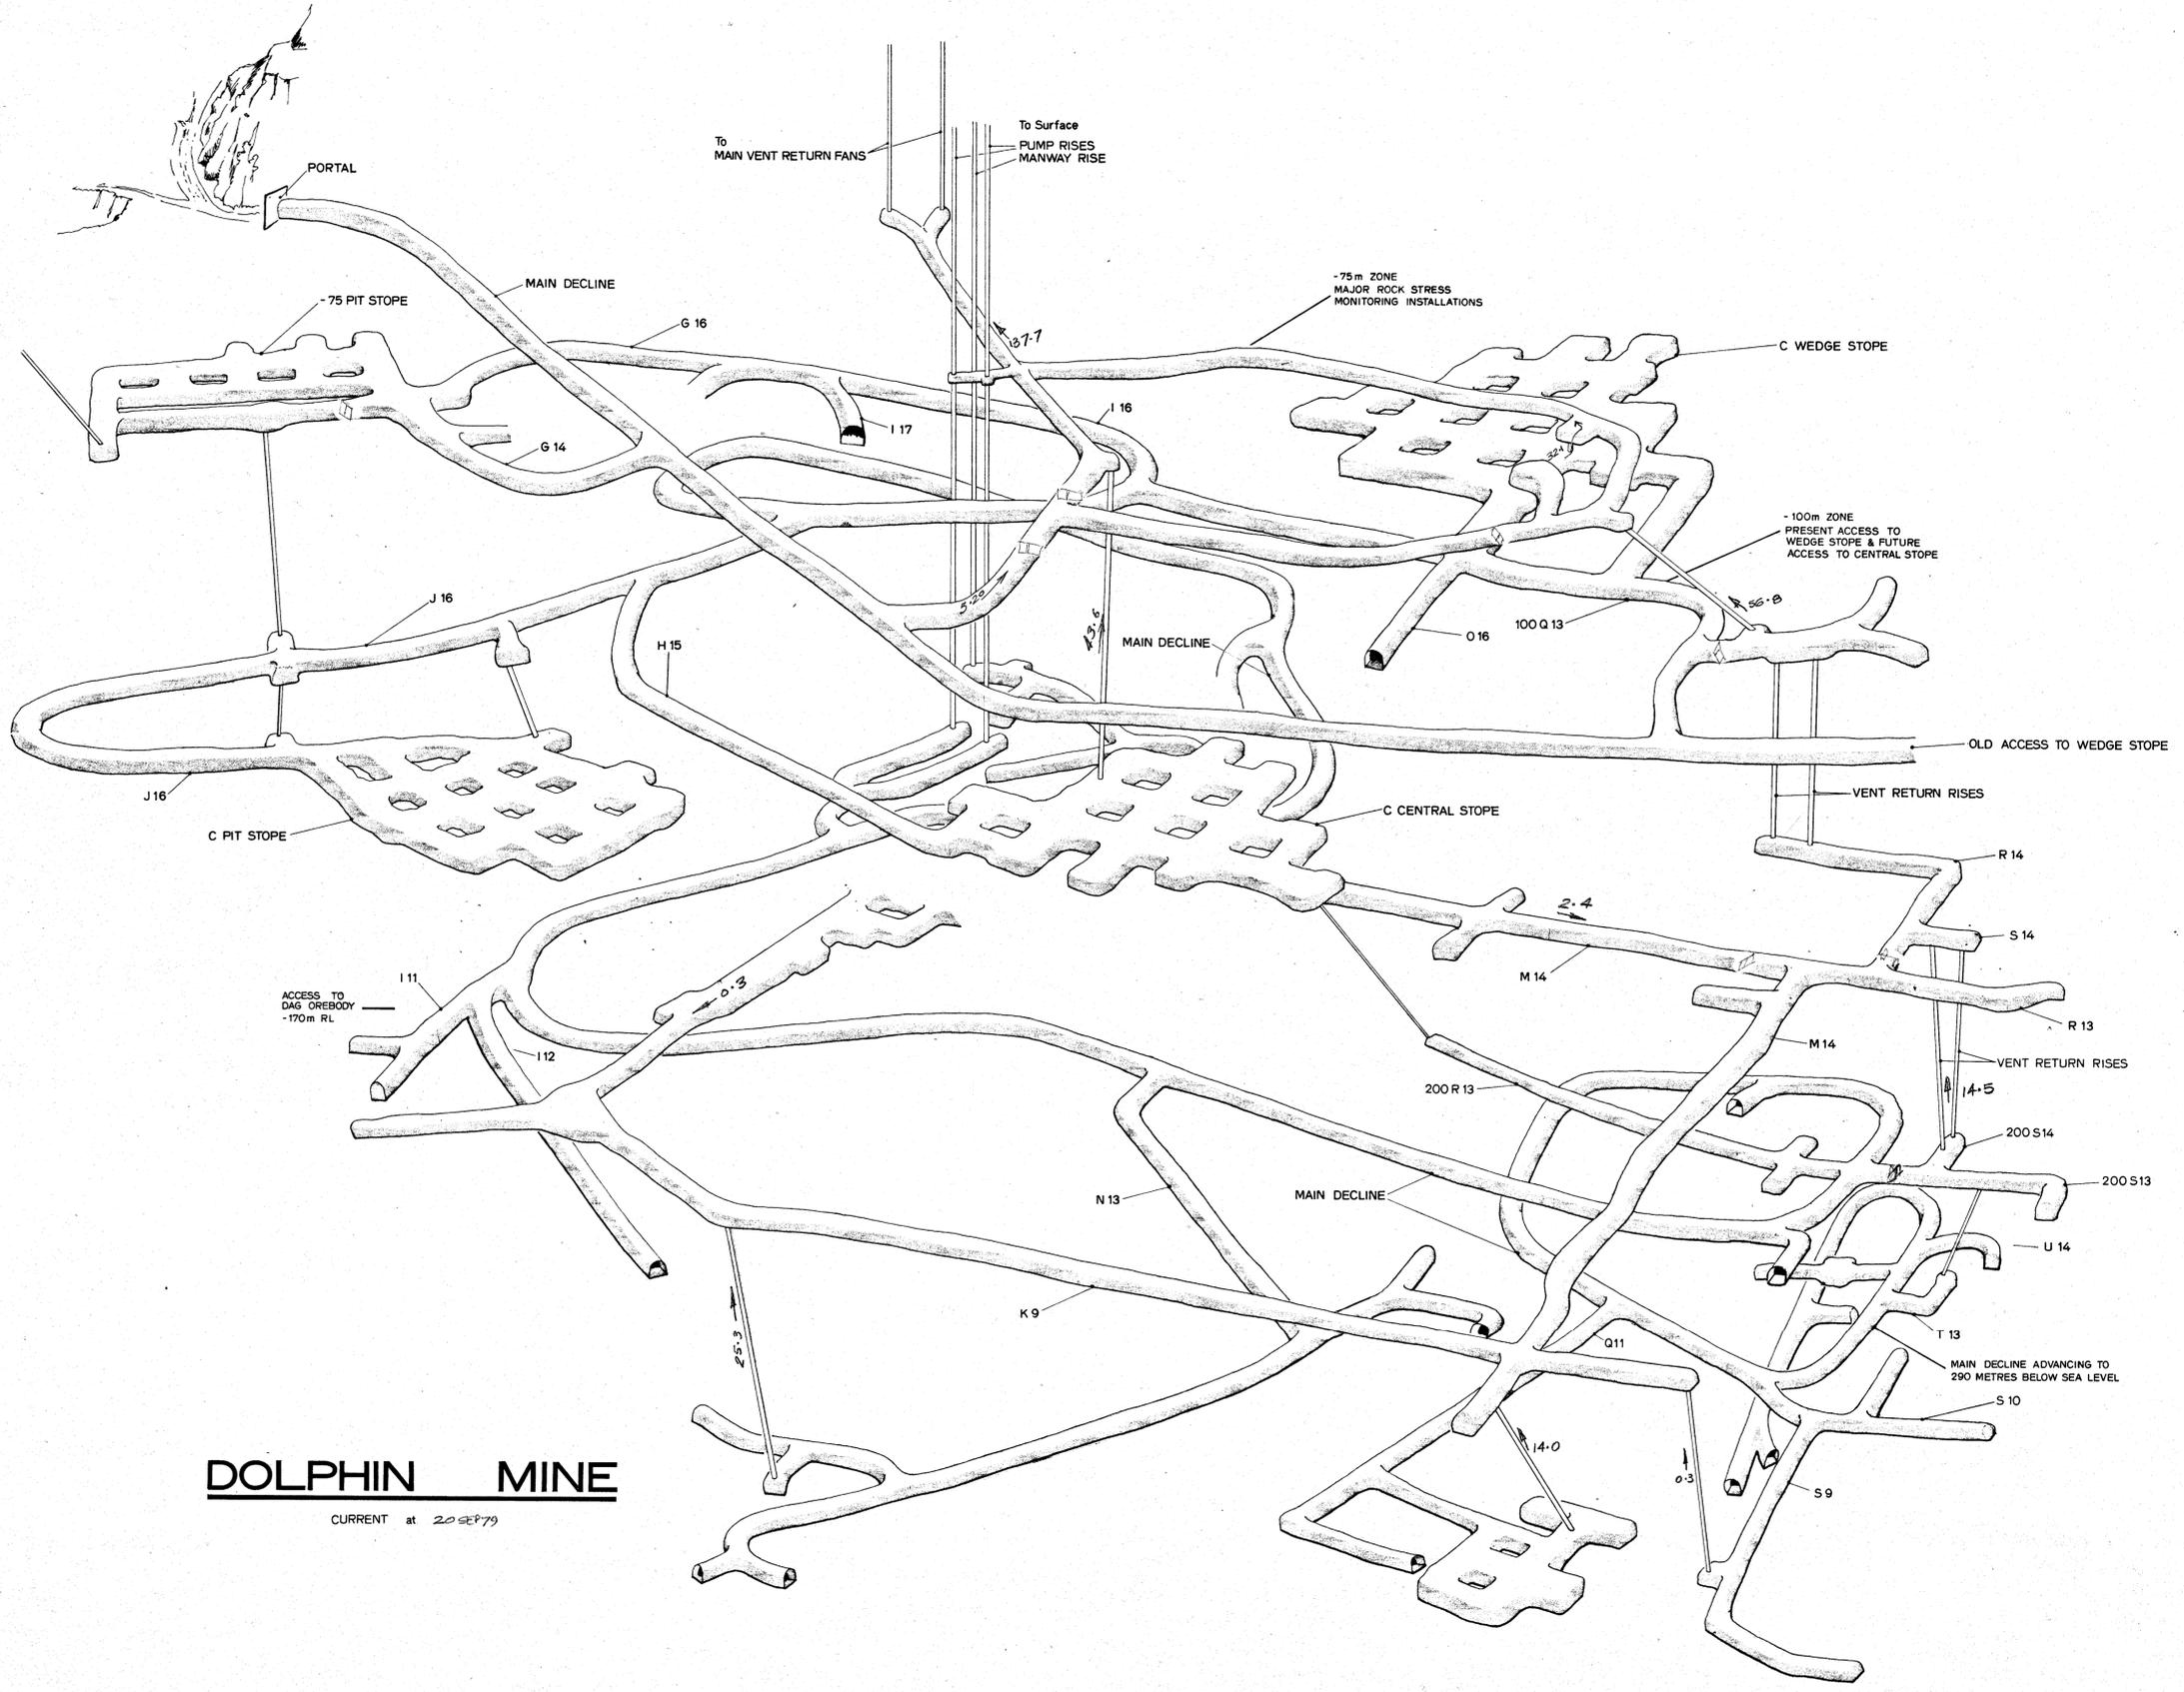

DOLPHIN MINE

CURRENT at 20 SEP 79