


5m

ID. 2332

ROLL 50

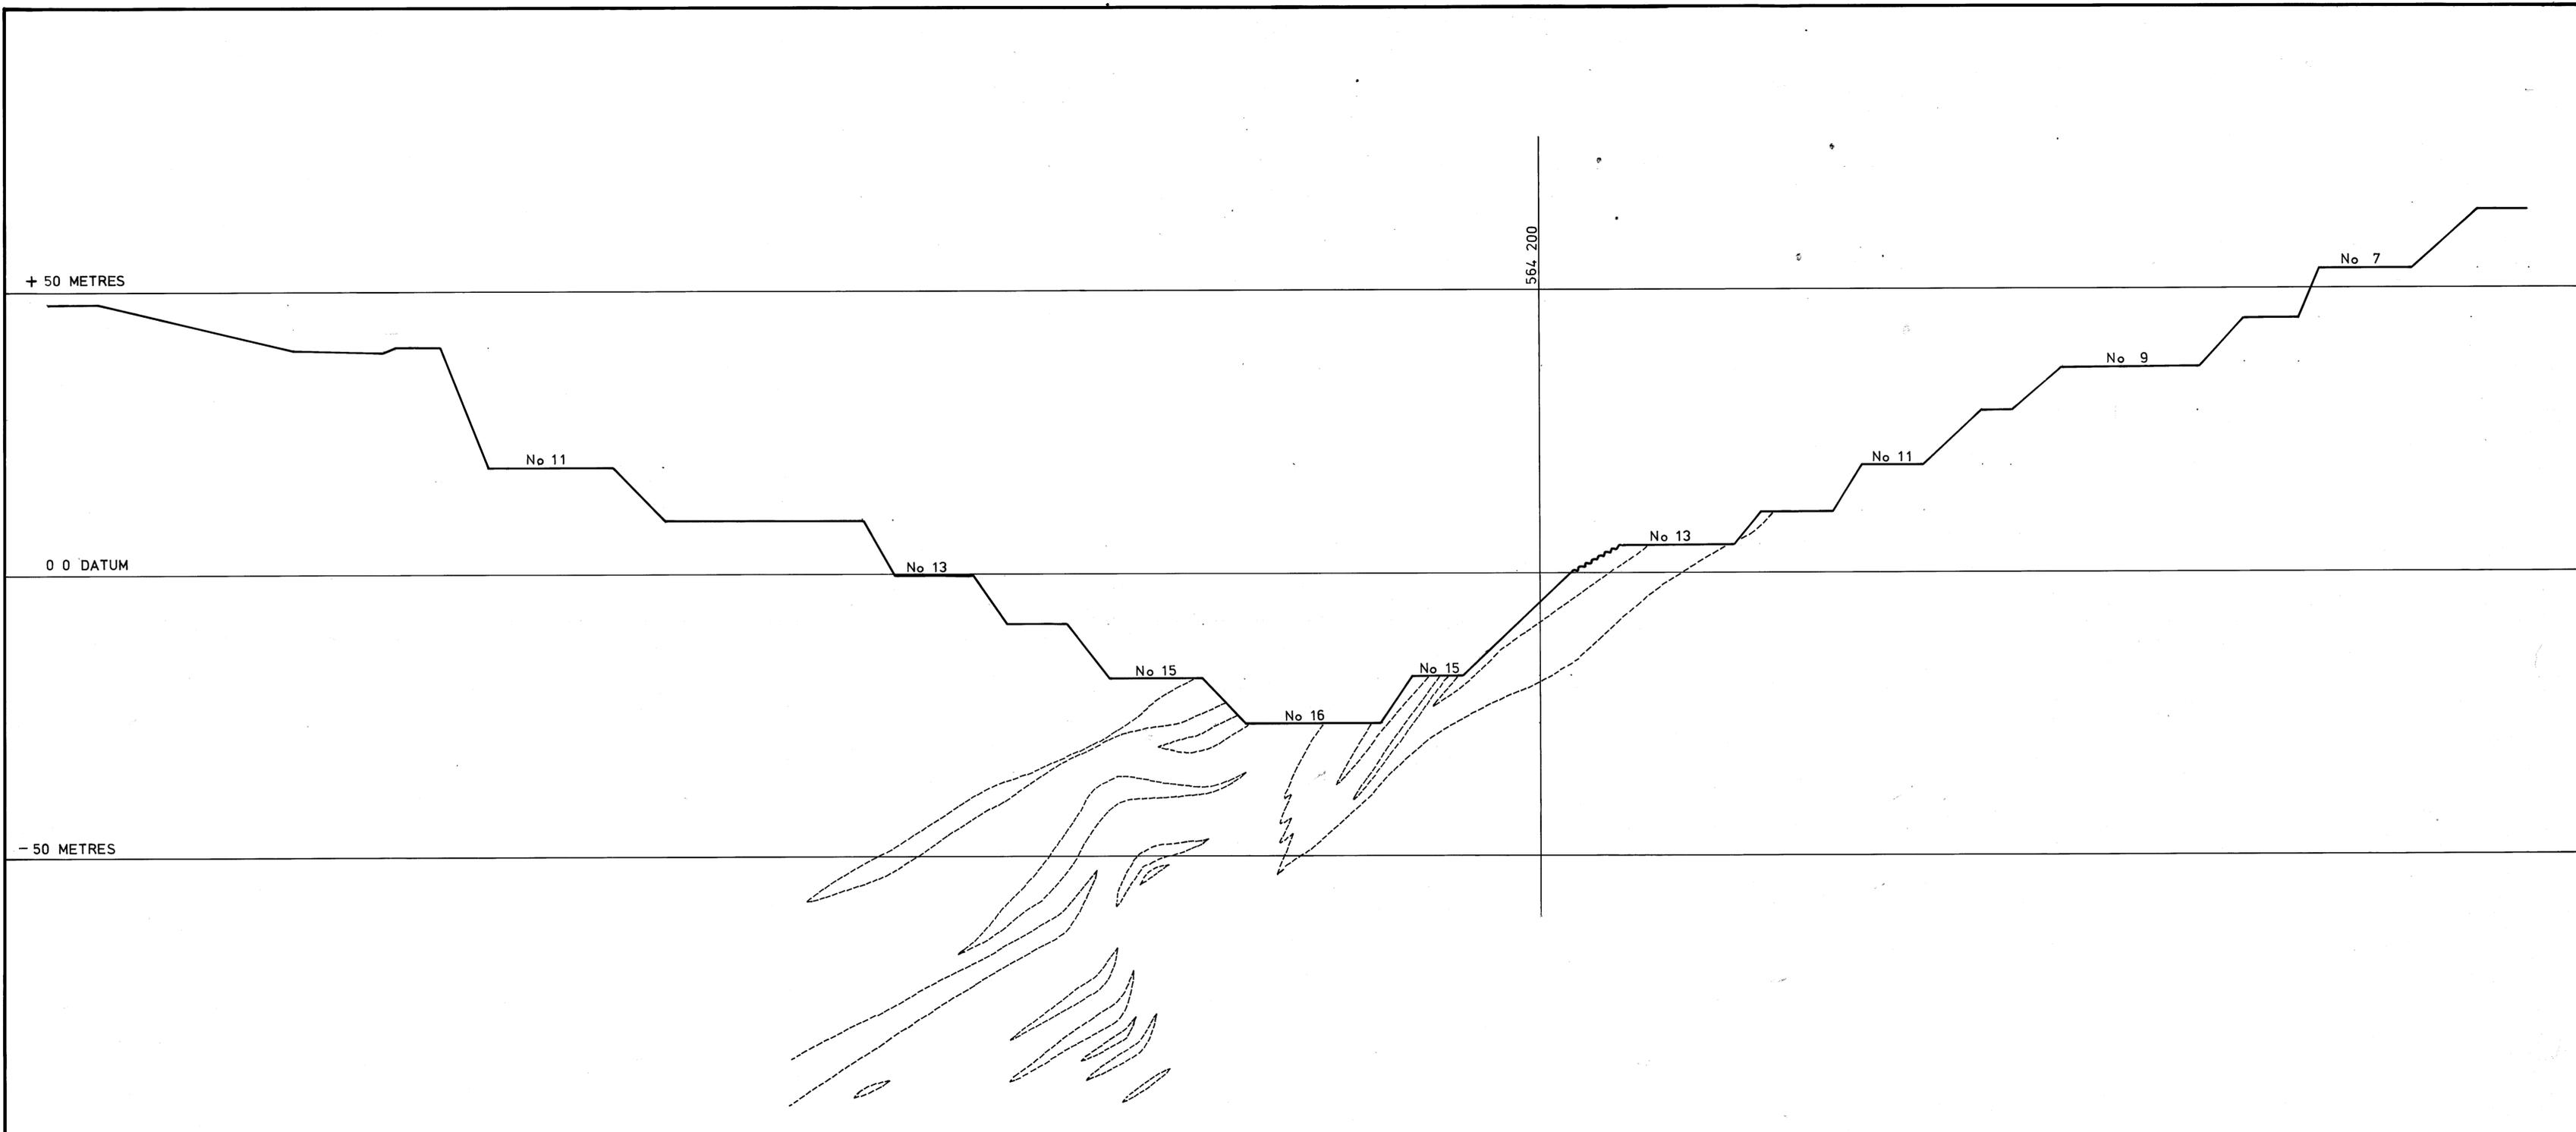

 DATE 21-1-72 SURVEYED DRAWN Saville TRACED CHECKED	KING ISLAND SCHEELITE LTD.	
	SCALE 1: 500.	
	OPEN CUT	
	SECTION 10	
	PERIOD 7	

1-13-51

50