


5 cm

ROLL 50
ID. 2335

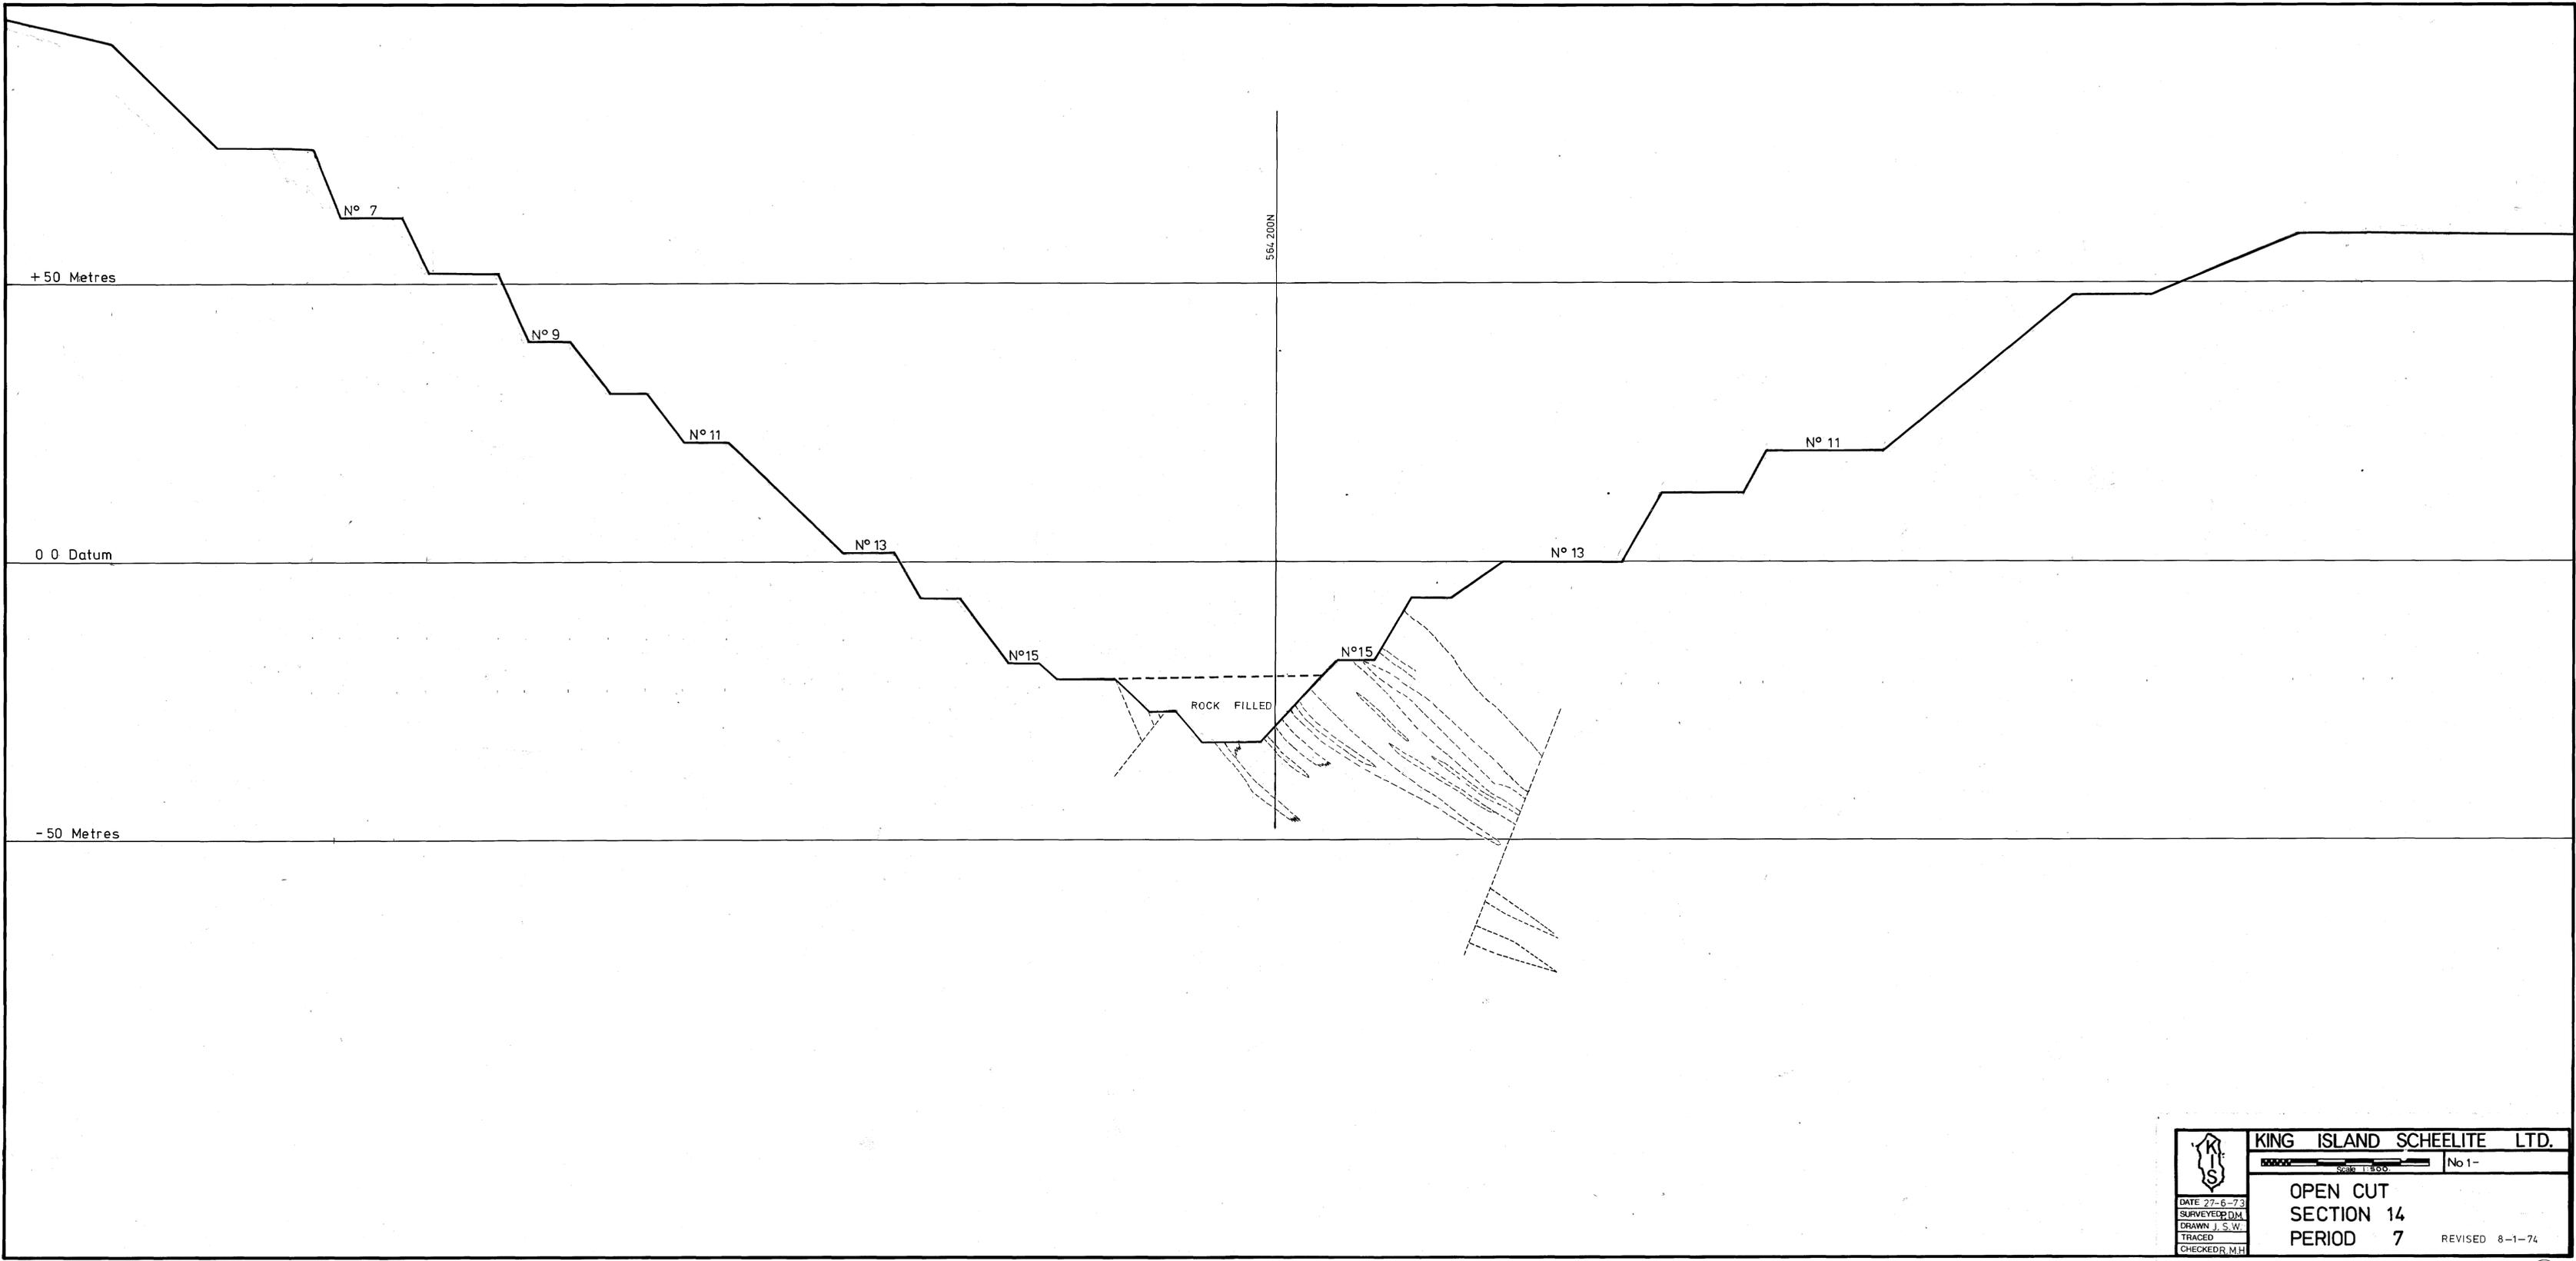

	KING ISLAND SCHEELITE LTD.	
		No 1-
	OPEN CUT SECTION 14	
	PERIOD 7	<small>REVISED 8-1-74</small>
<small>DATE 27-6-73</small> <small>SURVEYED DM</small> <small>DRAWN J. S. W.</small> <small>TRACED</small> <small>CHECKED R. M. H.</small>		

50