


5 cm

ID. 2337

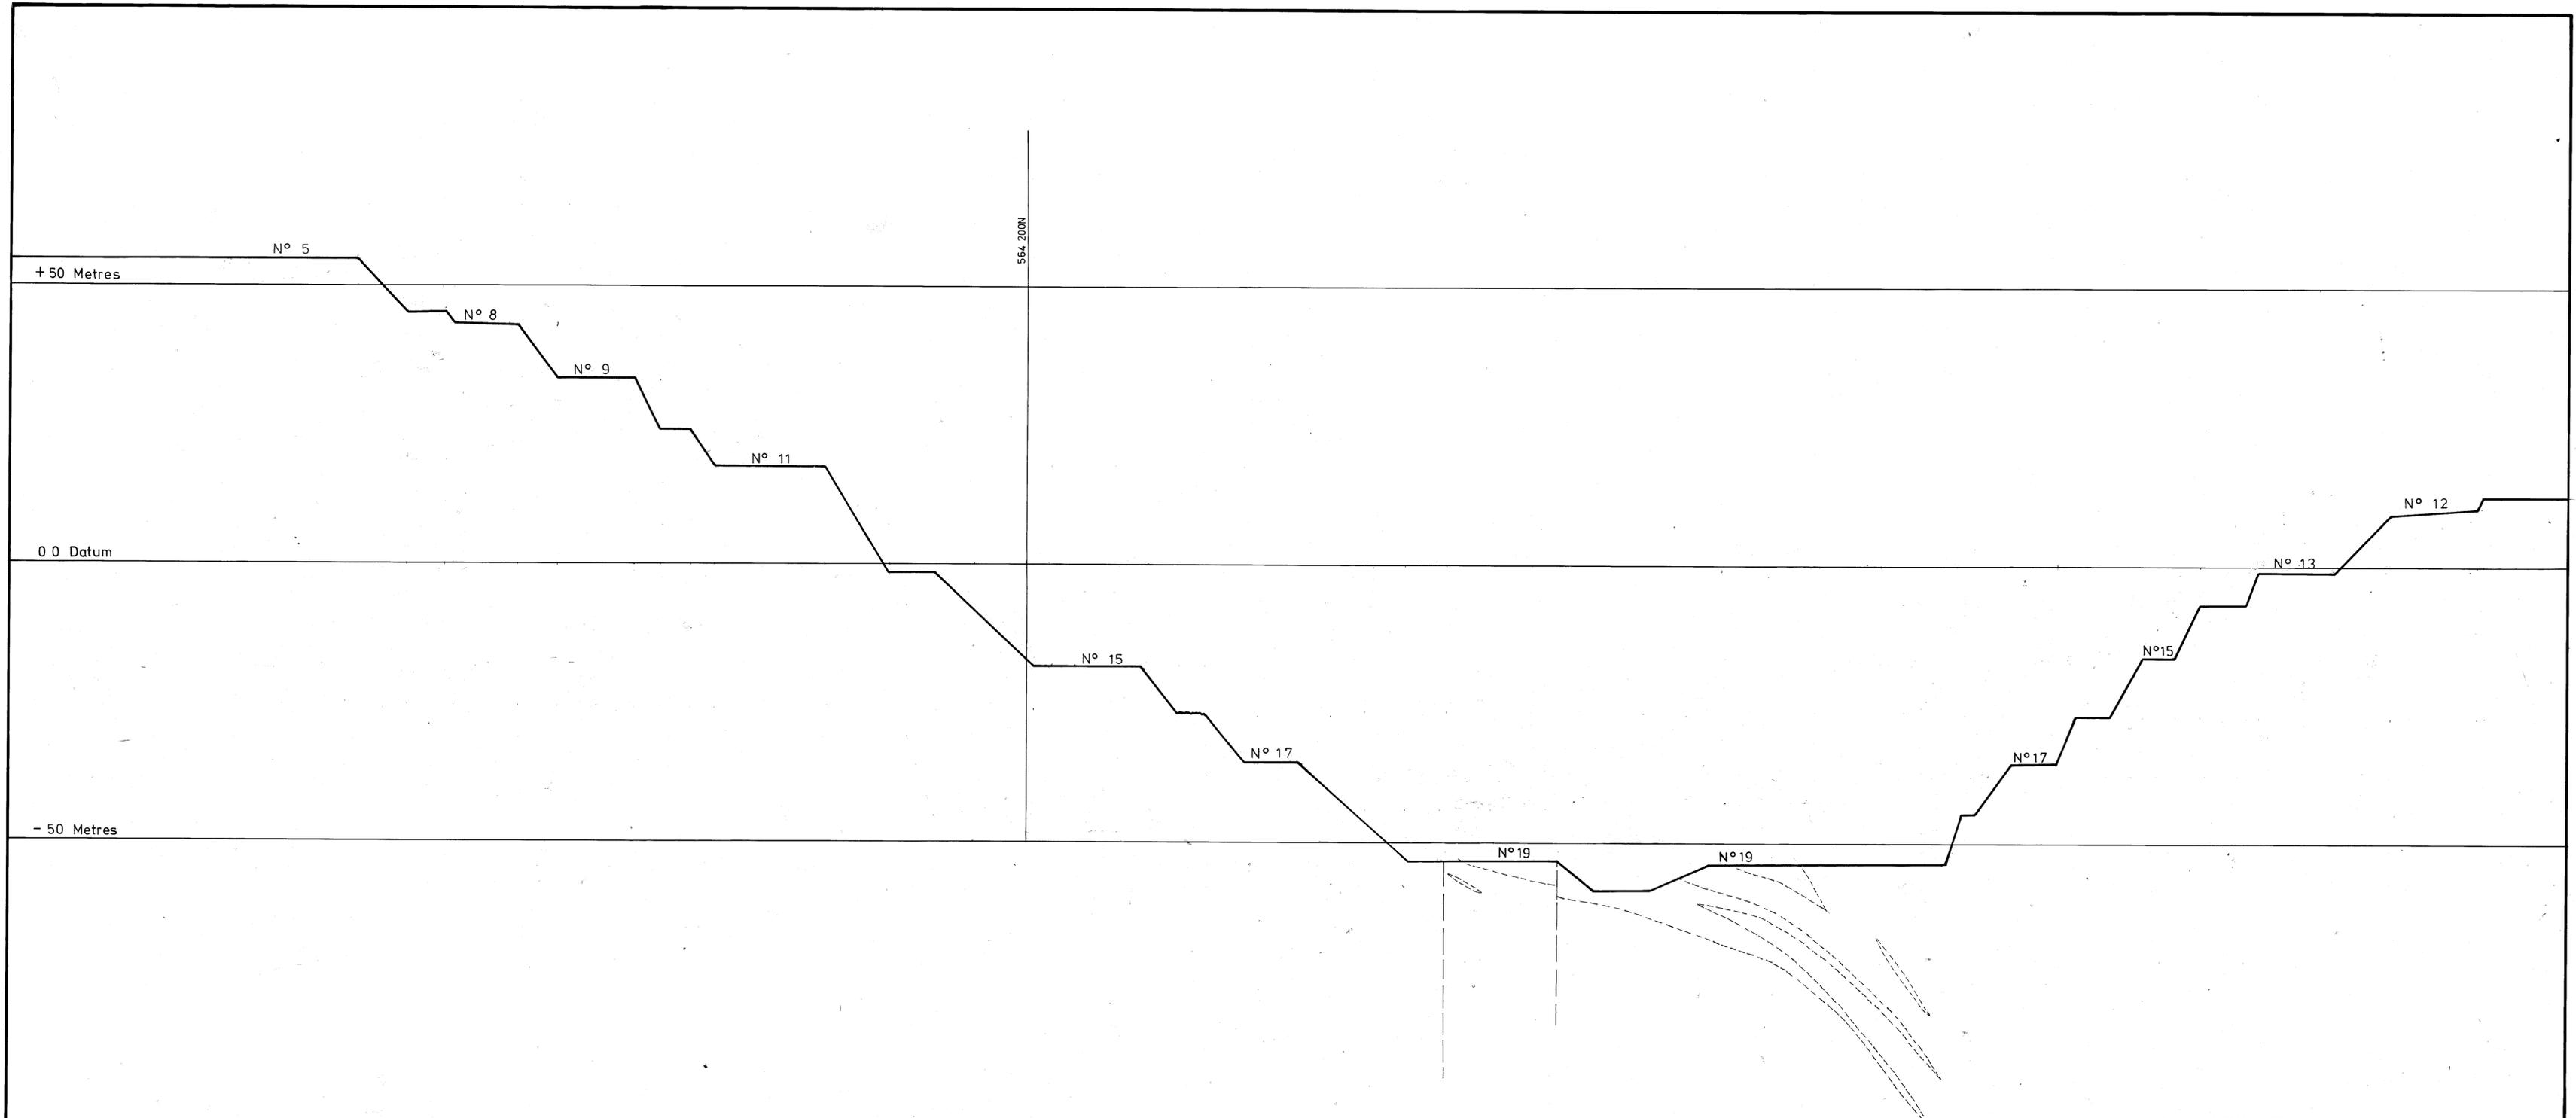

 DATE 27-6-73 SURVEYED P.D.M. DRAWN J.S.W. TRACED CHECKED R.M.H.	KING ISLAND SCHEELITE LTD.	
	No 1-	
	OPEN CUT	
	SECTION 6	
	PERIOD 7	REVISED 8-1-74