


LINE 11
SCALE 1 in = 50 ft
FROM QC-70 AS OF 15.12.70

5 m

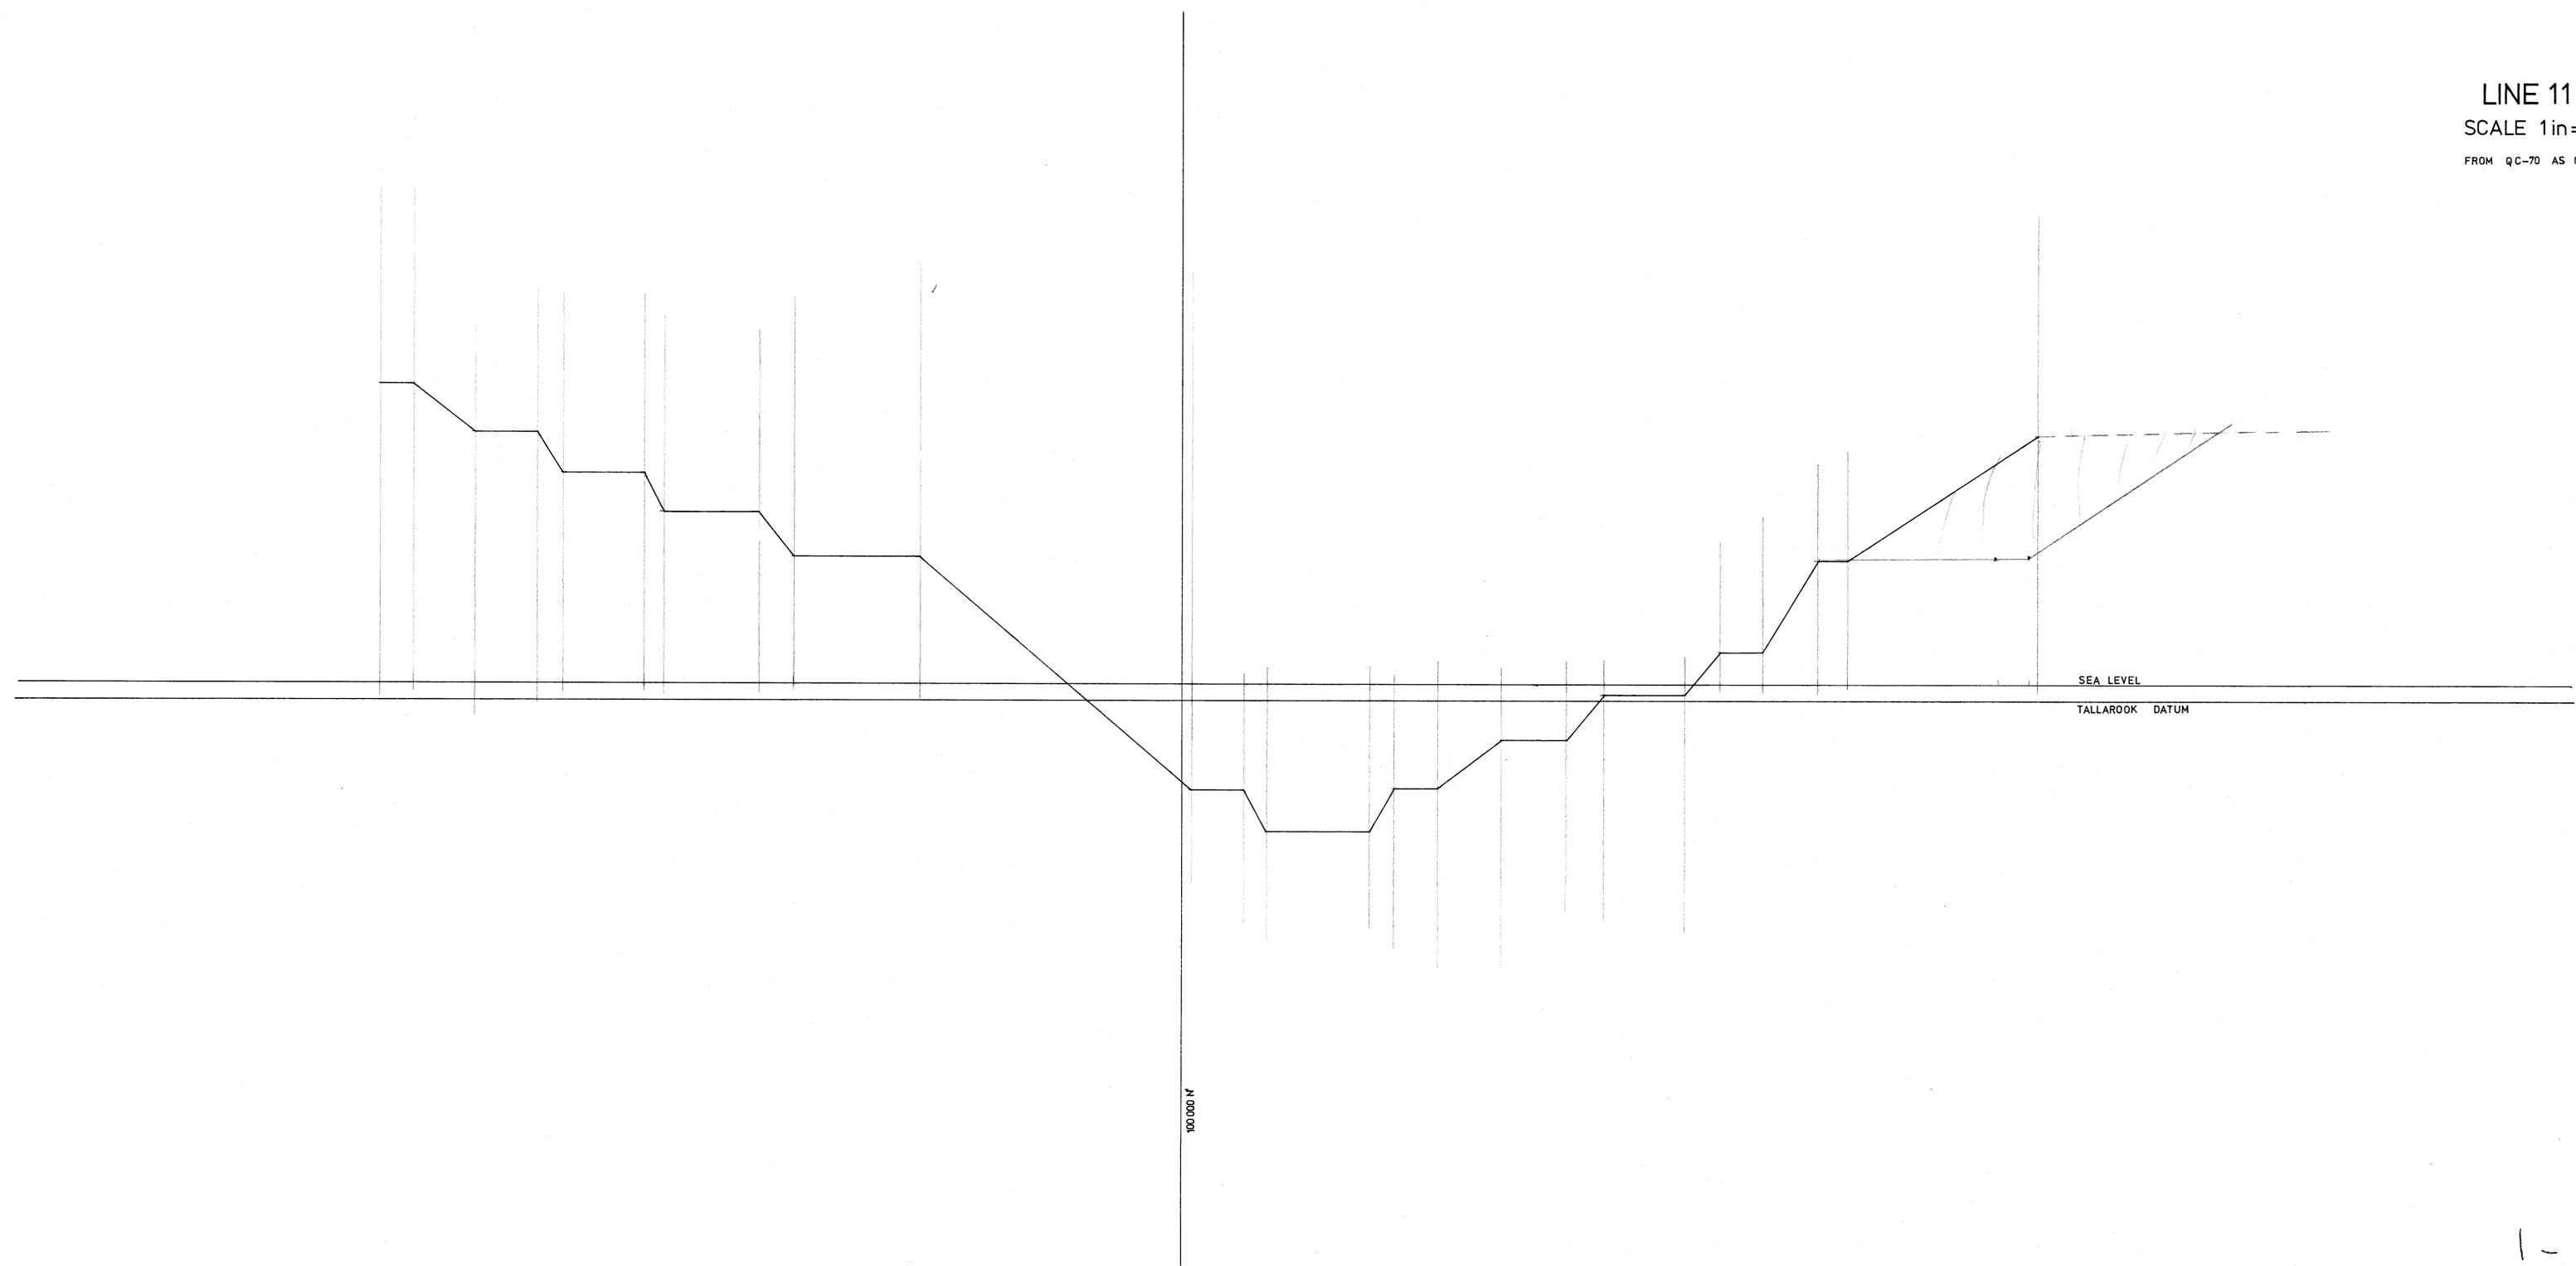

100 000 N

Roll 50
ID. 234-7

1-13-19