


LINE 13  
SCALE 1in=50ft  
FROM QC 70 AS OF 15.12.70

5m

Roll 50  
ID 2349

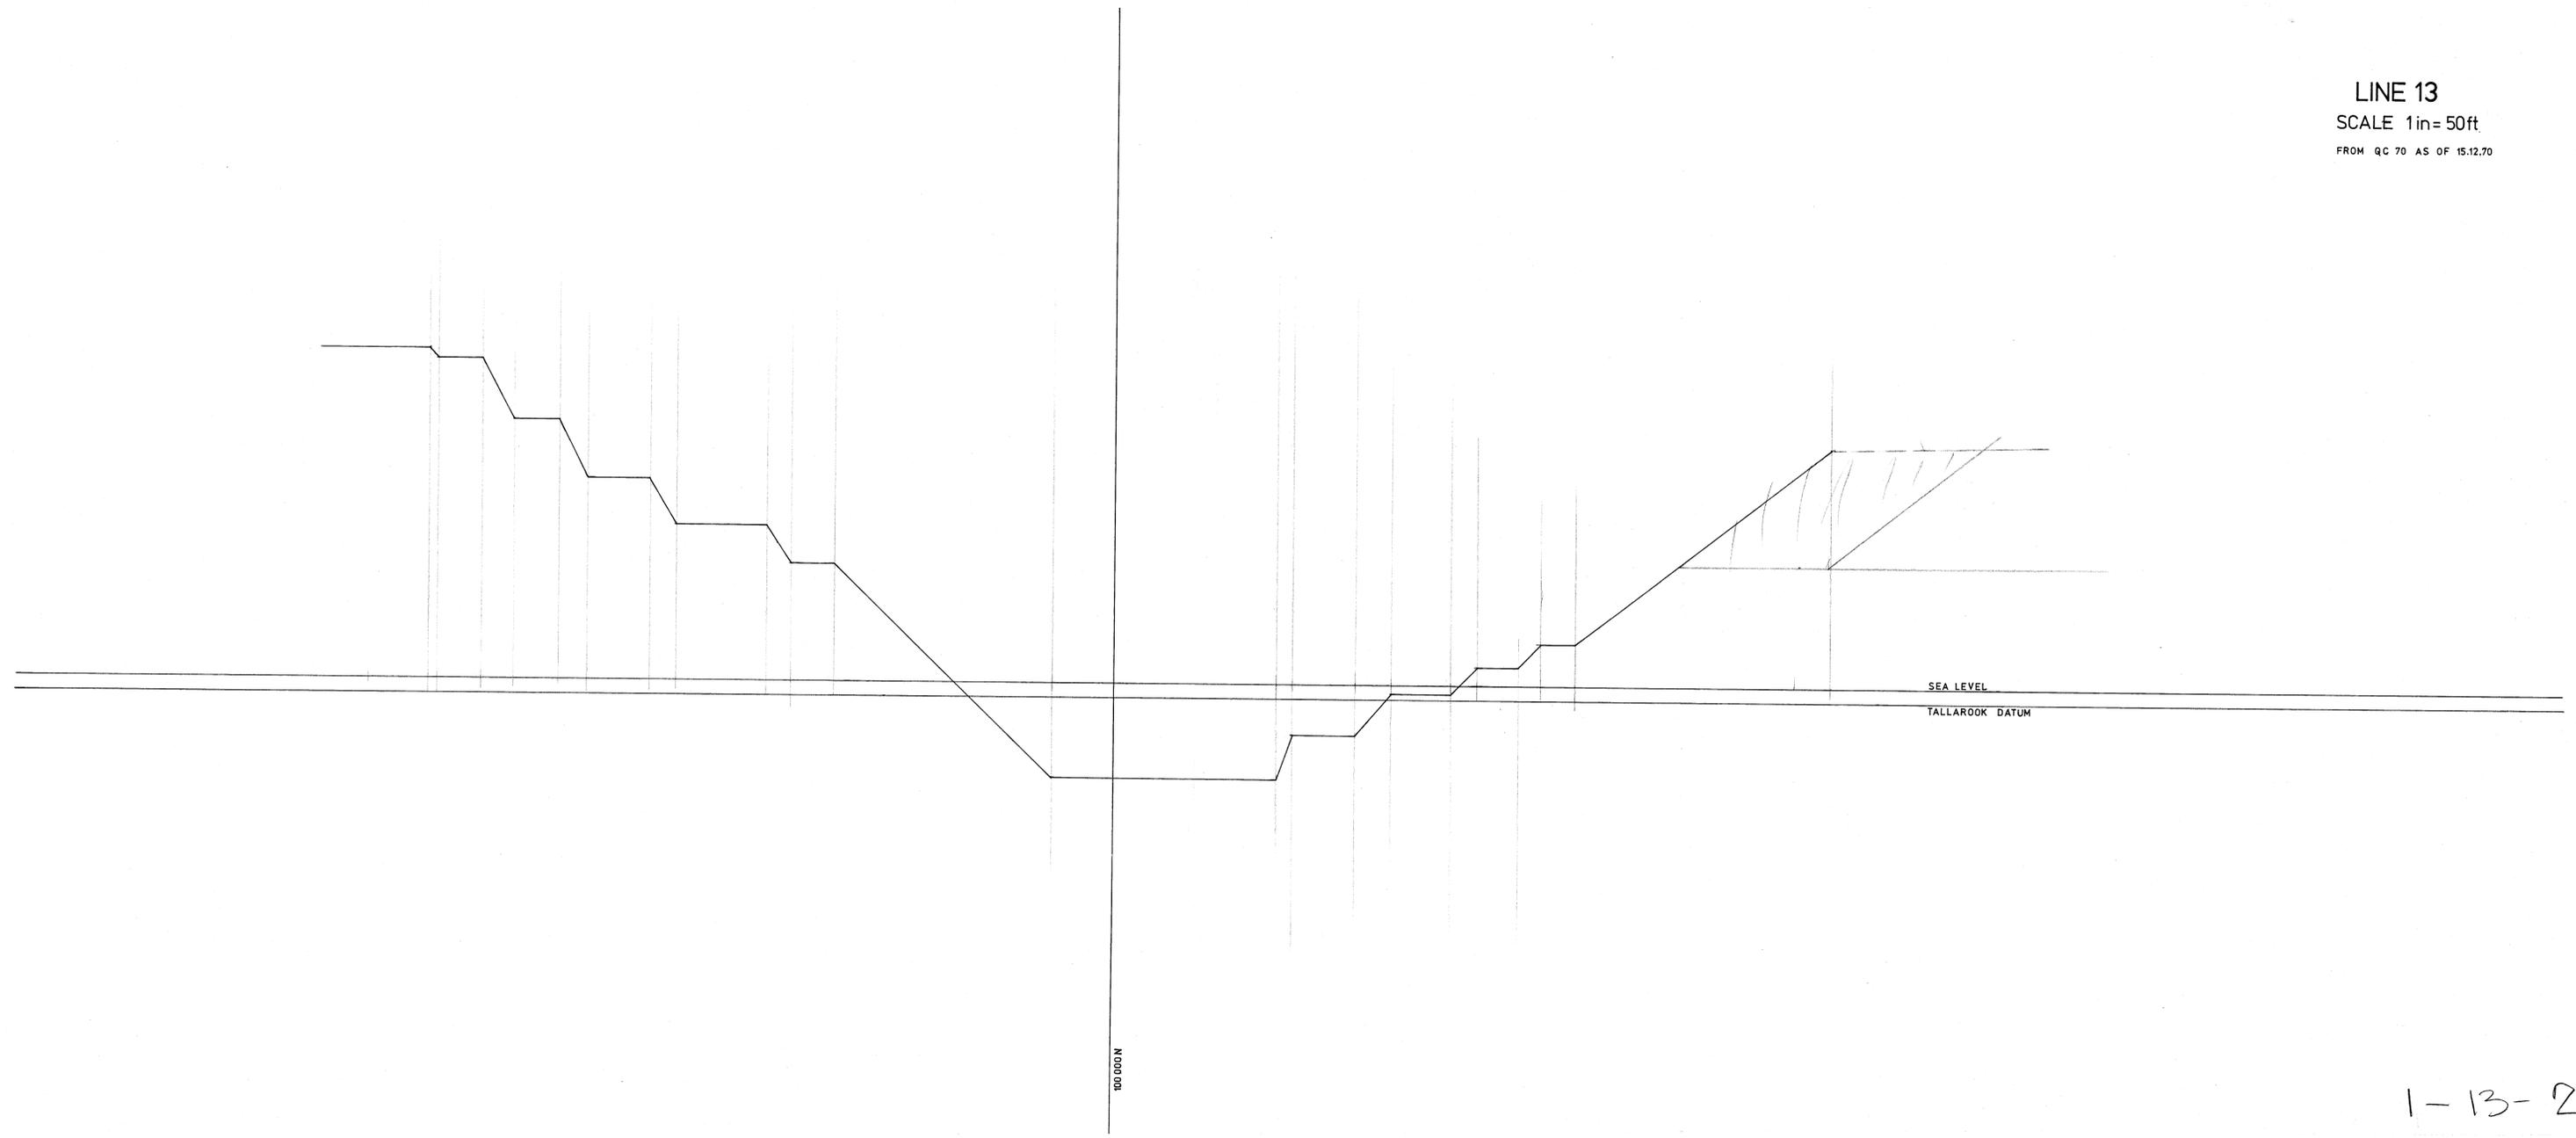

1-13-21