


04AL28 - 1002

0374 - 2000

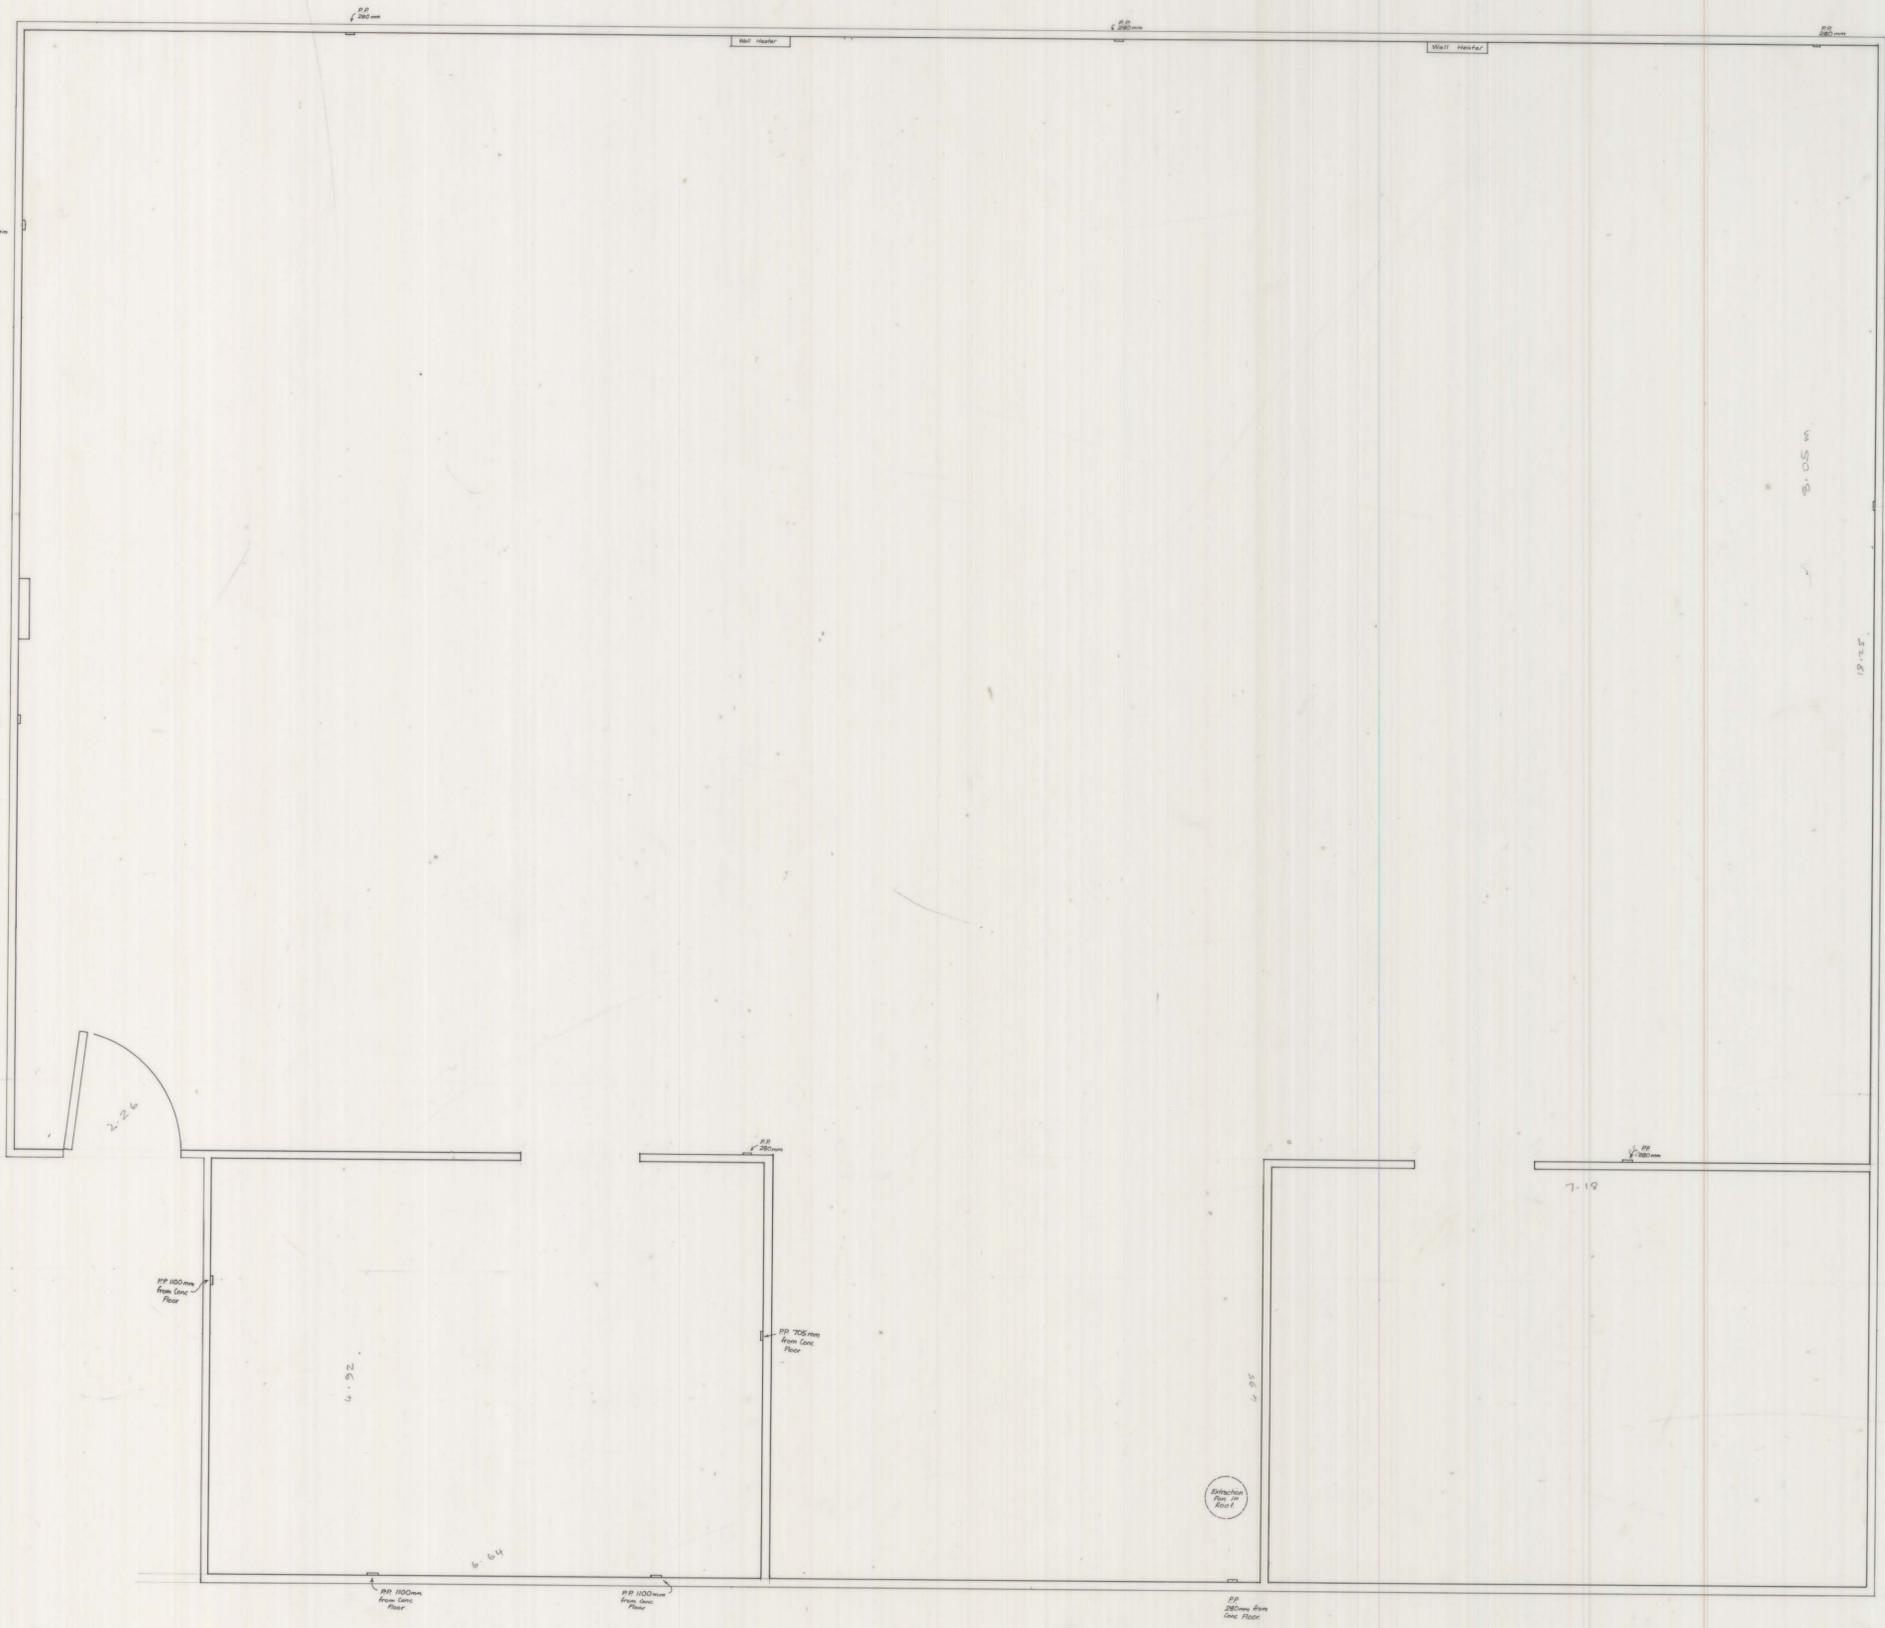

SCALE 1:25

LOCATION
NEW ADMINISTRATION BUILDING

SUBJECT
U.T.S
OFFICE WALL PLAN

north

KIS KING ISLAND SCHEELITE
A DIVISION OF WARMAN INTERNATIONAL

GRASSY KING ISLAND

PLAN NUMBER
04AL28 - 1002