


0374-2015

5 cm

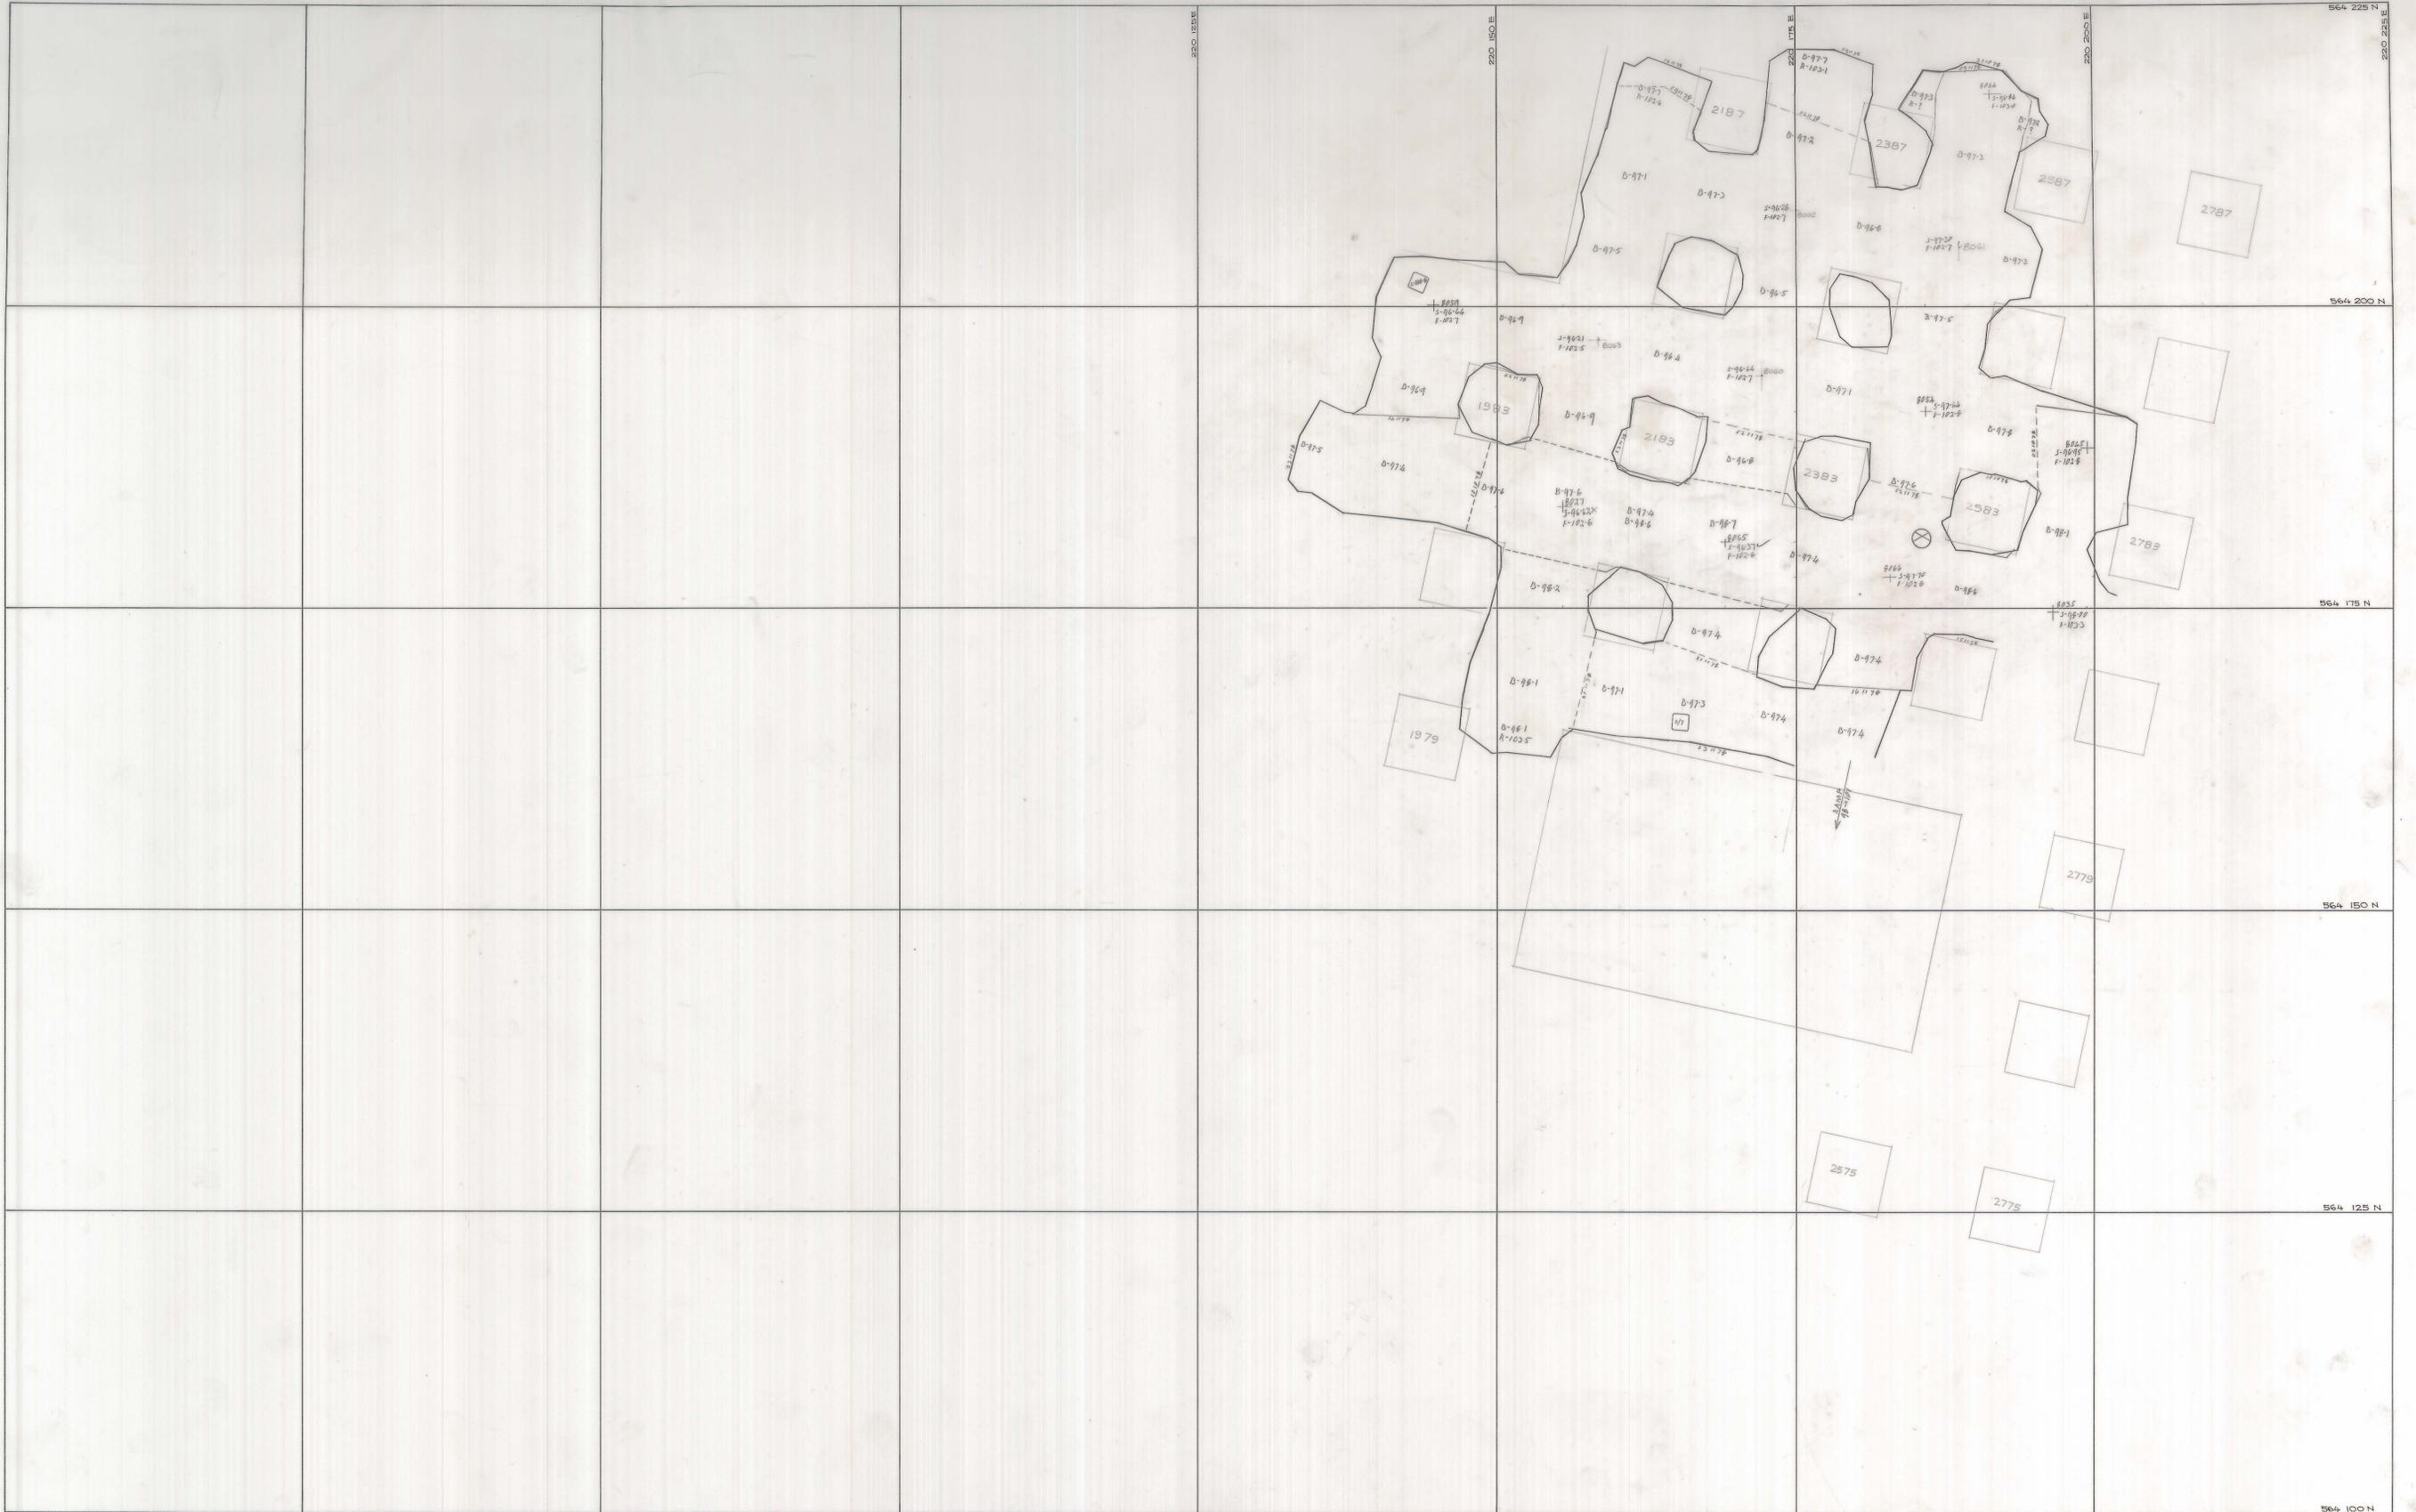

SCALE 1:250

LOCATION DOLPHIN MINE

SUBJECT C WEDGE STOPE
- 101 m CONTOUR

north

KIS KING ISLAND SCHEELITE
A DIVISION OF WARMAN INTERNATIONAL

GRASSY KING ISLAND

PLAN NUMBER 04DM13 - 1014