


27 JUN 1981

04DM13-1001

C WEDGE

0374_2024

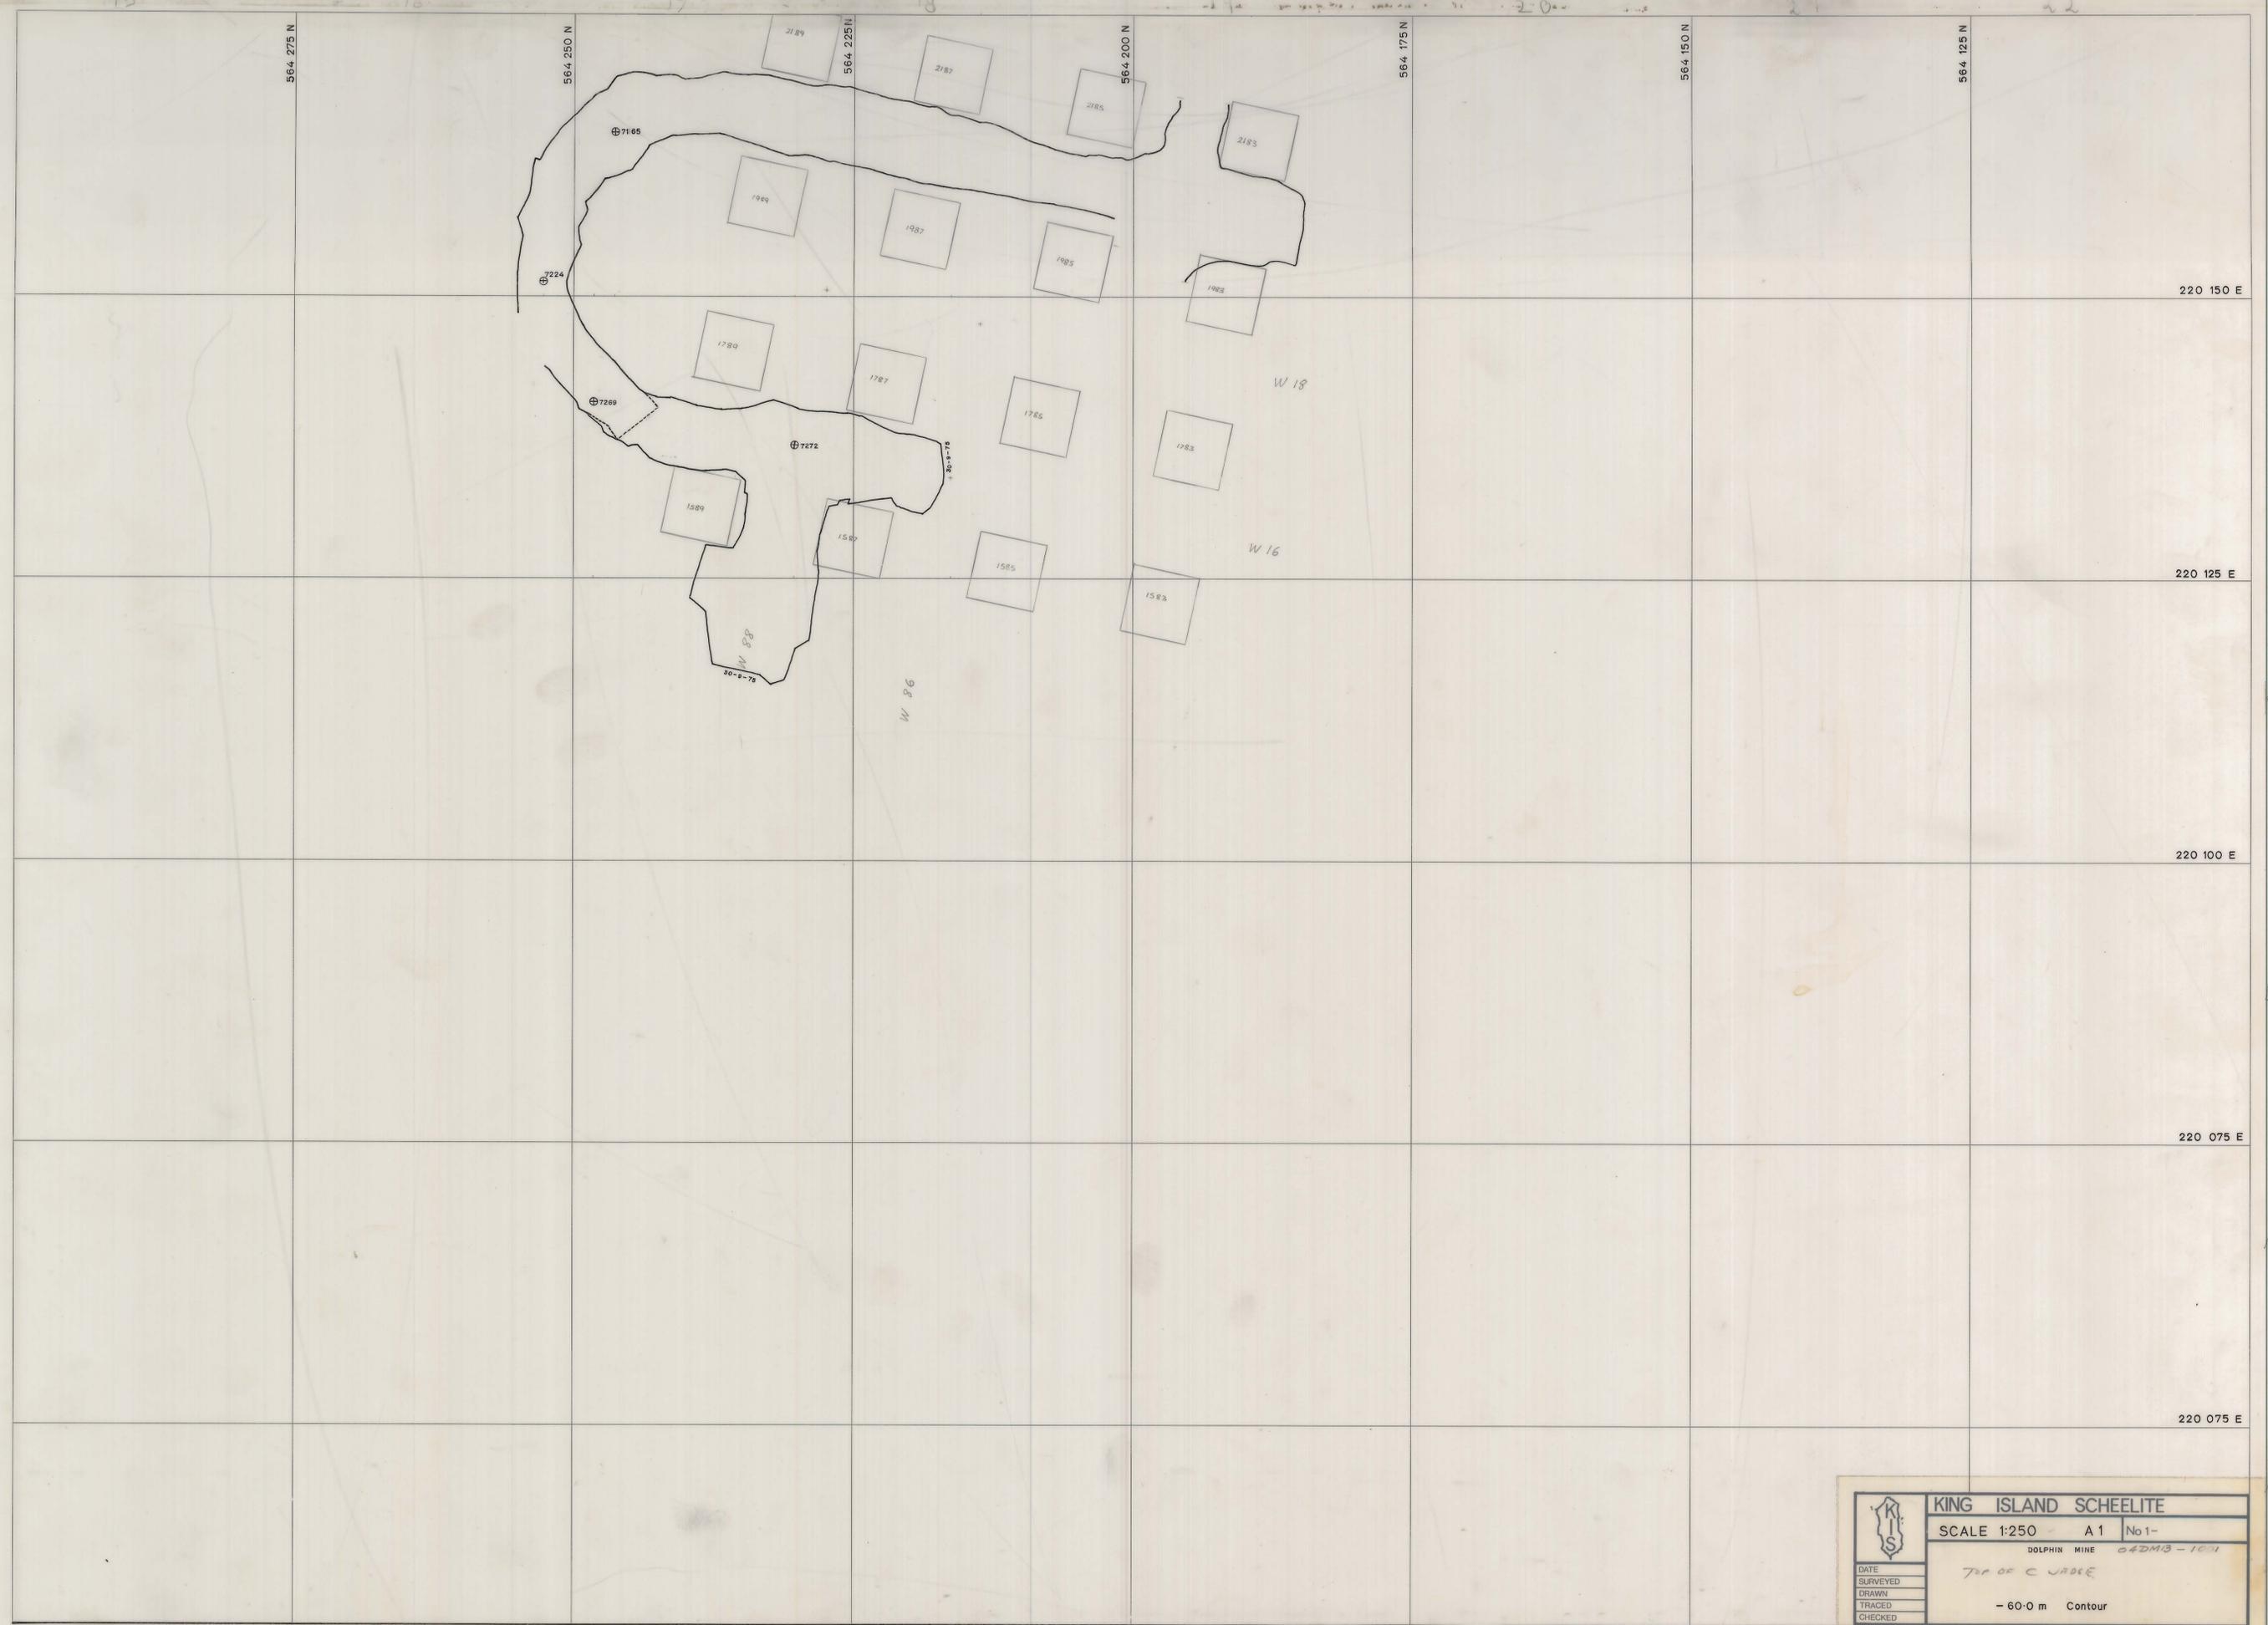

	KING ISLAND SCHEELITE	
	SCALE 1:250	A 1 No 1-
	DOLPHIN MINE 04DM13-1001	
	TOP OF C WEDGE	
DATE _____ SURVEYED _____ DRAWN _____ TRACED _____ CHECKED _____	- 60.0 m Contour M-23 9-77	