



5 cm

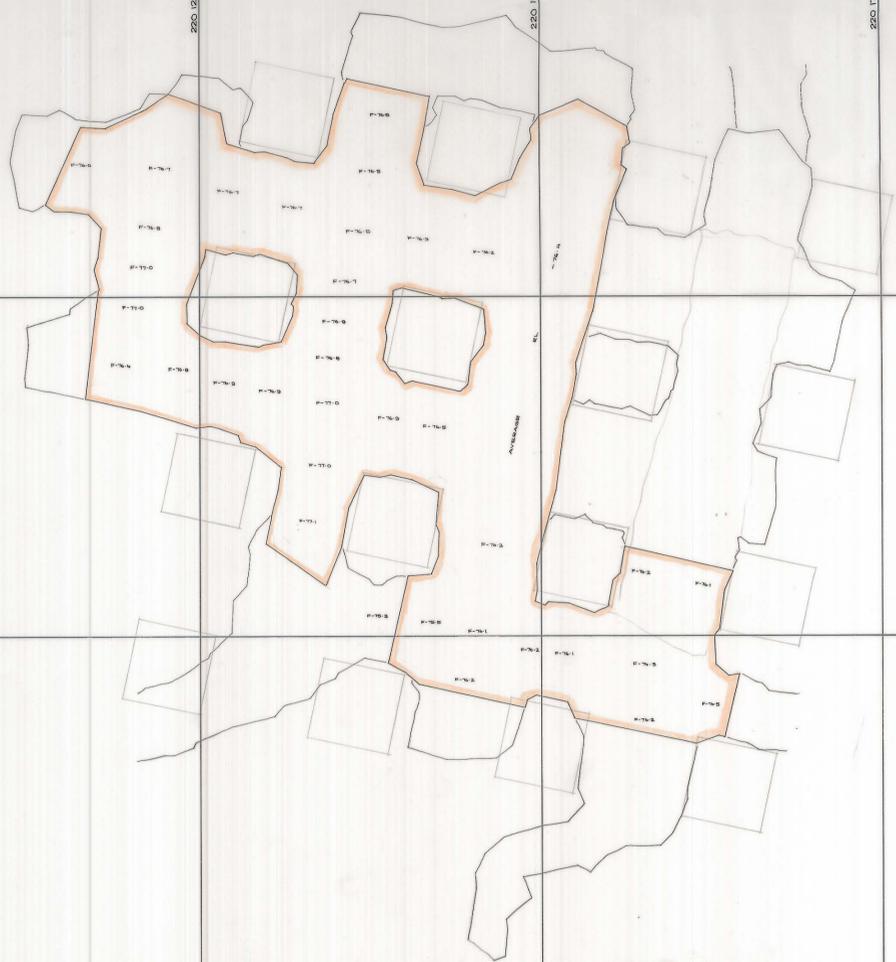

SCALE 1:250

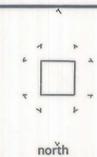

LOCATION DOLPHIN MINE

SUBJECT

WEDGE STOPE  
- 75 m BENCHING

**KIS** KING ISLAND SCHEELITE  
A DIVISION OF WARMAN INTERNATIONAL

GRASSY KING ISLAND

PLAN NUMBER 04DM13 - 1006