




0374-2030

04DM13-1011

C WEDGE STOPE  
92

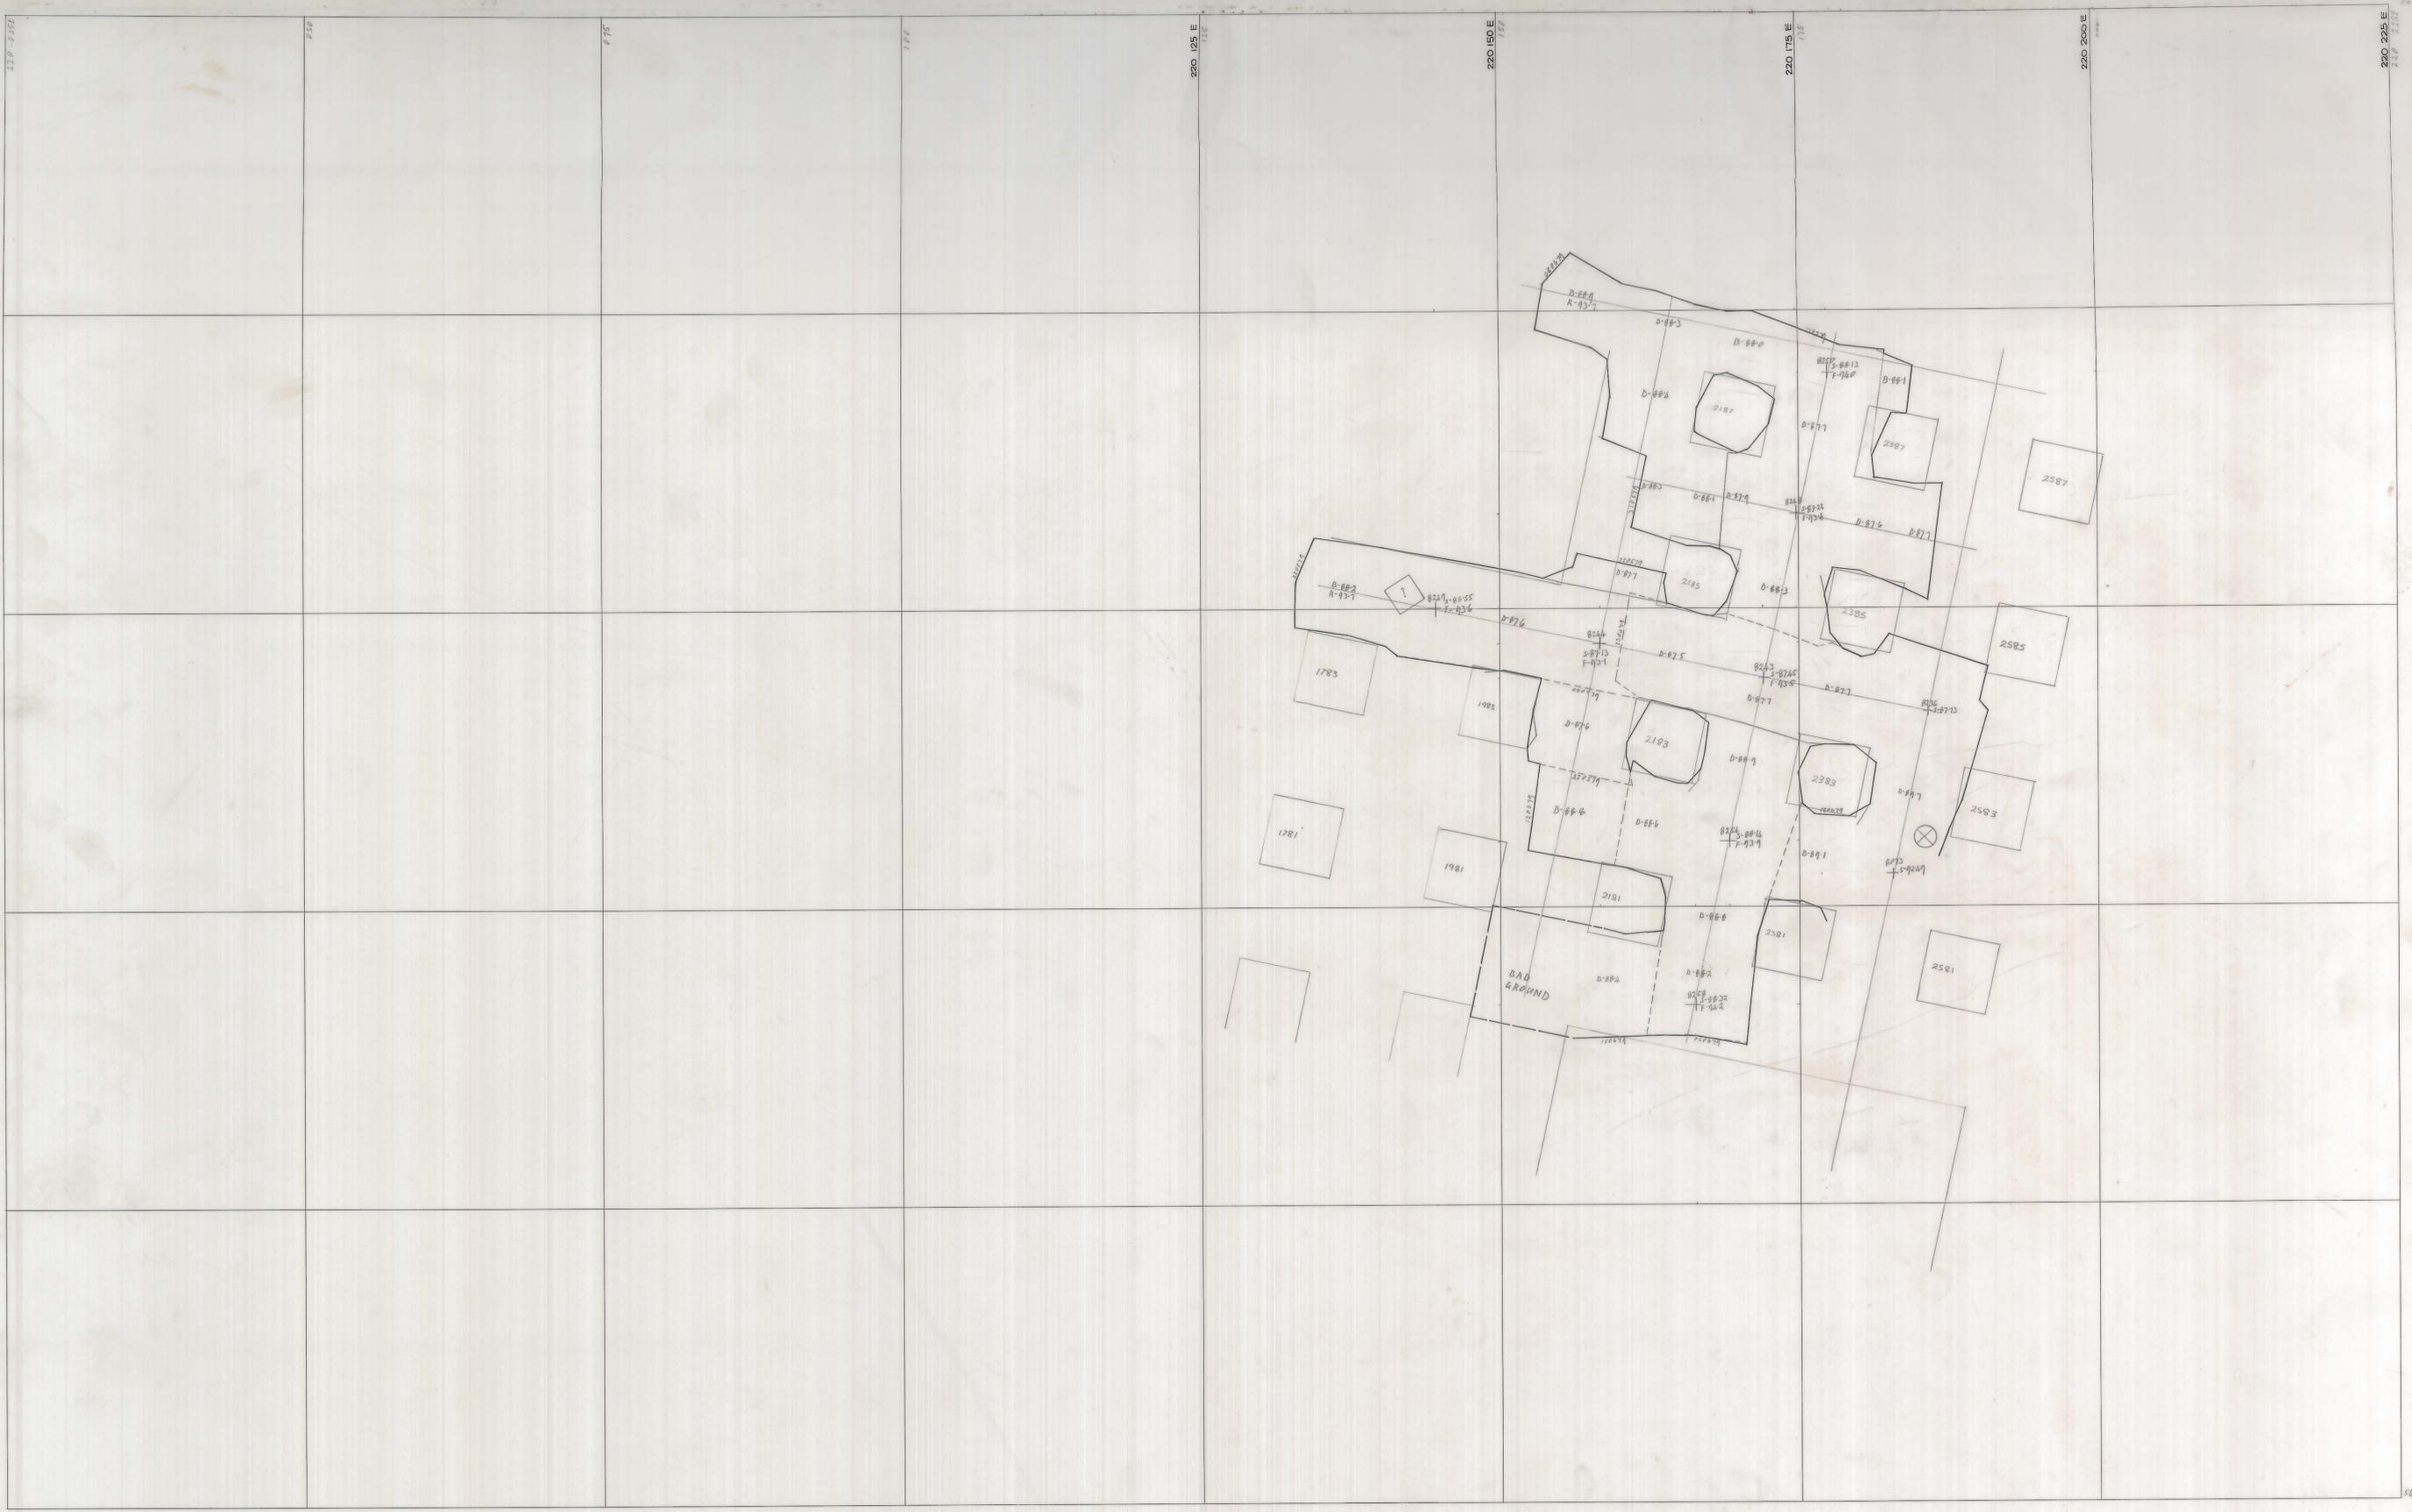

SCALE 1:250		LOCATION DOLPHIN MINE	
SUBJECT		SUBJECT	
north		C WEDGE STOPE -92 m CONTOUR	
		PLAN NUMBER 04DM13 - 1011	

