


Adjoins 1-22-54

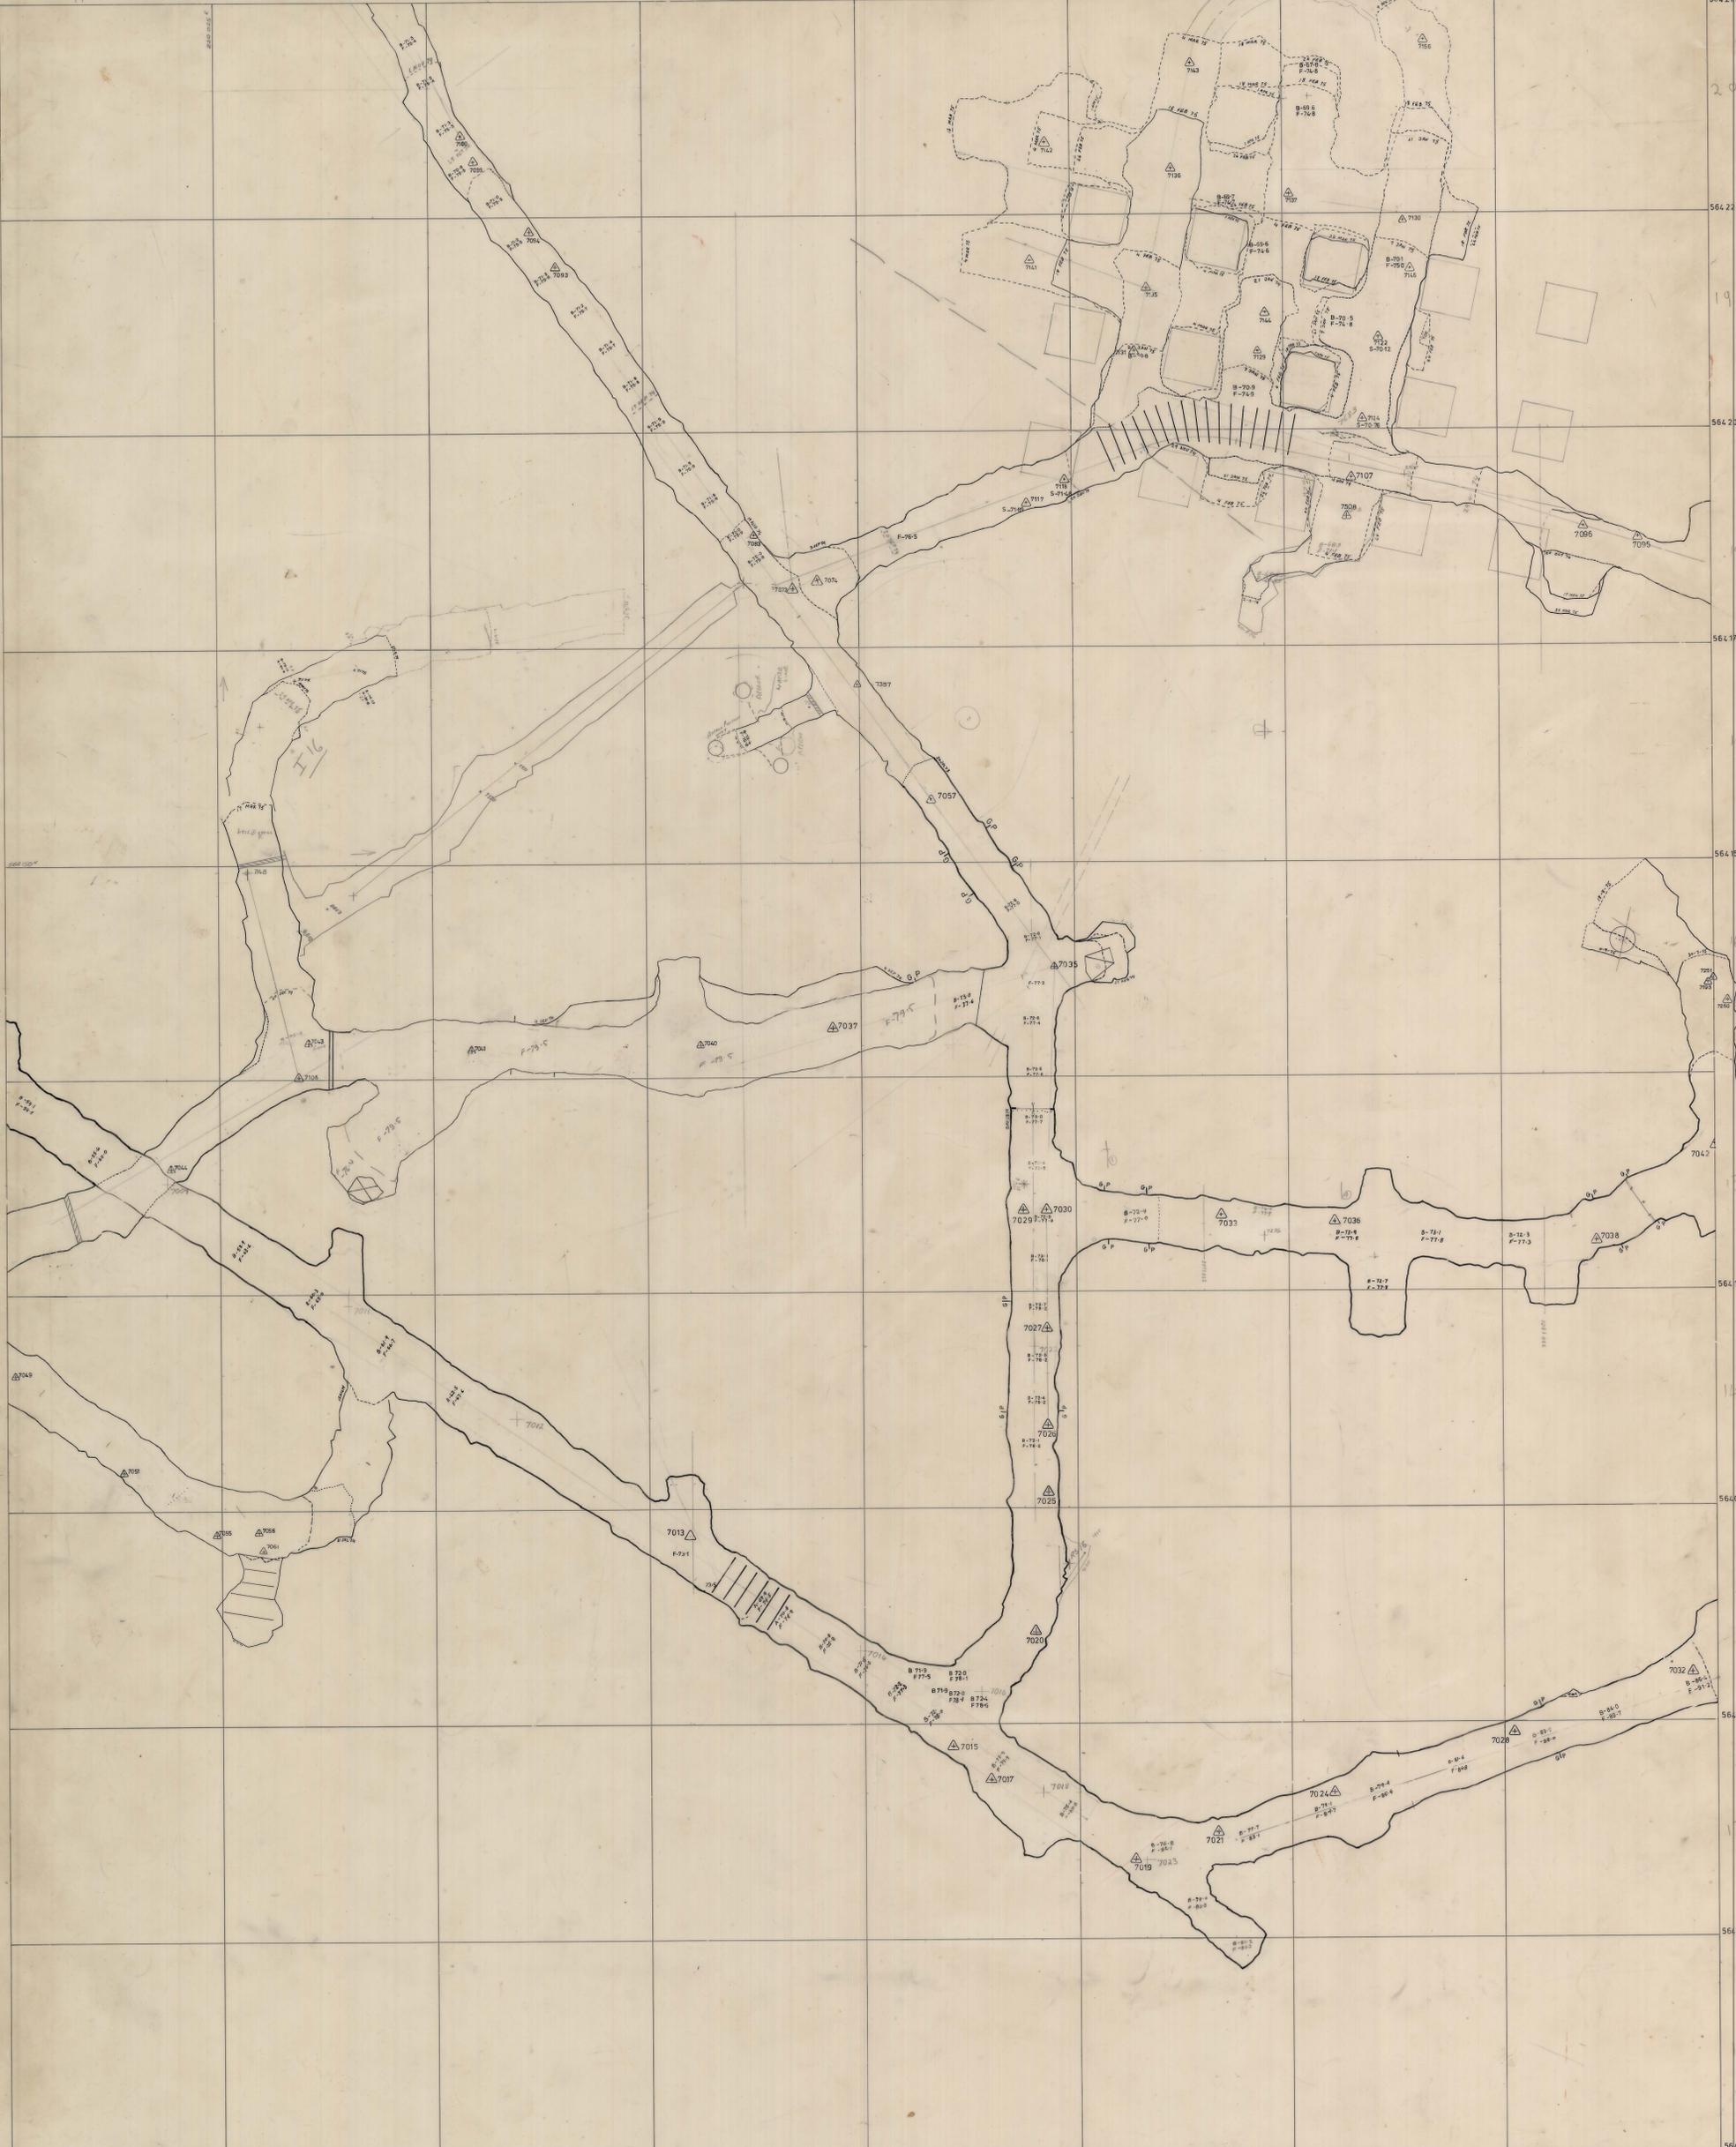

KING ISLAND SCHEELITE LTD.
DOLPHIN MINE

SCALE 1: 250

REVISED 2 - 5 - 75

1-22-12
04DM/E-0002