


5 cm

27 JUN 1981

04DM12-155 107  
H15 RAMP  
C CENTRAL STOPE ACCESS  
0374-2034

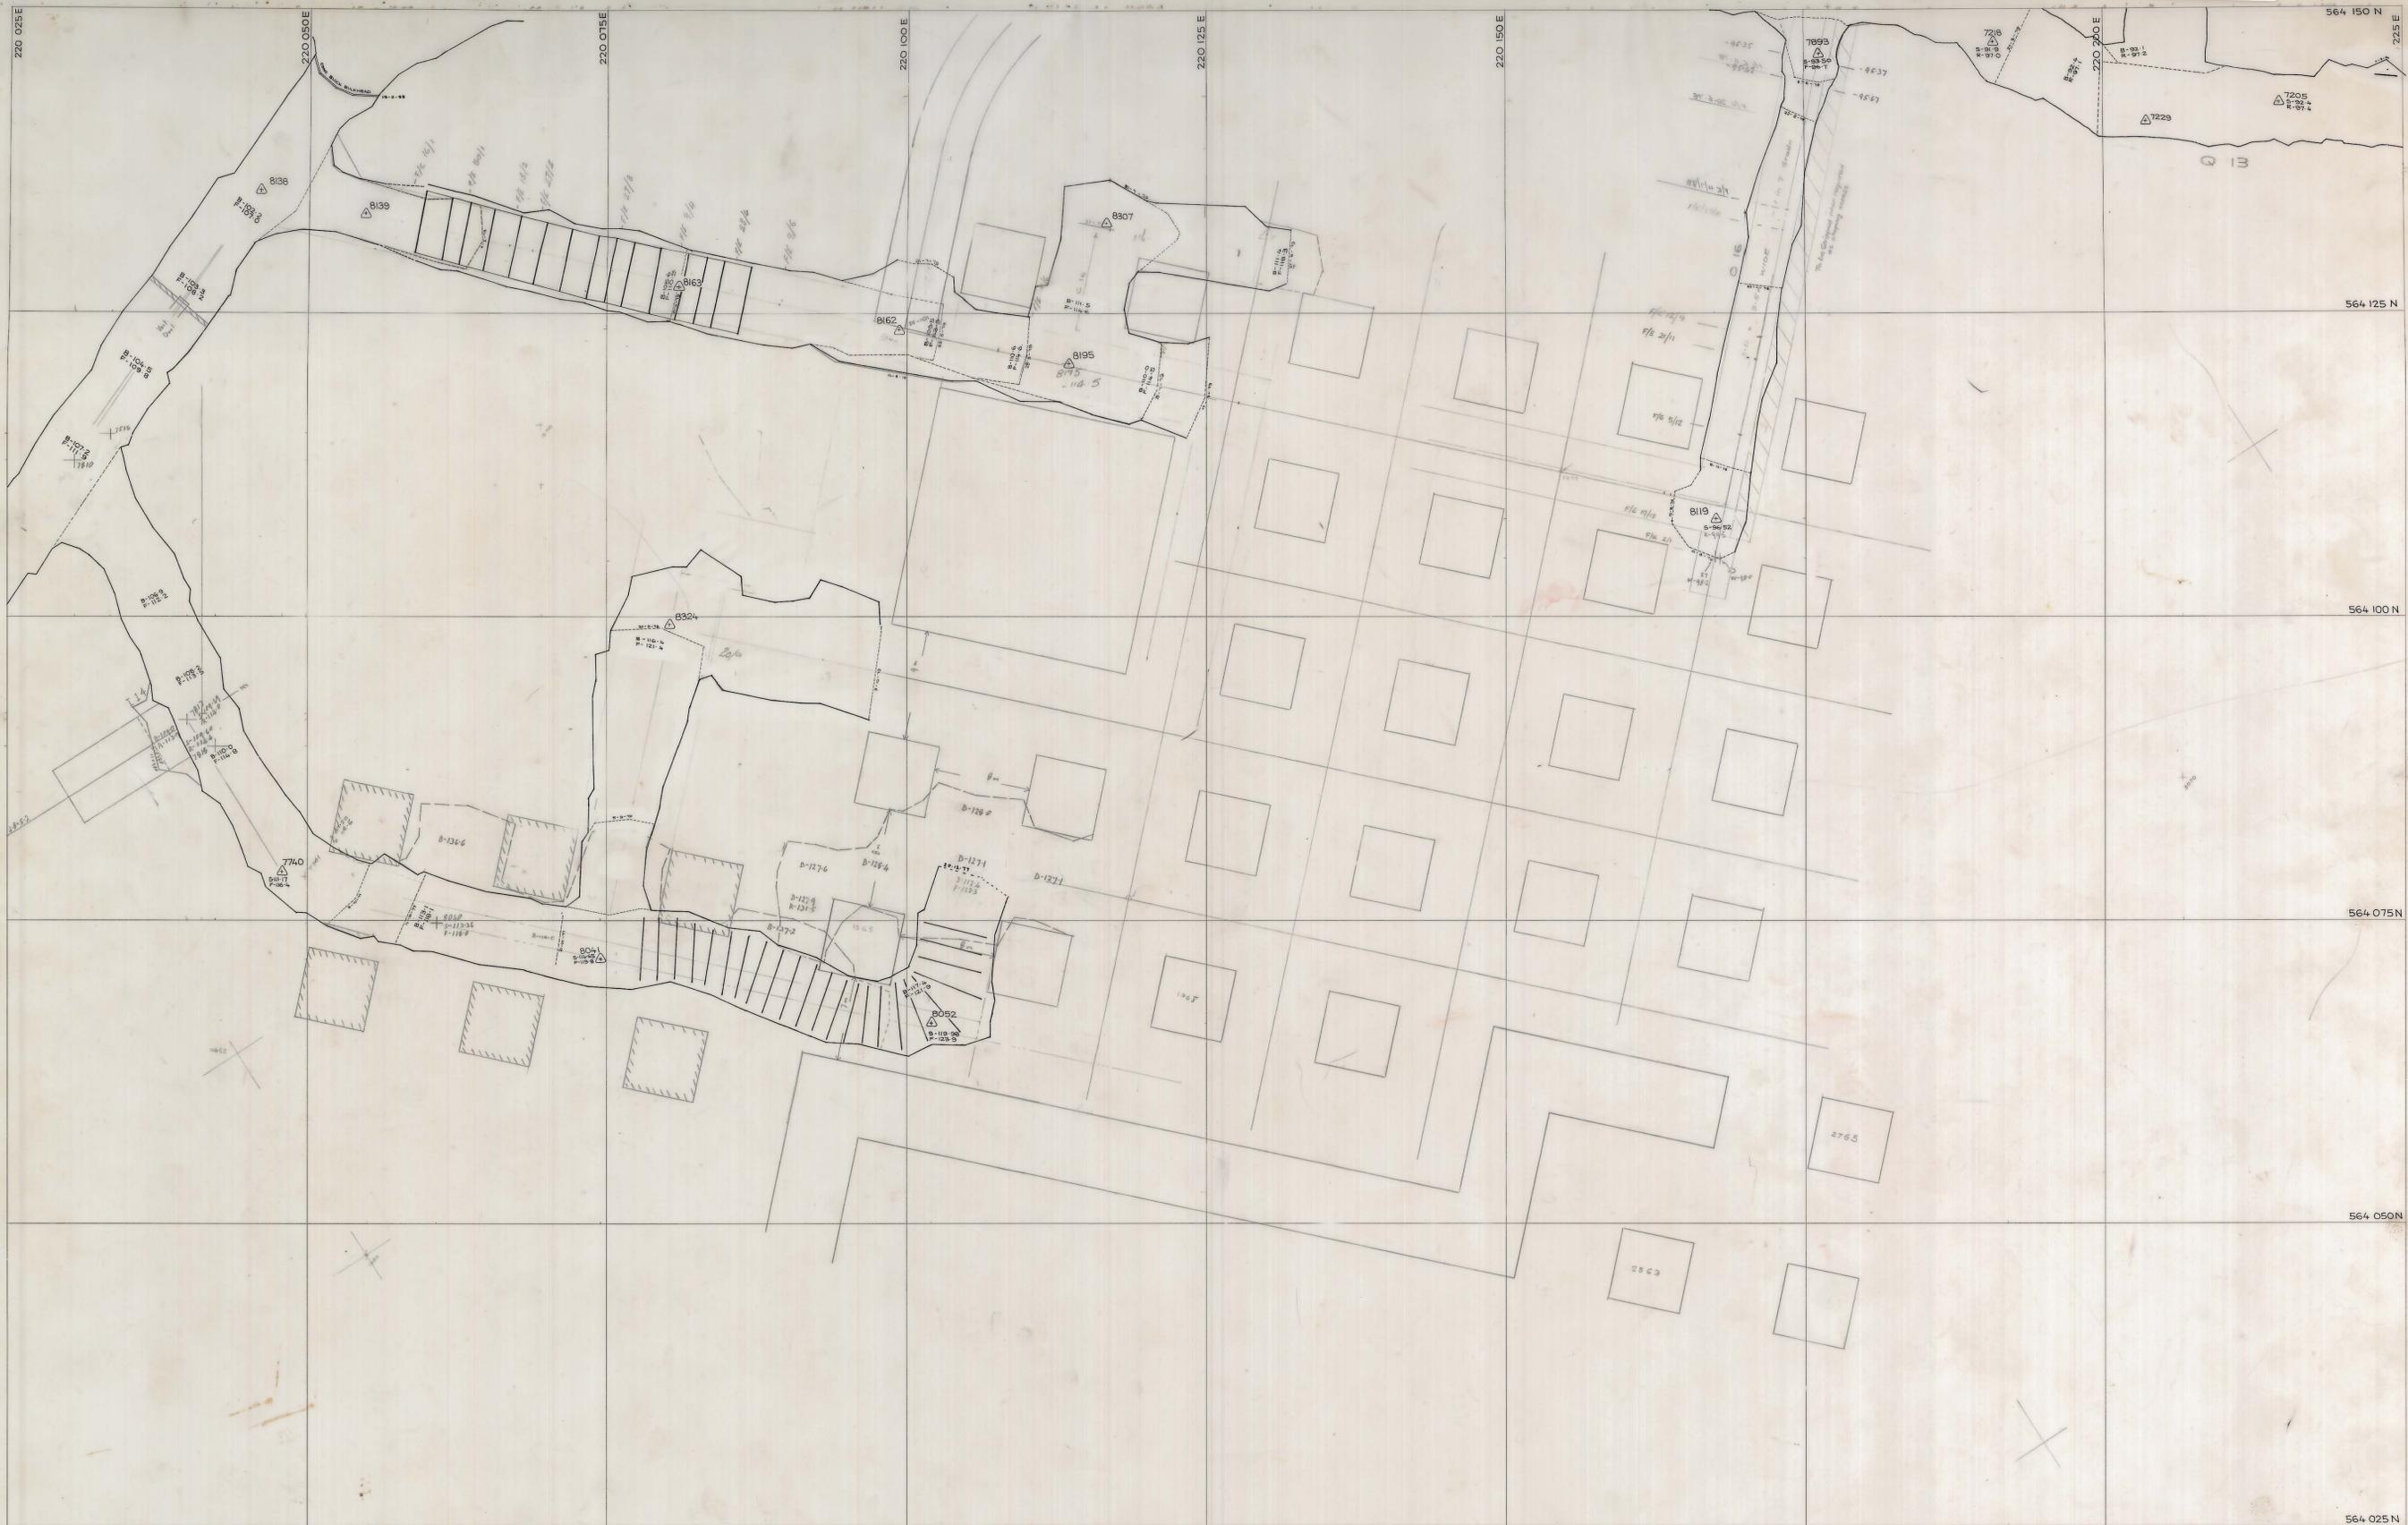

	SCALE 1:250	LOCATION DOLPHIN MINE SUBJECT H15 RAMP C CENTRAL STOPE ACCESS north	 <p>GRASSY KING ISLAND PLAN NUMBER 04DM12 - 155 107</p>
--	-------------	--	--