


5 cm

27 JUN 1981

O4DM12 - 155 092

-75m ZONE

0374-2037

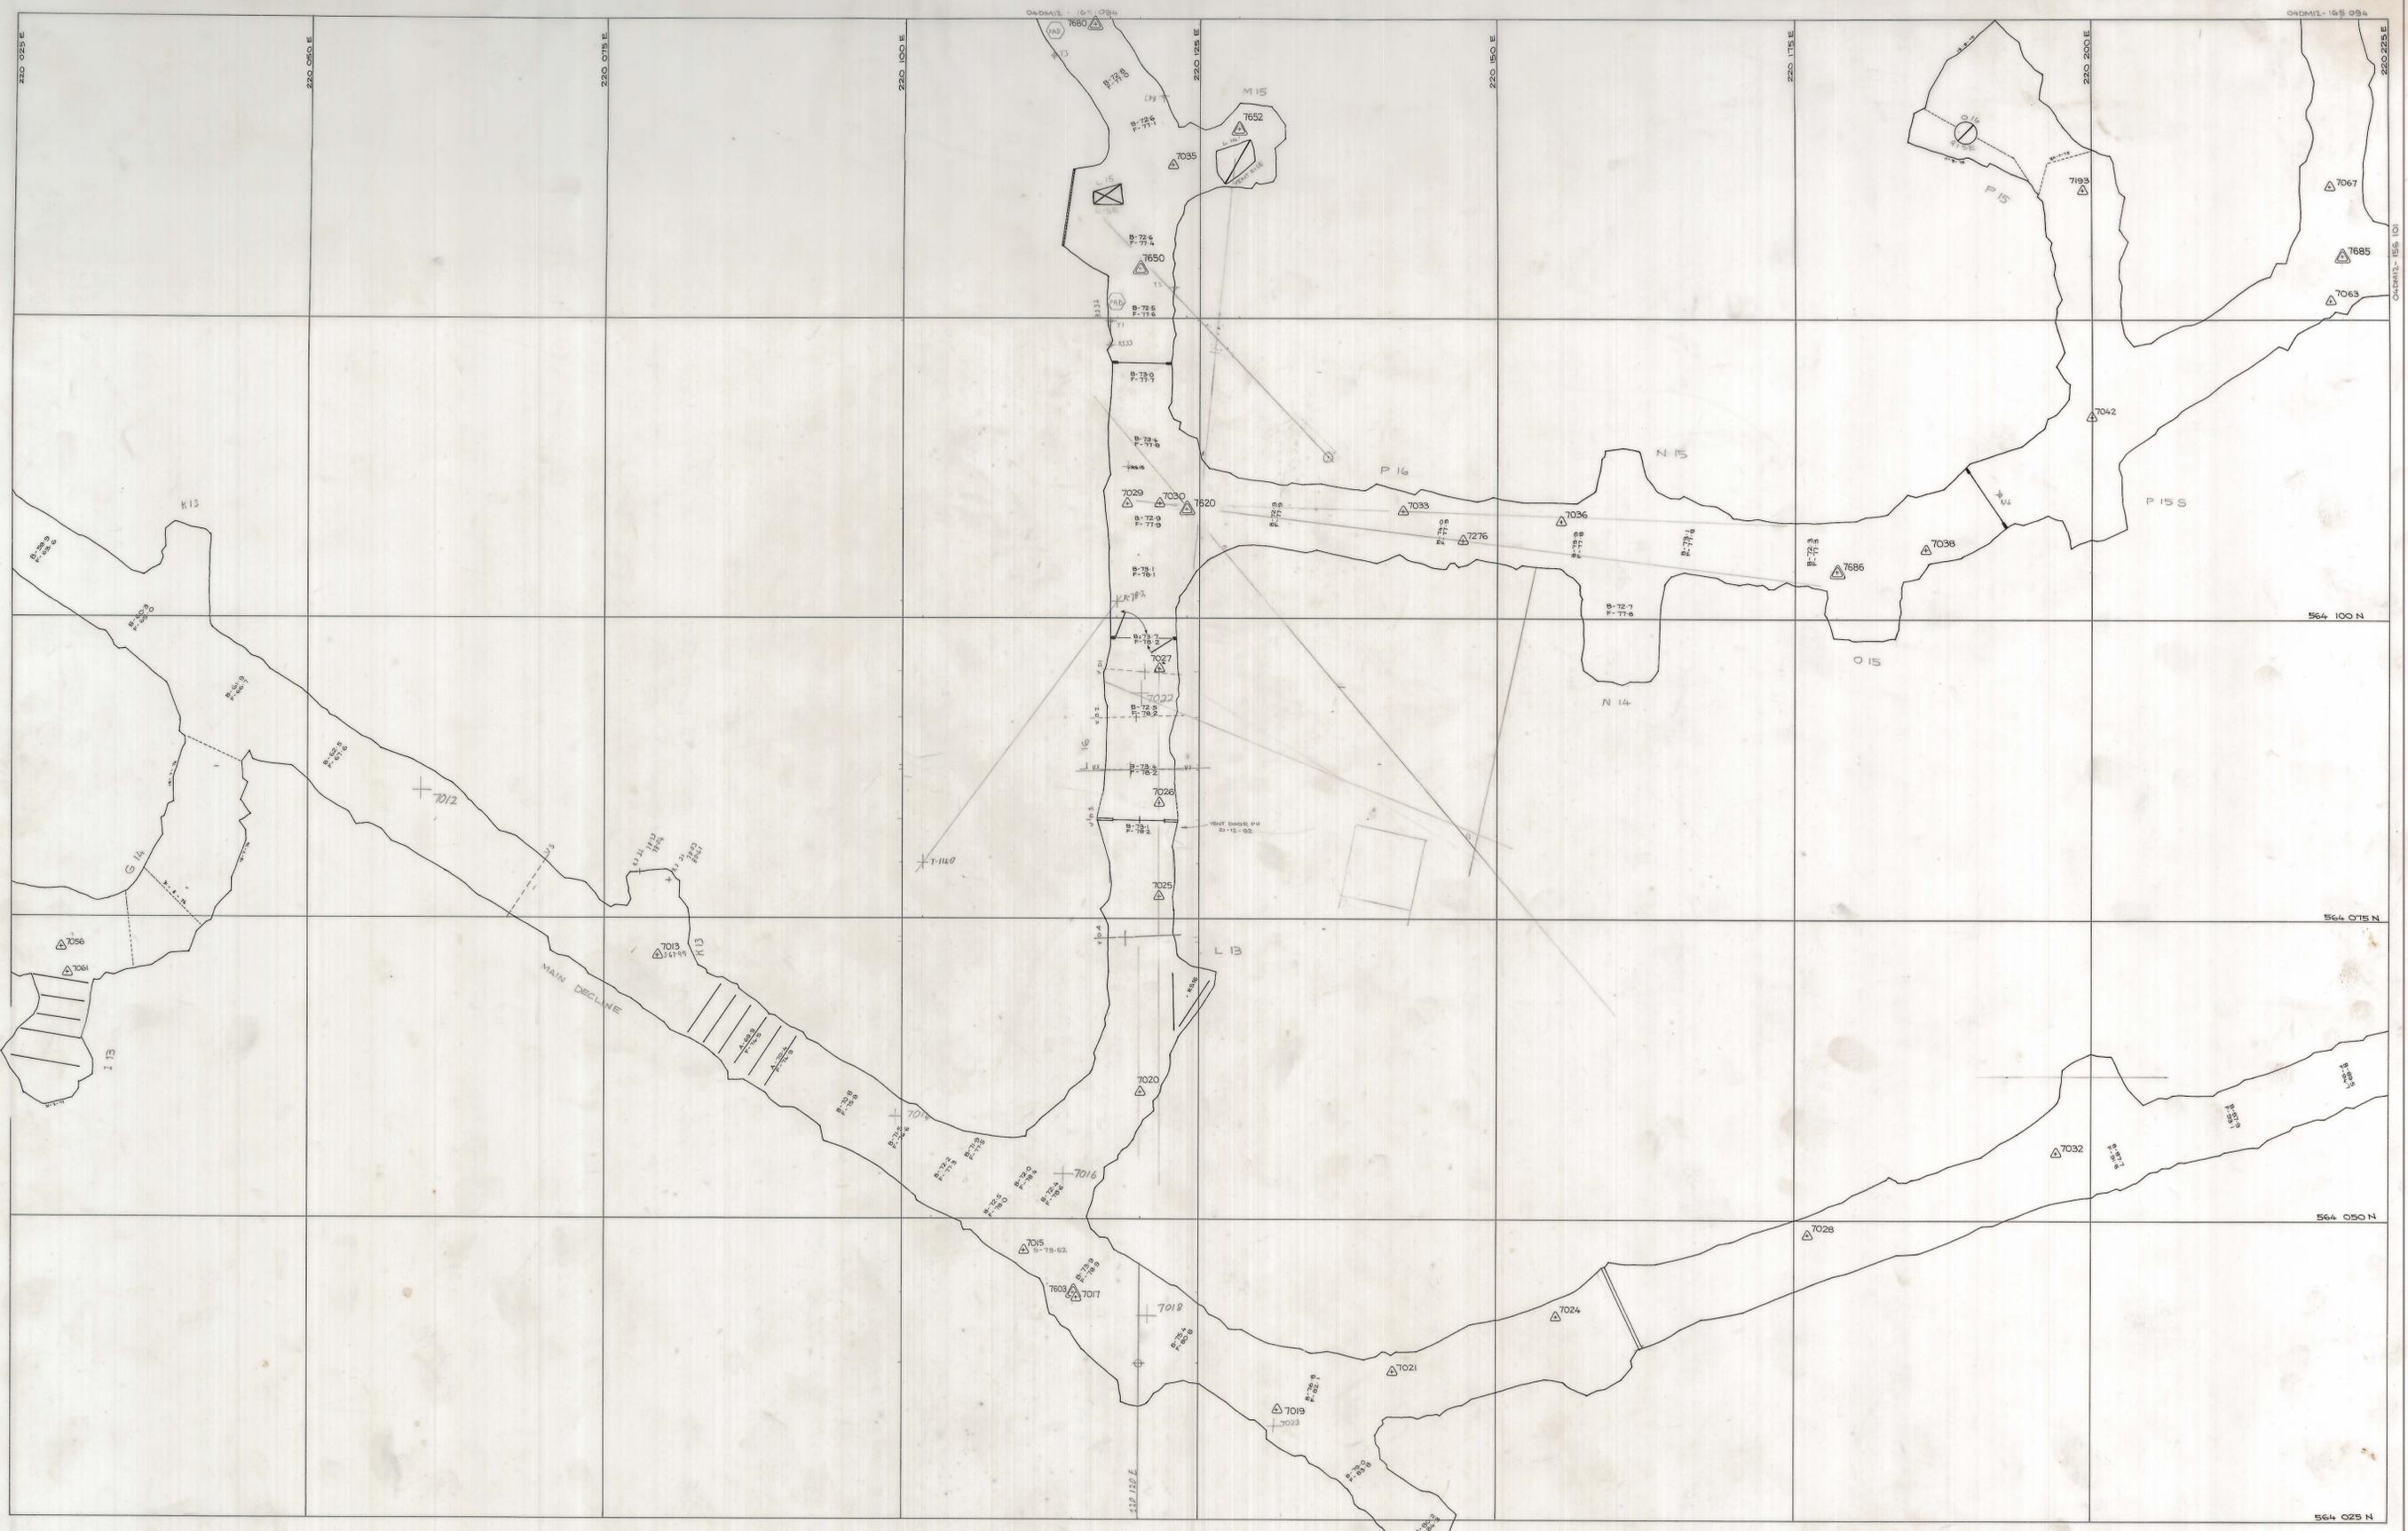

SCALE 1:250

north

LOCATION
DOLPHIN MINE

SUBJECT
- 75m ZONE

KIS KING ISLAND SCHEELITE
A DIVISION OF WARMAN INTERNATIONAL

GRASSY KING ISLAND

PLAN NUMBER
O4DM12 - 155 092