



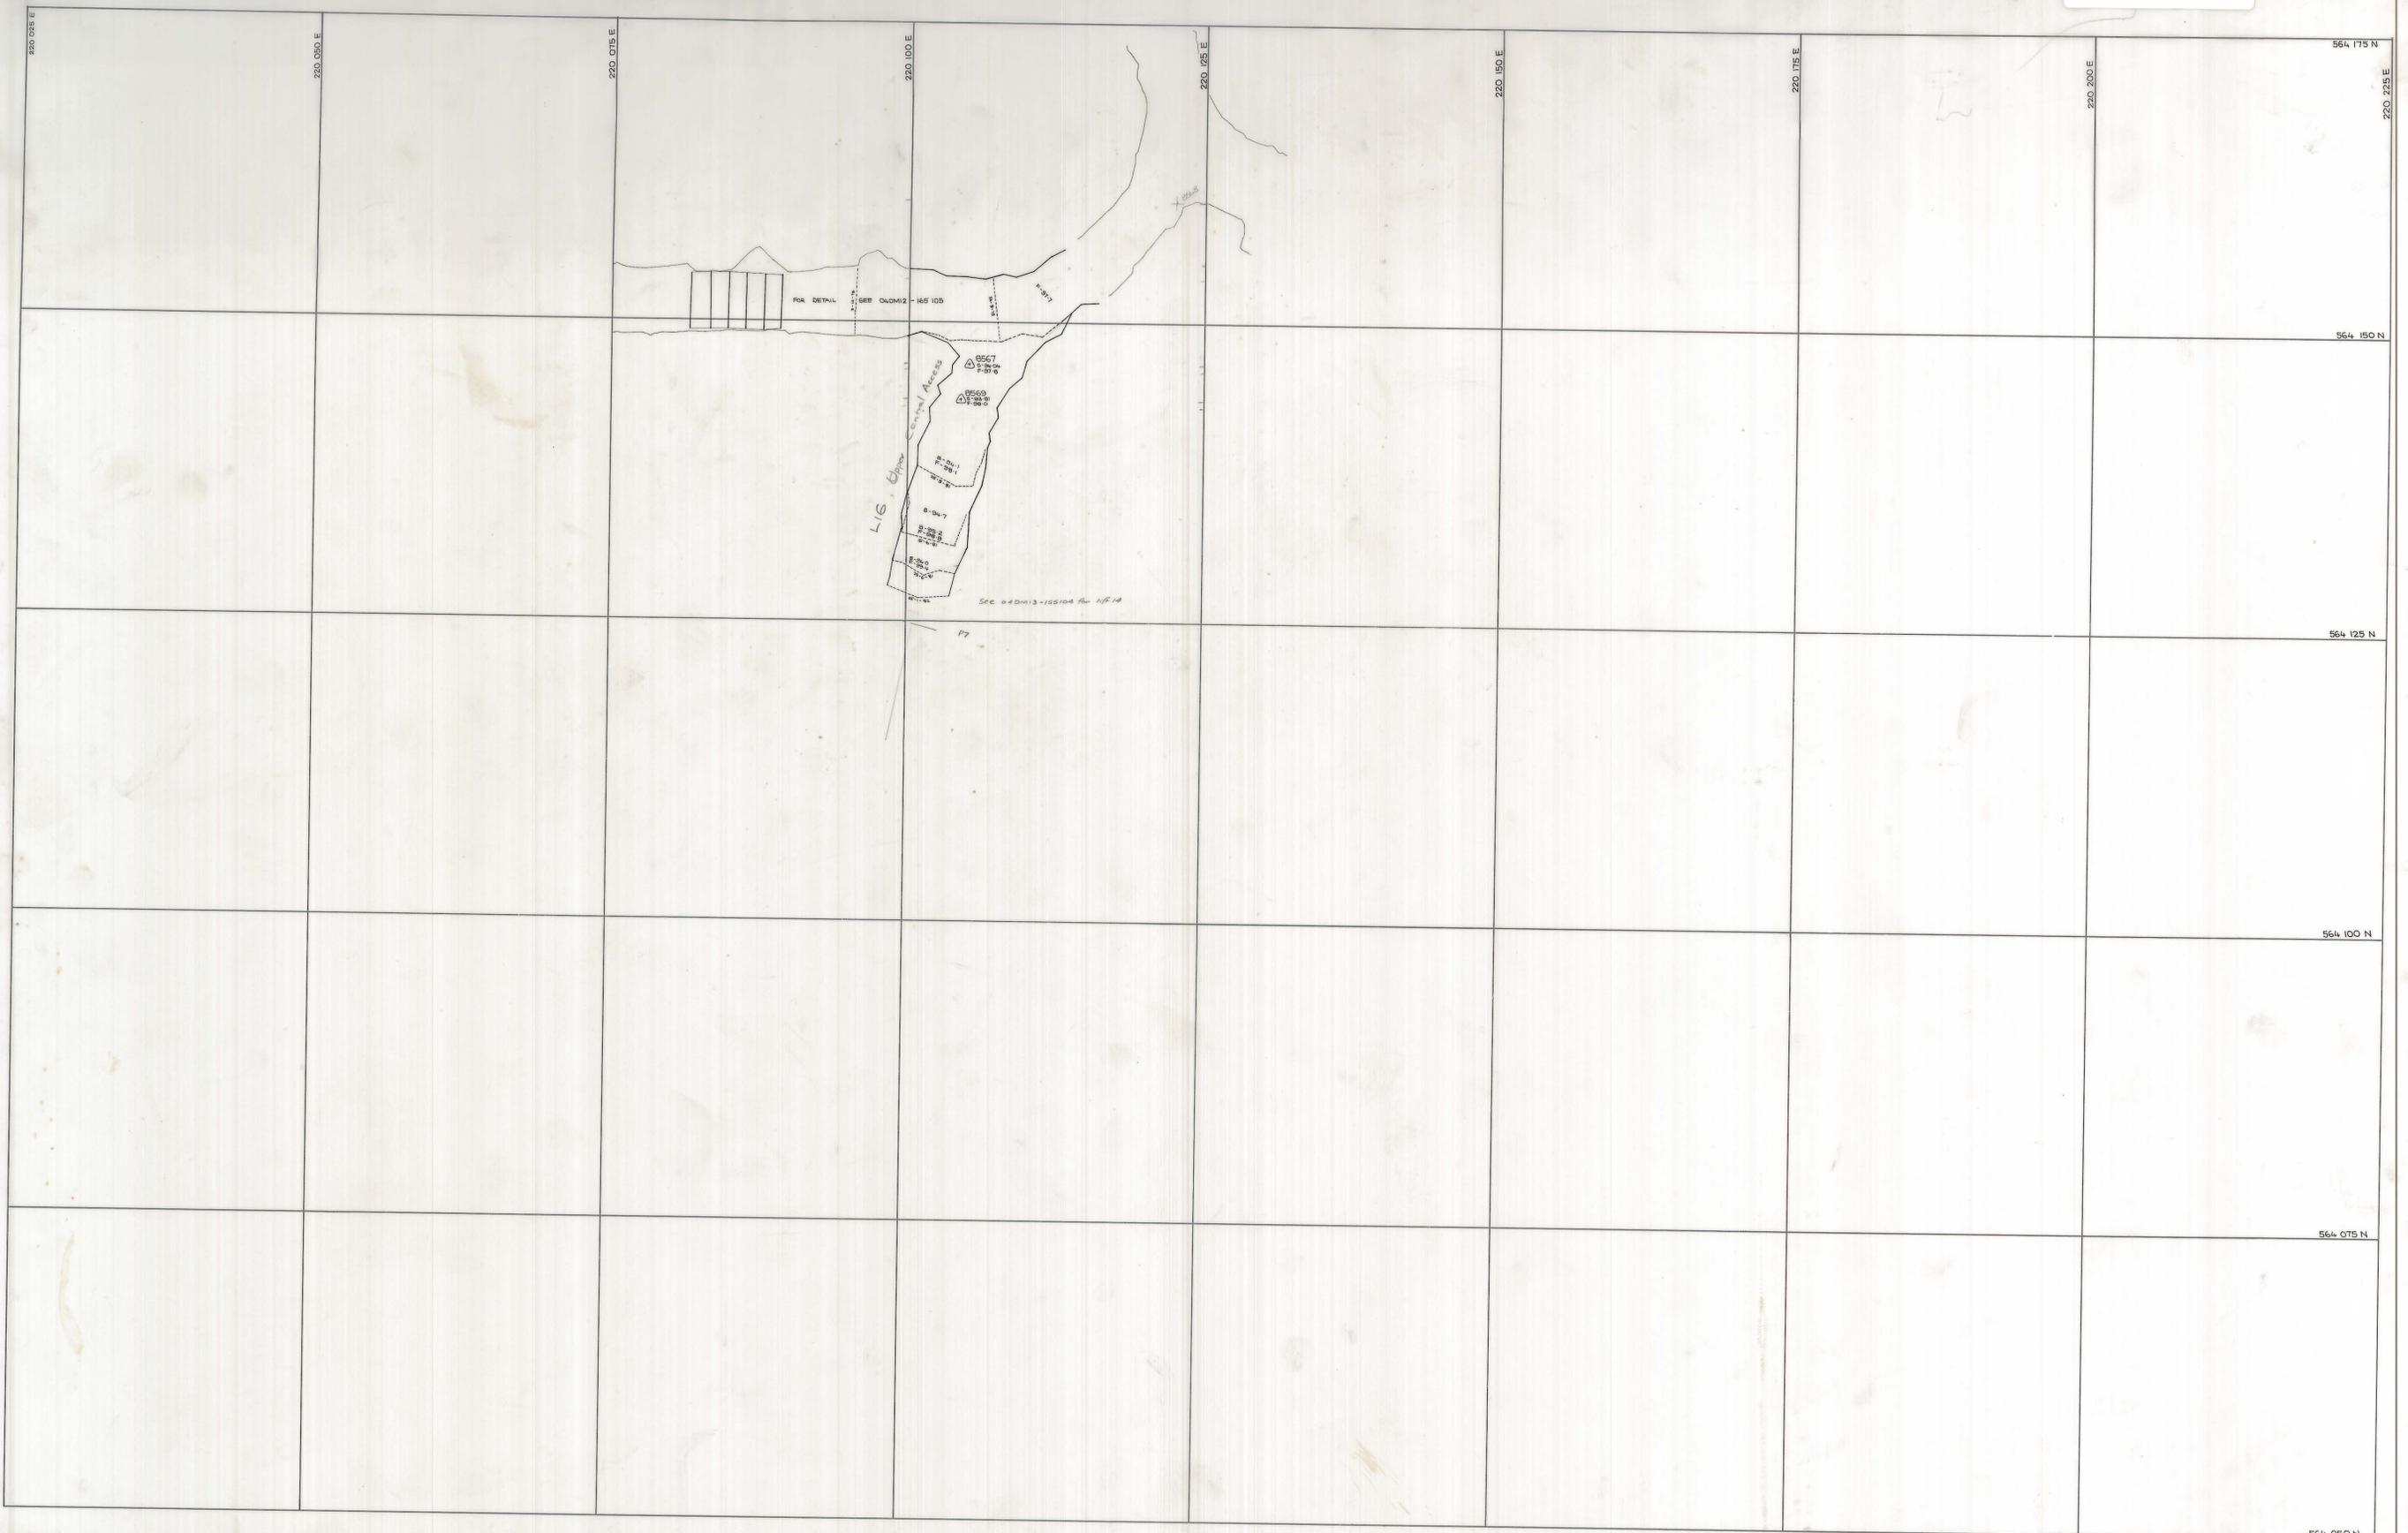

04DM12 - 155 105 S

0374-2038

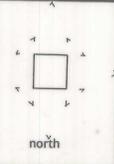

	SCALE	1:250	 north	LOCATION DOLPHIN MINE	 <b>KING ISLAND SCHEELITE</b> <small>A DIVISION OF WARMAN INTERNATIONAL</small> GRASSY KING ISLAND <small>PLAN NUMBER</small>
				<b>L 16</b> <b>C CENTRAL ACCESS</b>	