


5 cm

27 JUN 1981

04DM12-165 094

-75m  
ZONE

0374-2040

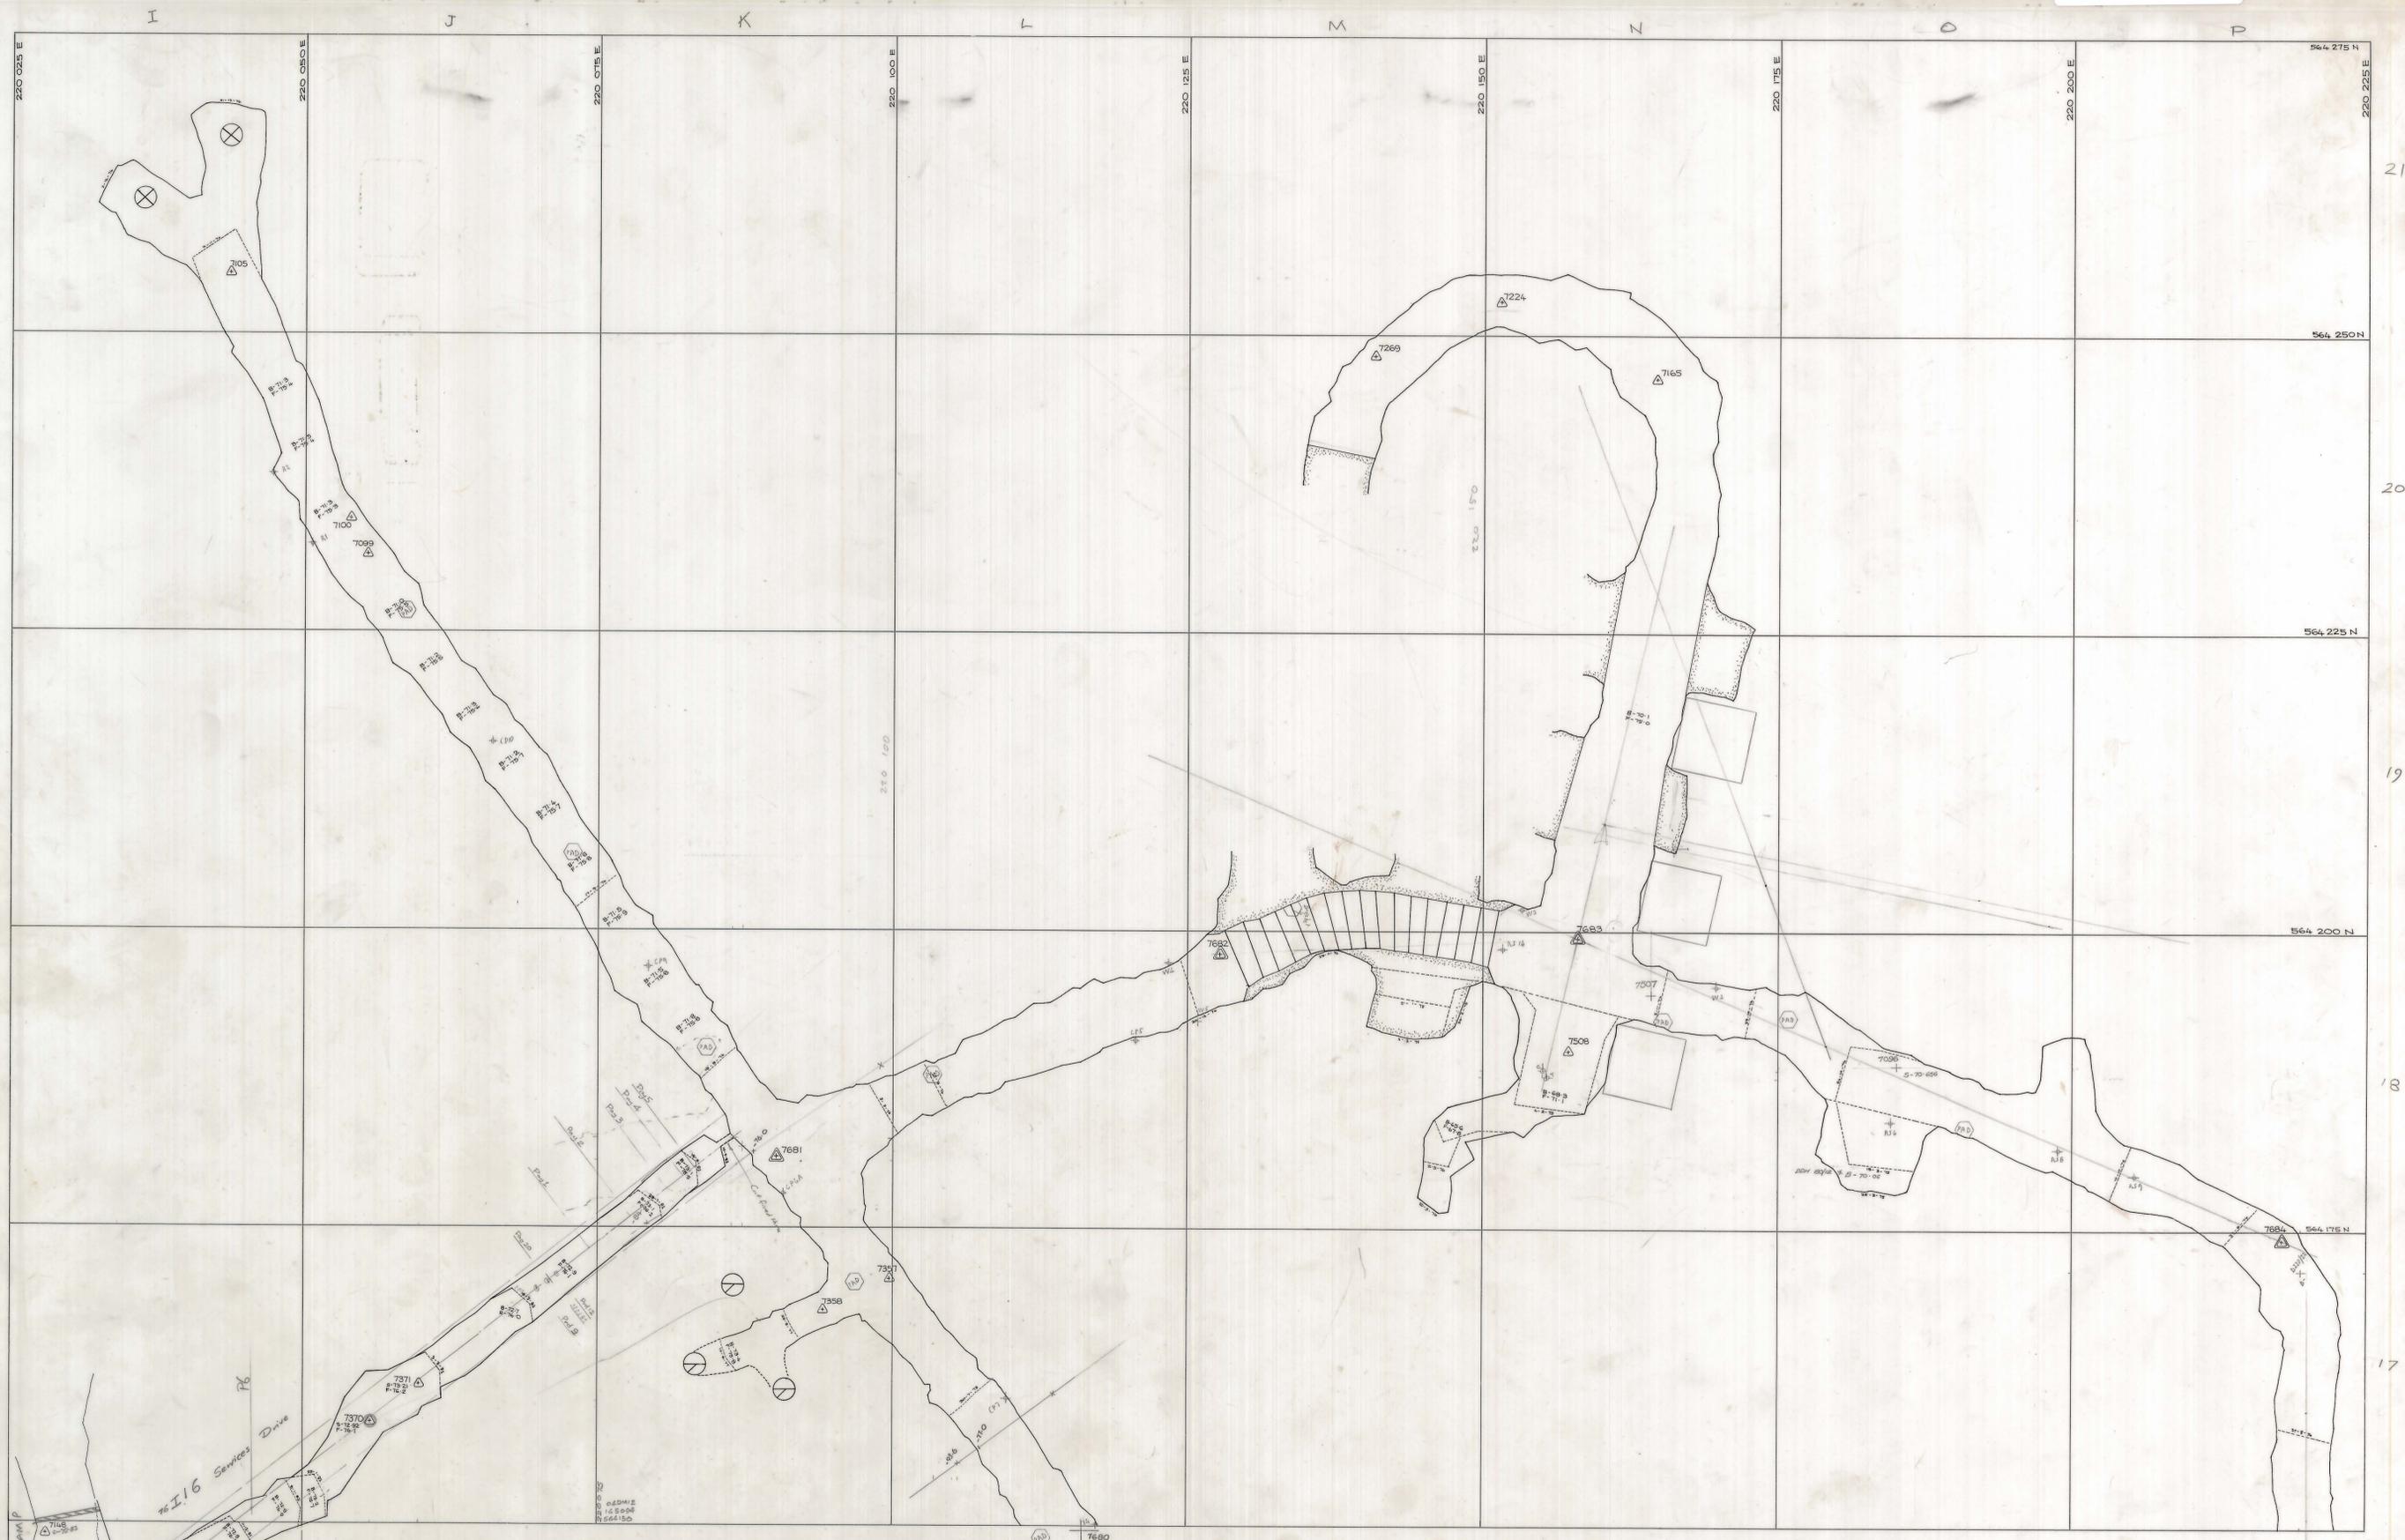

SCALE 1:250

I16 Drive design 03DM12-3003  
I16 C&G Sheet DD008



north

LOCATION DOLPHIN MINE

SUBJECT

- 75m ZONE

**KIS** KING ISLAND SCHEELITE  
A DIVISION OF WARMAN INTERNATIONAL

GRASSY KING ISLAND

PLAN NUMBER

04DM12 - 165 094