



27 JUN 1981

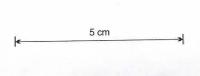

0374-2045

04 DM 13 - 1131

C. PIT  
150

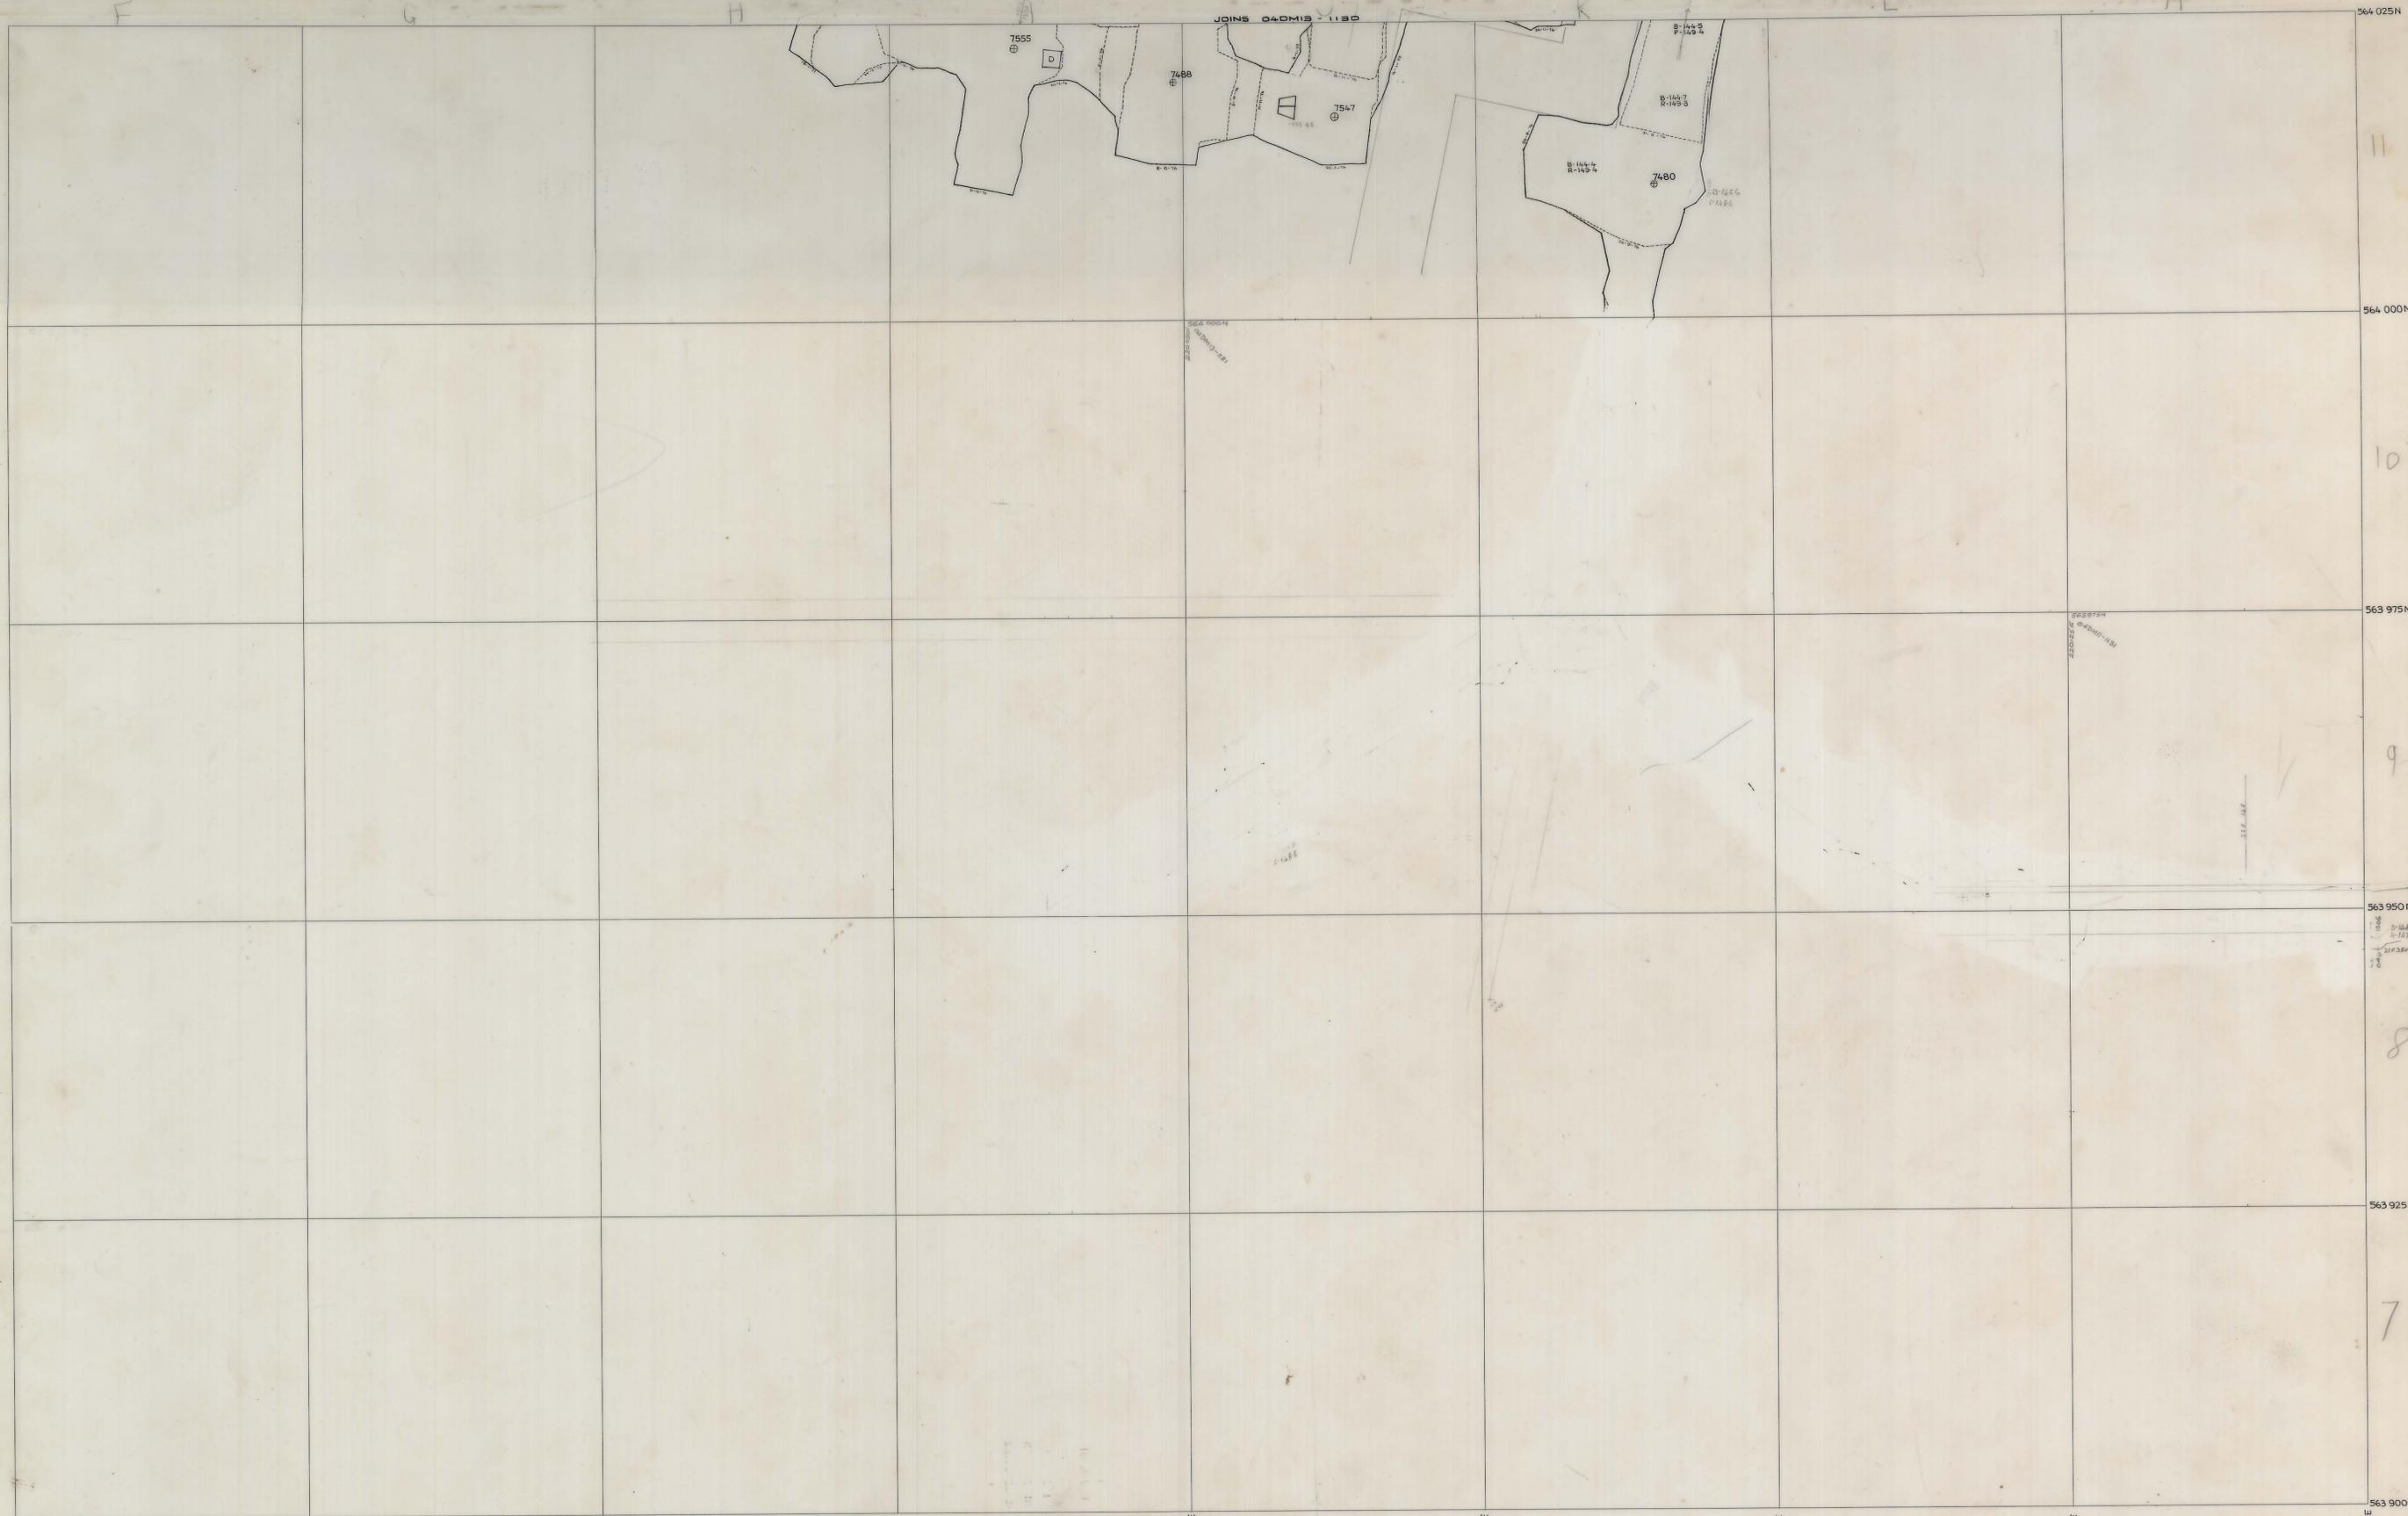

219 950 E 219 915 E 220 000 E 220 025 E 220 050 E 220 075 E 220 100 E 220 125 E 220 150 E  
563 900 N 563 925 N 563 950 N 563 975 N 564 000 N 564 025 N

SCALE 1:250



LOCATION DOLPHIN MINE  
SUBJECT C CENTRAL & C PIT STOPE  
- 150m UNDERCUT

**KIS** KING ISLAND SCHEELITE  
A DIVISION OF WARMAN INTERNATIONAL  
GRASSY KING ISLAND  
PLAN NUMBER 04DM13 - 1131

6

7

8

9

10

11