
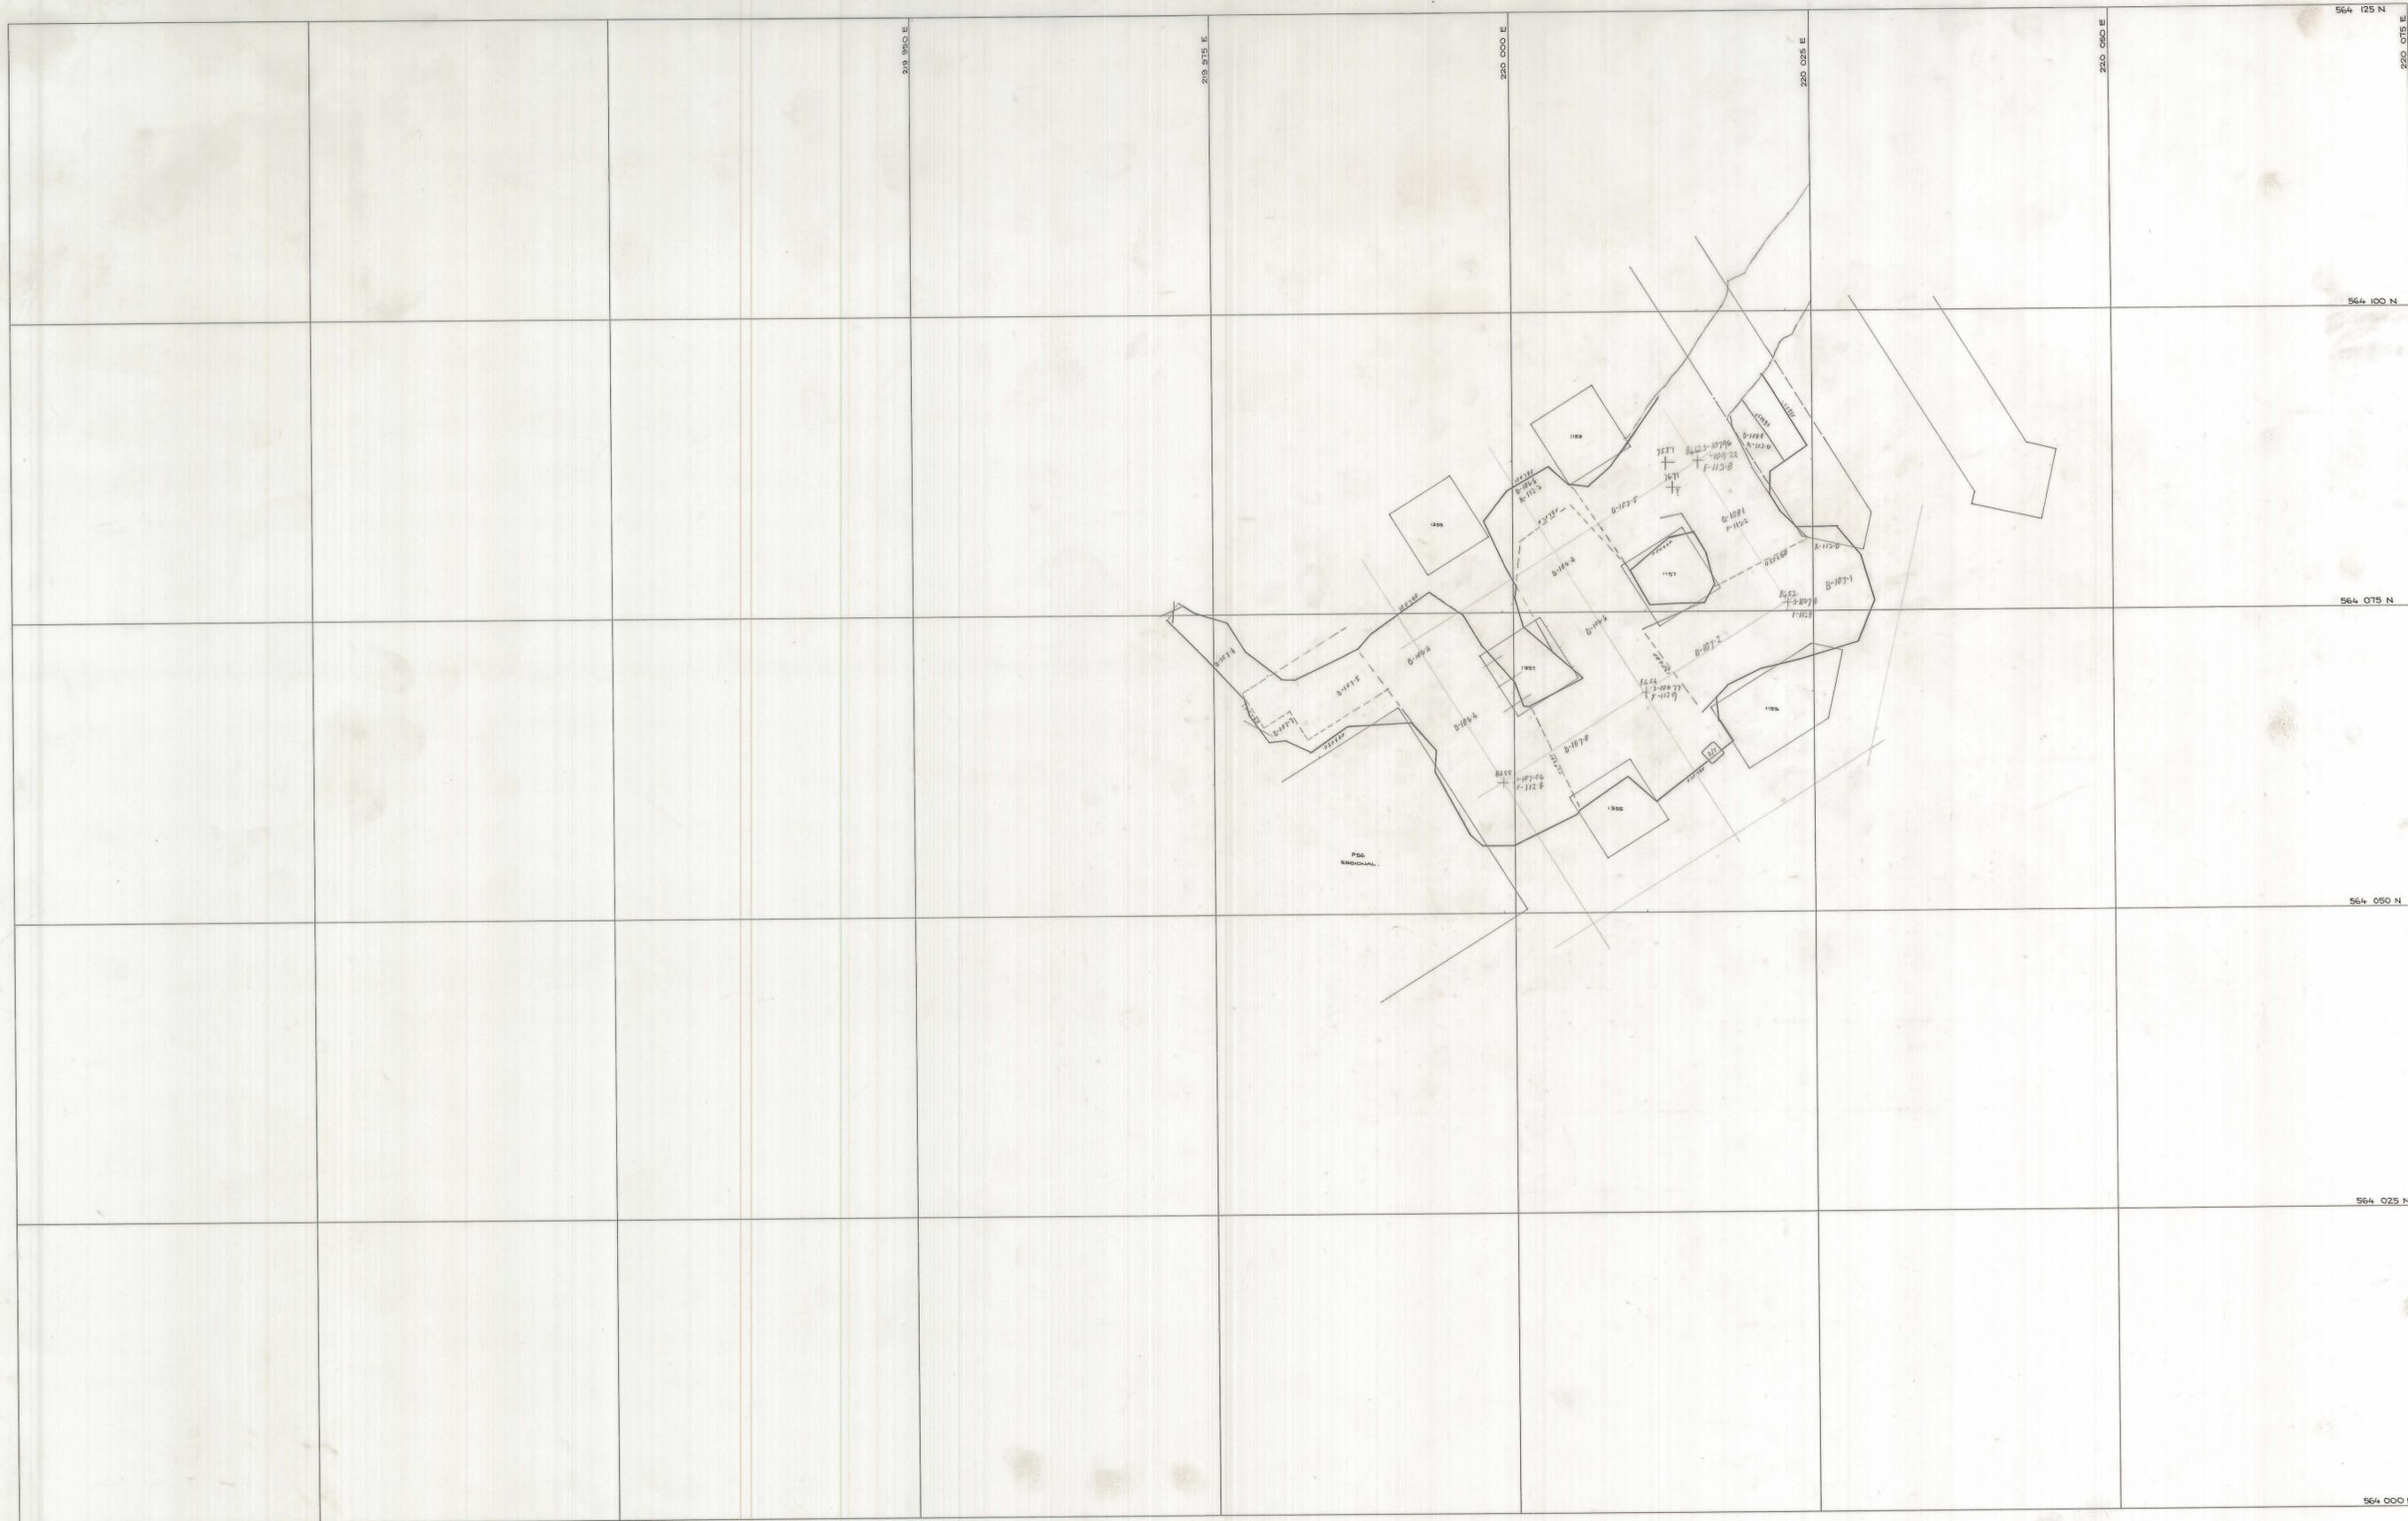


0374-2046

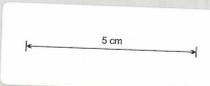

SCALE 1: 250

LOCATION

DOLPHIN MINE

SUBJECT

C PIT STOPE  
- 110 m CONTOUR

**KIS** KING ISLAND SCHEELITE  
A DIVISION OF WARMAN INTERNATIONAL

GRASSY KING ISLAND

PLAN NUMBER  
04DM13 - 154 107

north