



27 JUN 1981

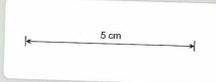

04DM13-154 108

Upper Pit
-1140
LIFT 31

0374-2047

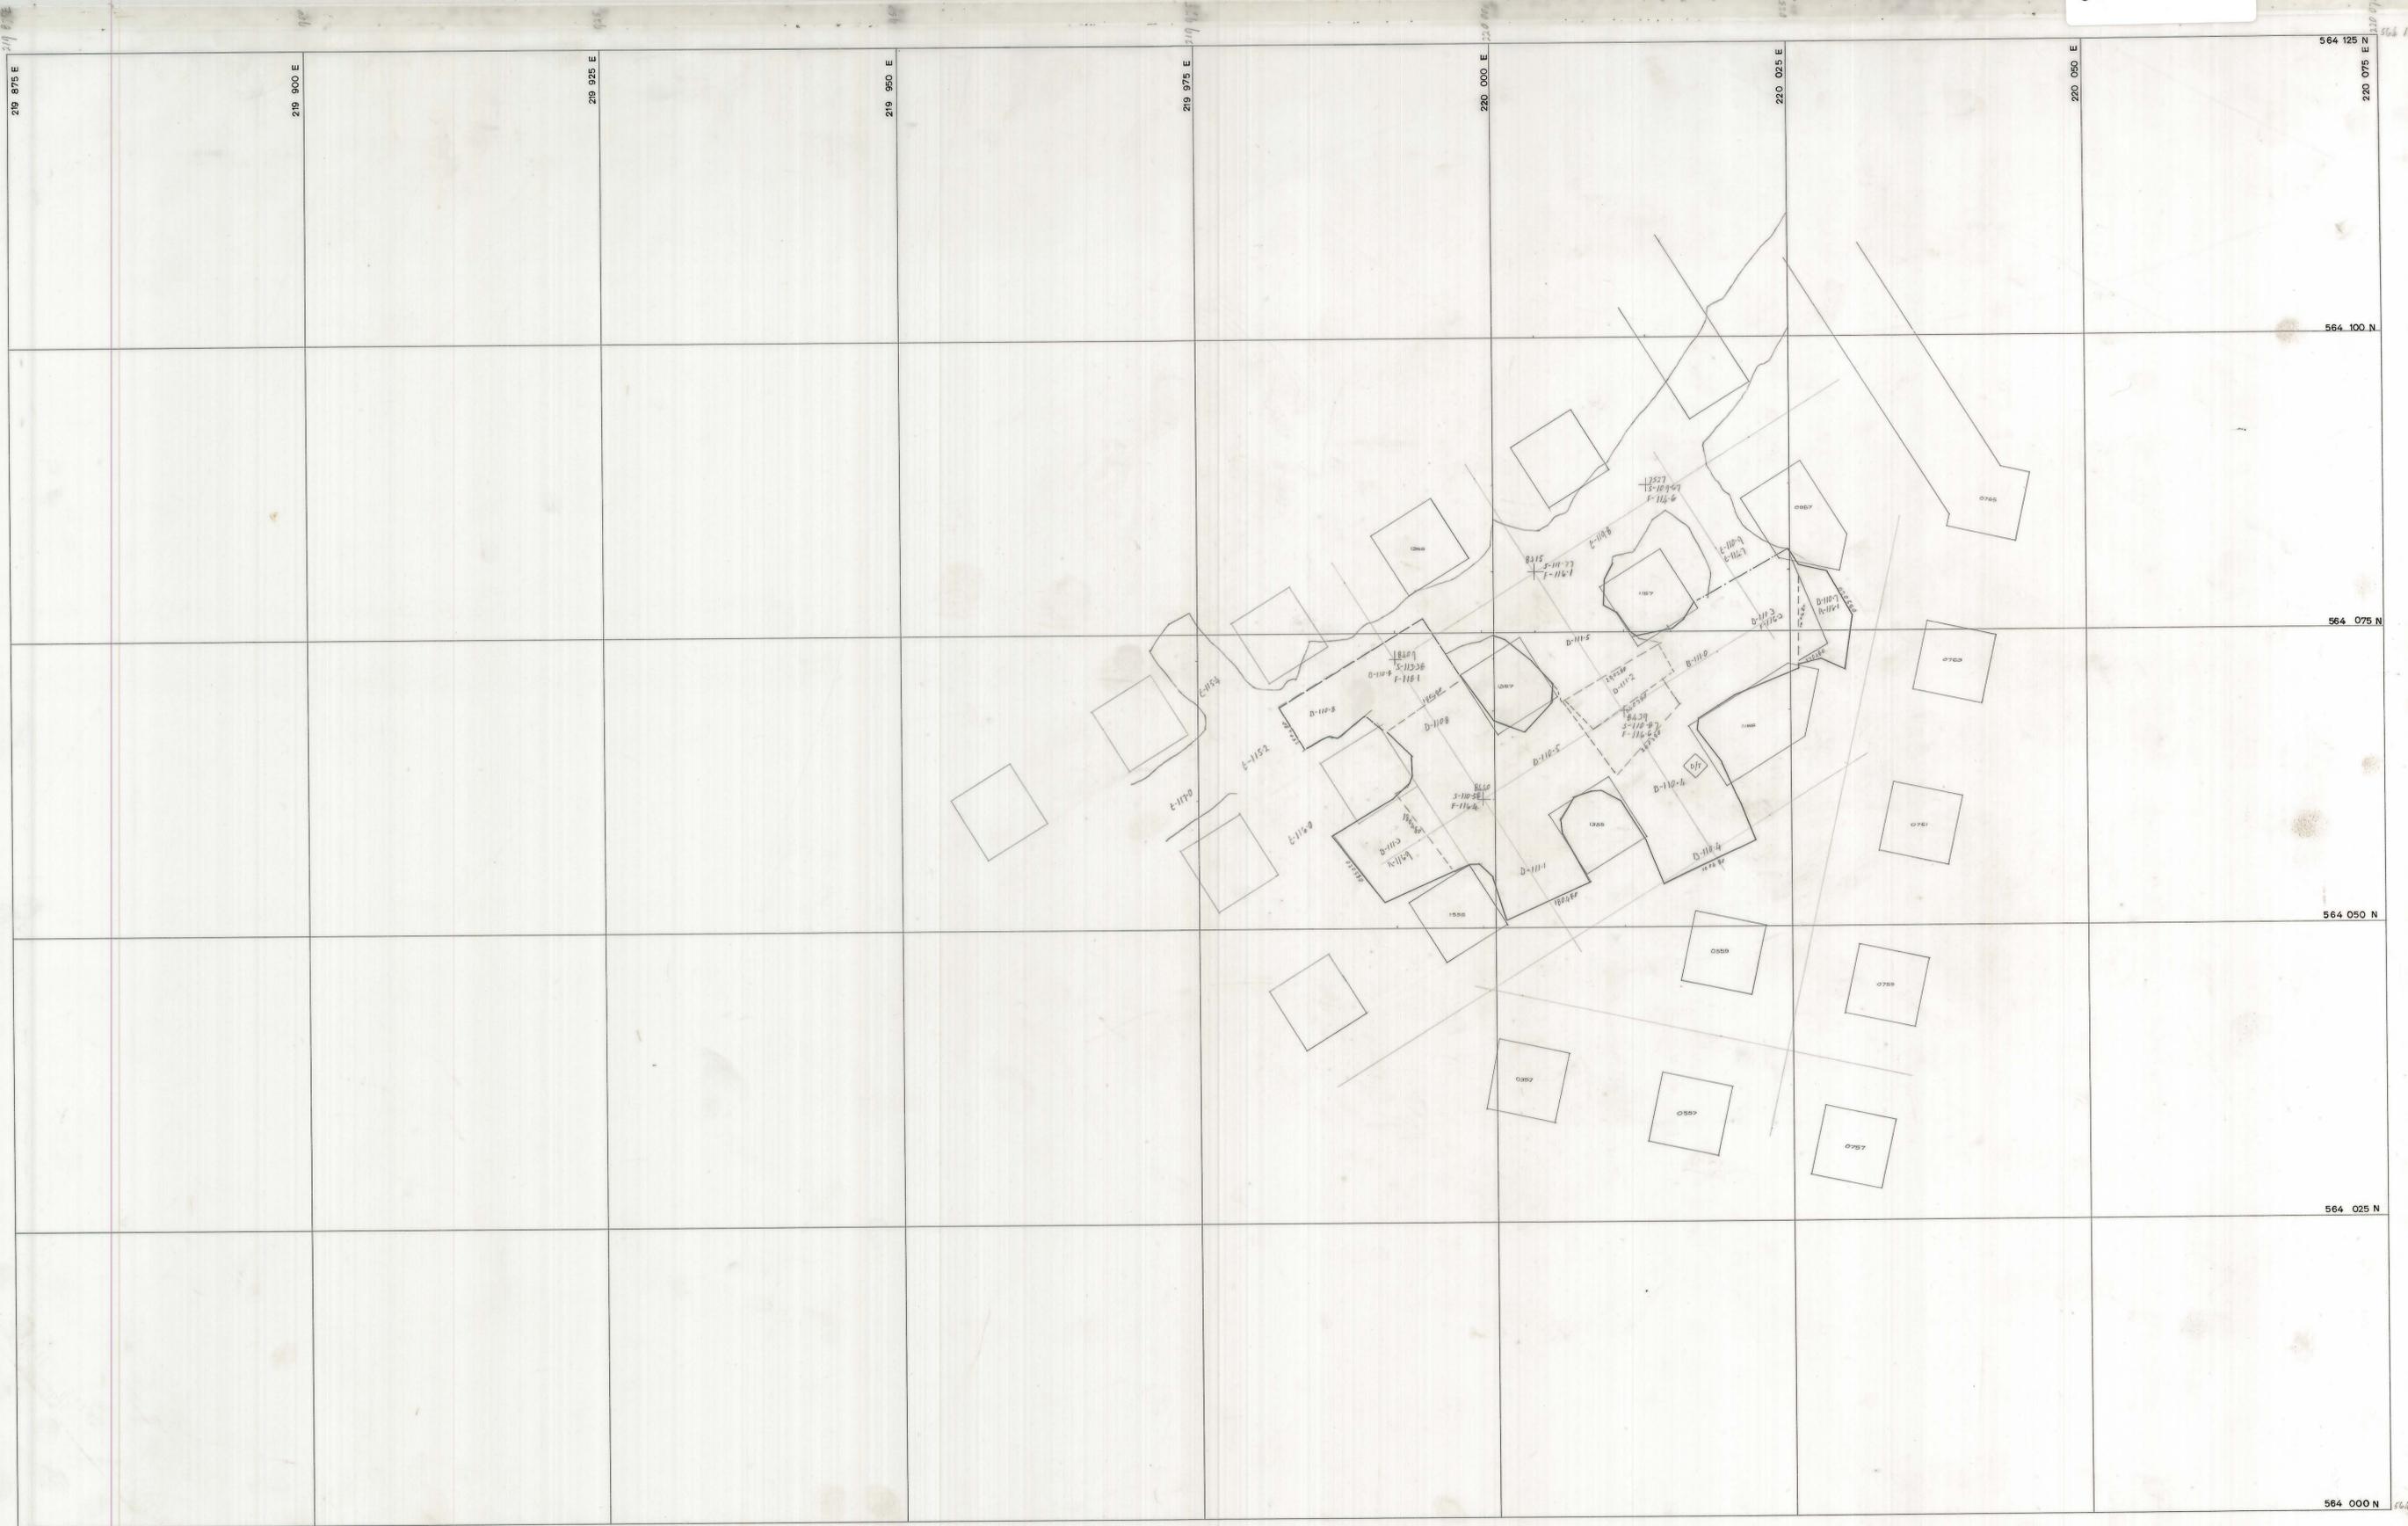

SCALE 1: 250

LOCATION DOLPHIN MINE

SUBJECT C PIT STOPE
- 114 m CONTOUR

north

KIS KING ISLAND SCHEELITE
A DIVISION OF WARMAN INTERNATIONAL
GRASSY KING ISLAND

PLAN NUMBER 04DM13 - 154 108