


04DM13-145136S

DM
Dag Pit
H10 - L10
1st Lift

0374-2051

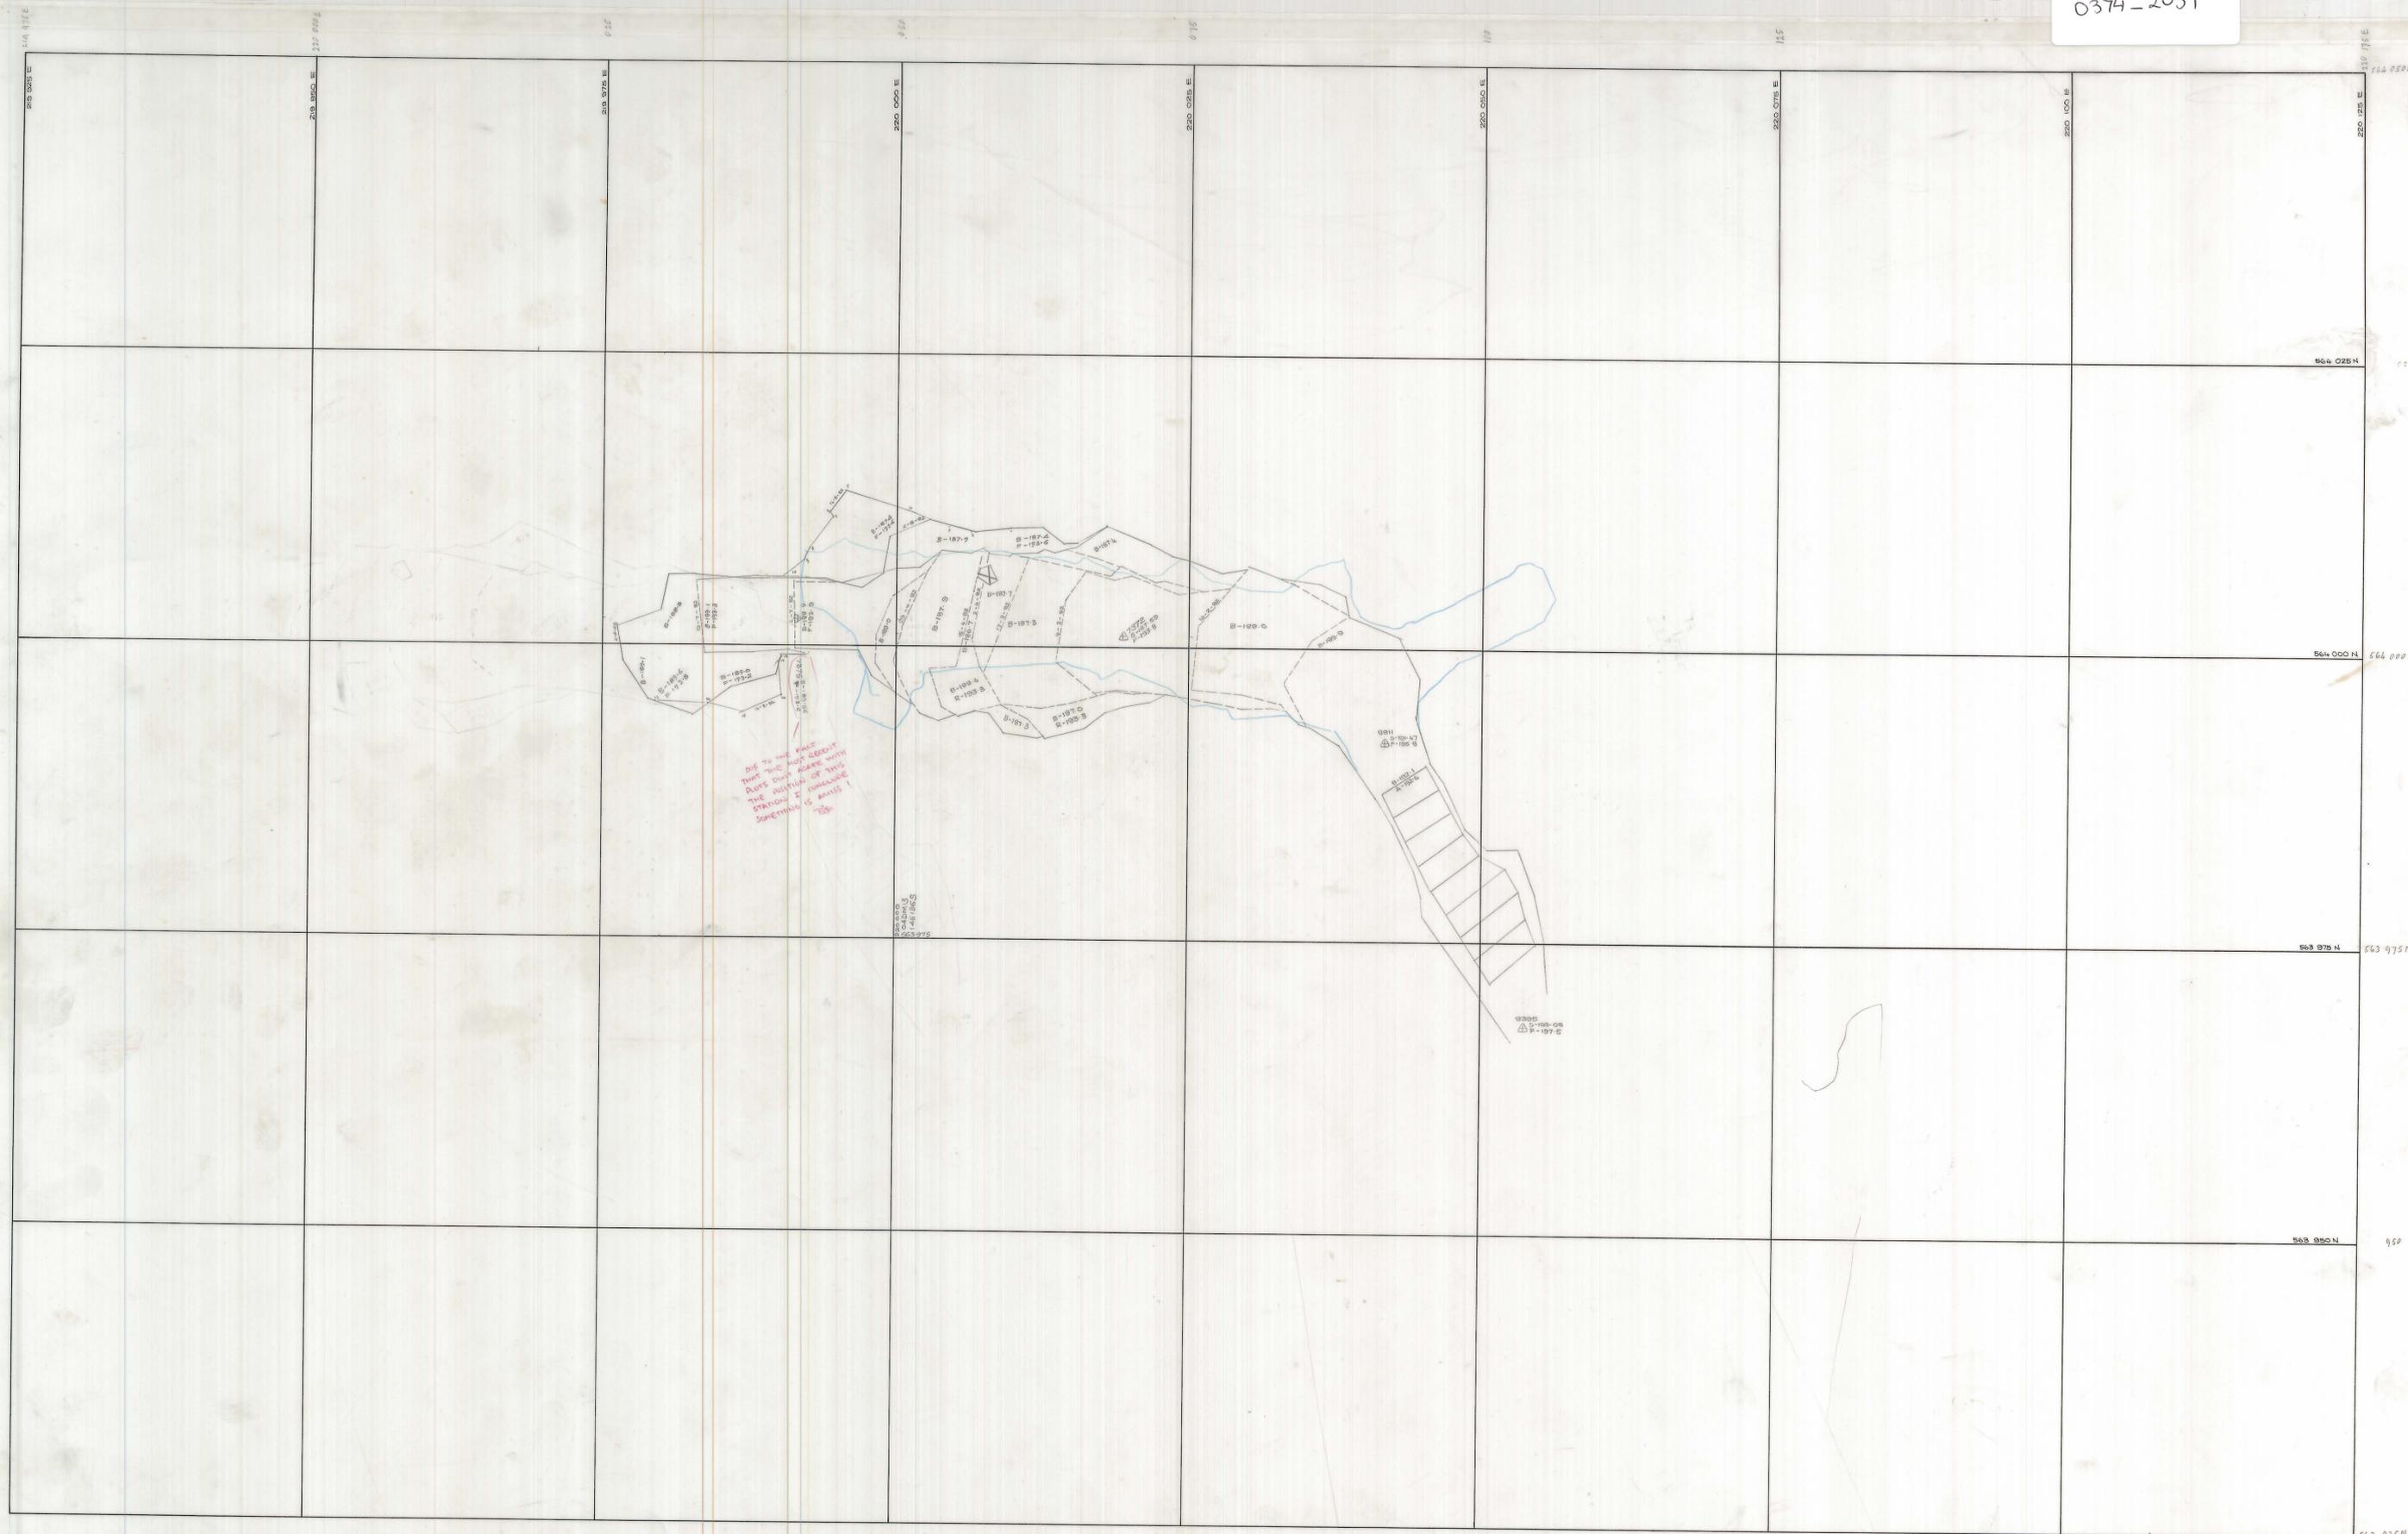

	SCALE 1: 250 6.1.1925 Calc Sheet DS25	 north	LOCATION DOLPHIN MINE SUBJECT Dodo Stope PIT DAG H10 lift 1	 A DIVISION OF WARMAN INTERNATIONAL GRASSY KING ISLAND PLAN NUMBER 04DM13 - 145 136 S
--	---	-----------	--	--