


0374-115 138

DM 206 Lower Pit 146

0374-2052

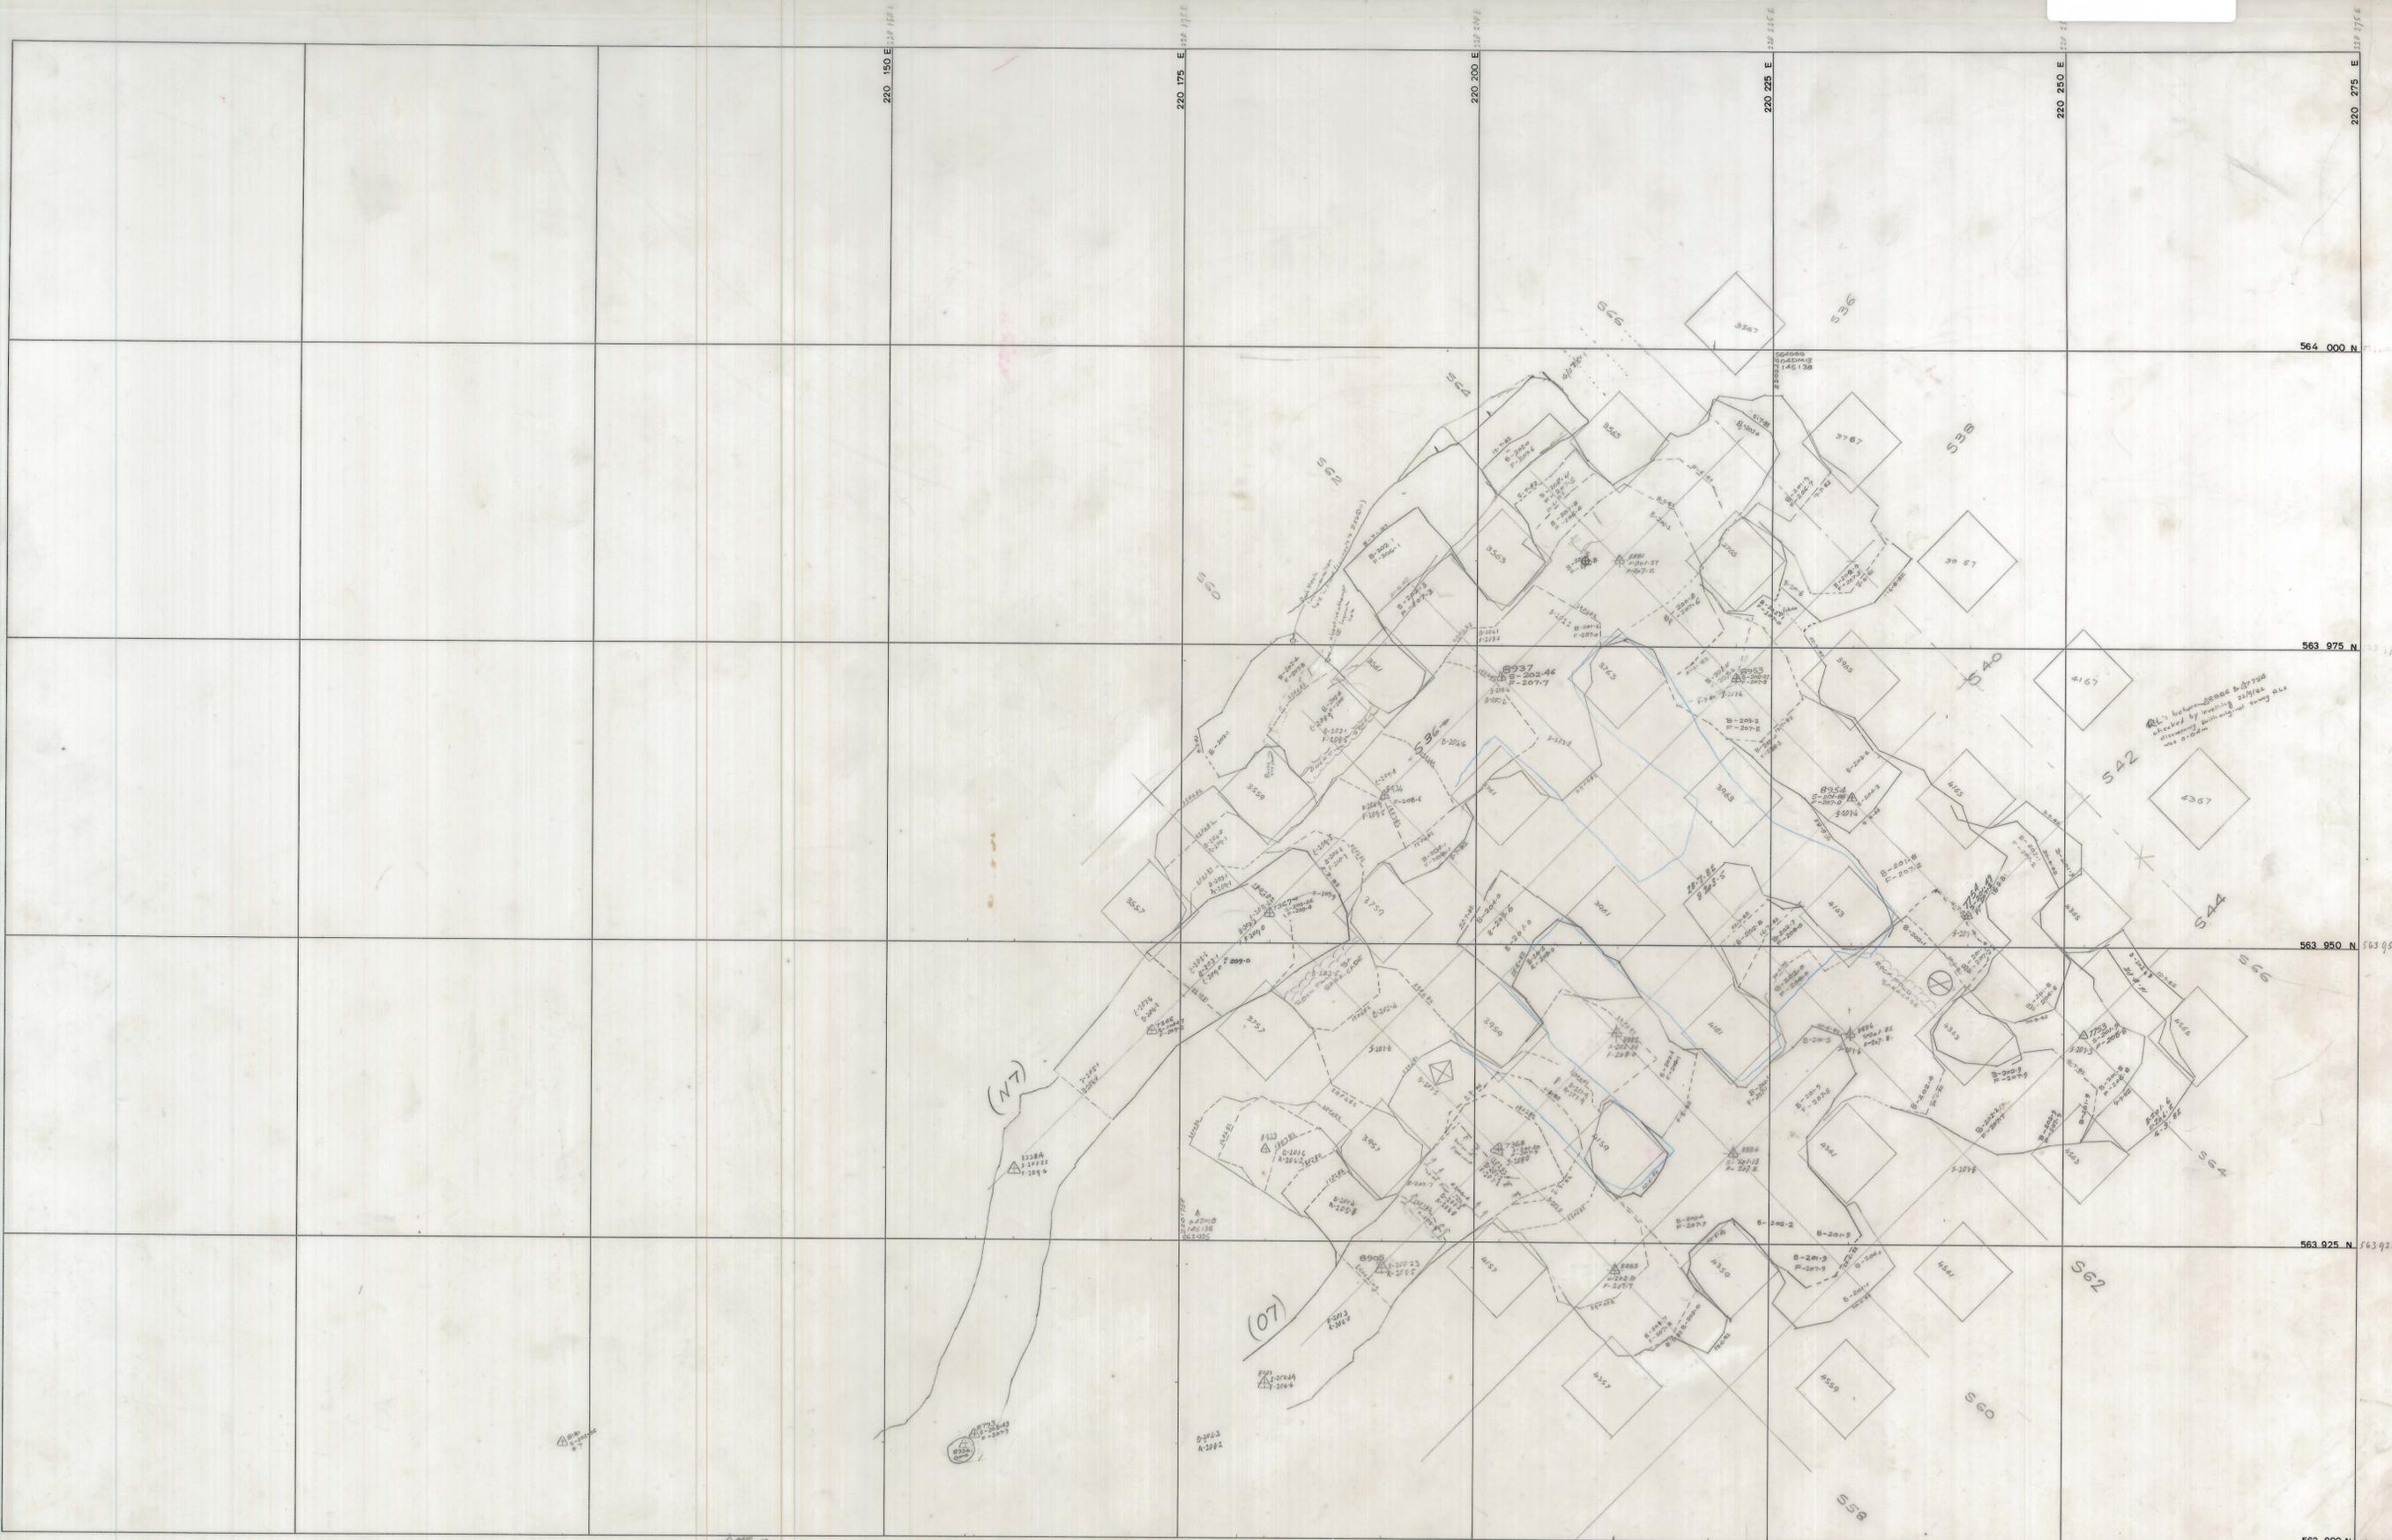

SCALE 1: 250

Calc Sheet DS 21

LOCATION DOLPHIN MINE


SUBJECT LOWER PIT STOPE

- 206 m contour

Lift G

Gradient Line RL - 205.7

north

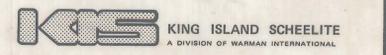

GRASSY KING ISLAND

PLAN NUMBER 04DM13 - 145 138