


0374-2054

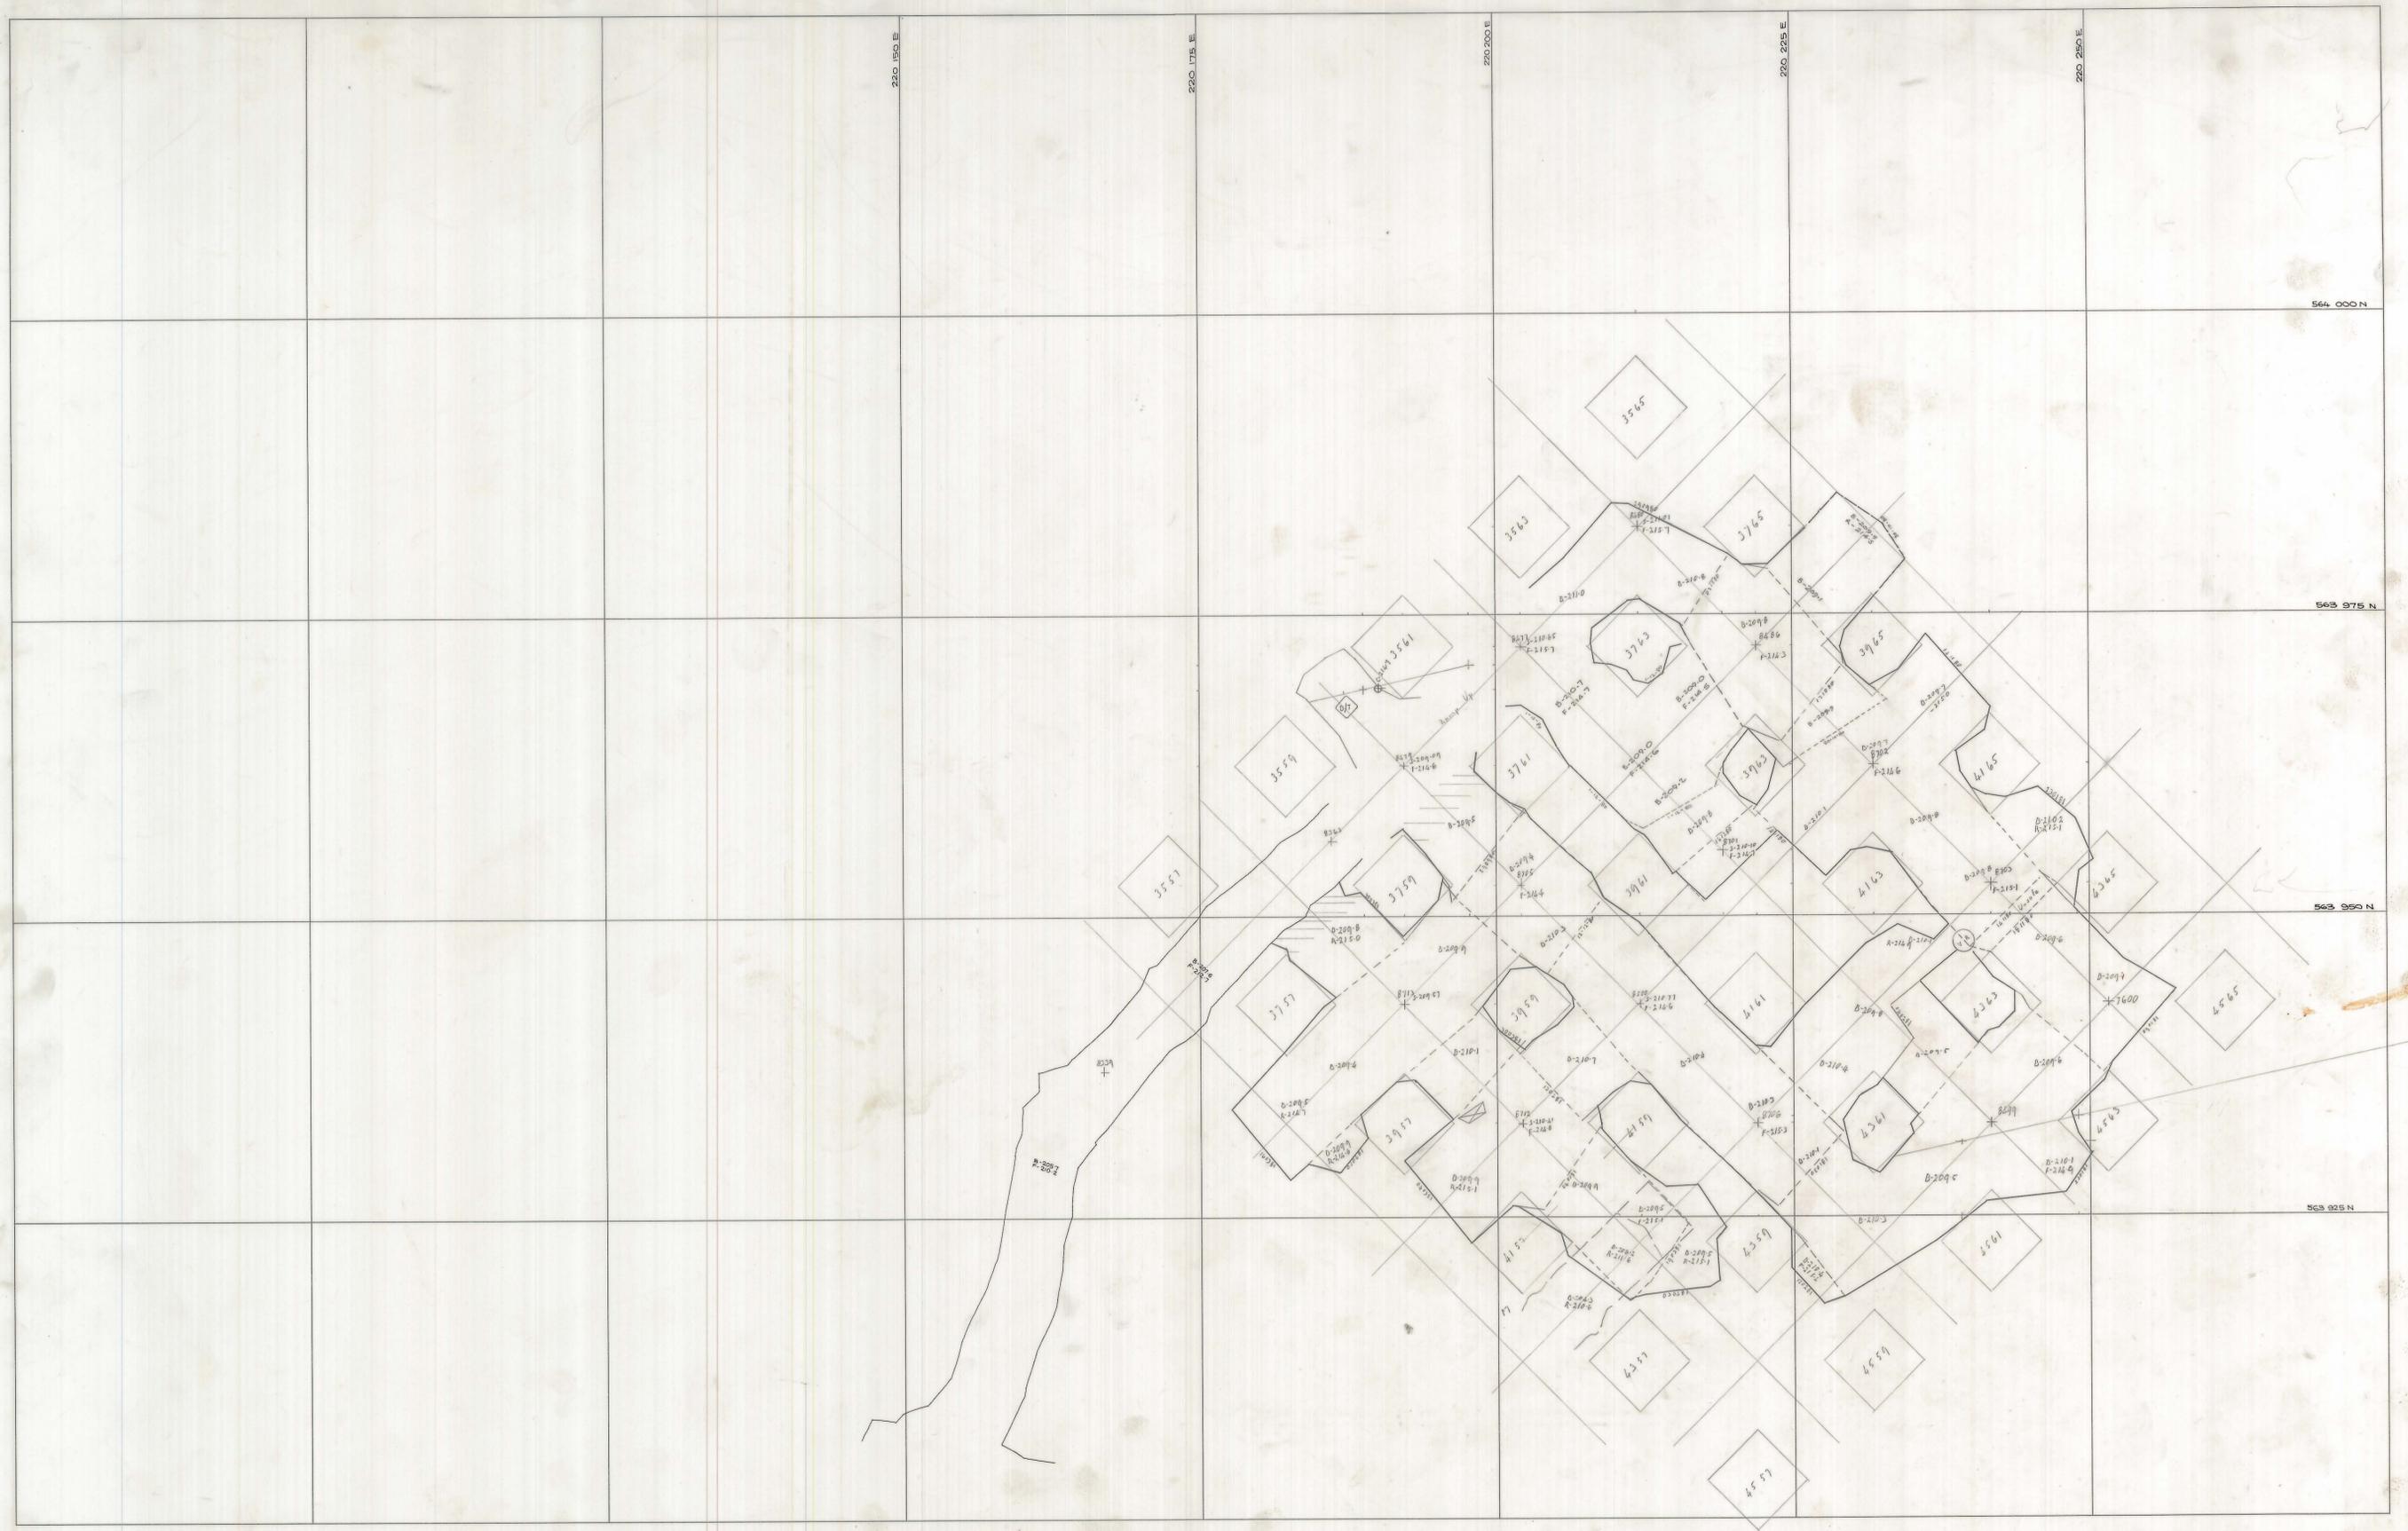

SCALE 1:250

LOCATION DOLPHIN MINE

SUBJECT Lower Pit Stope  
-213m CONTOUR  
L/P

north



PLAN NUMBER 04DM13 - 145 140