


04DM13-154 104

Upper Pit
100

0374-2058

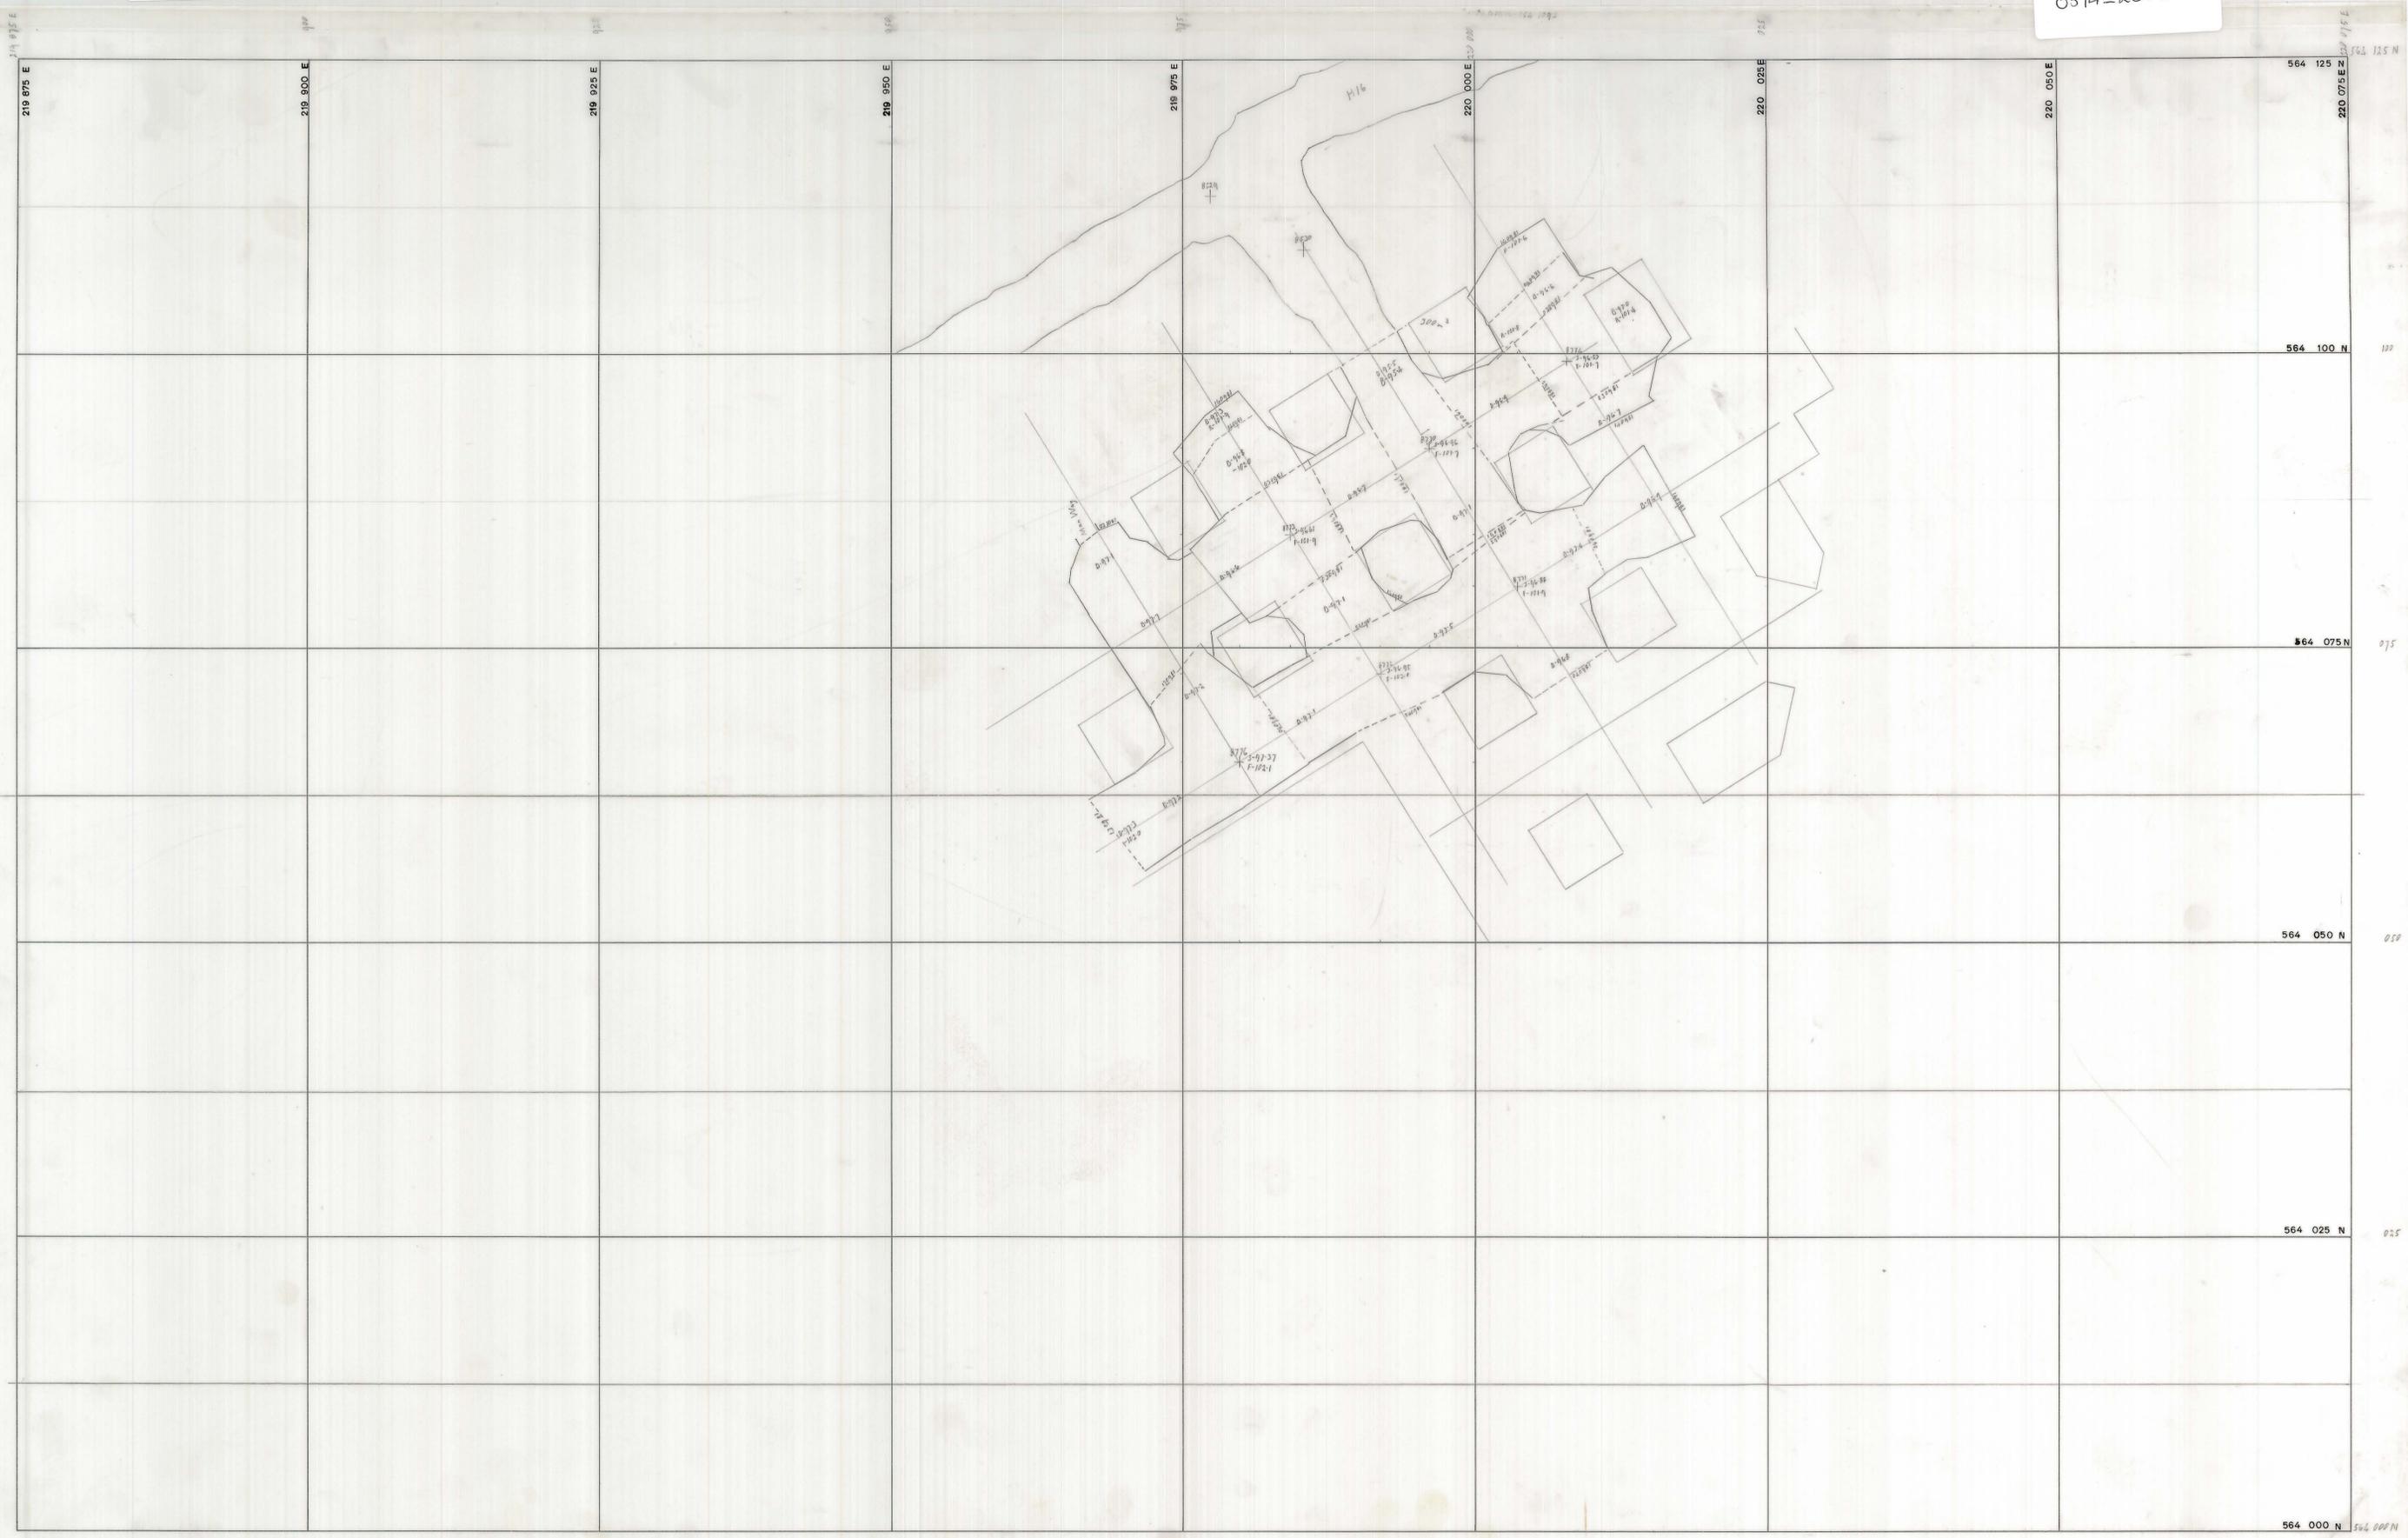

SCALE 1: 250

LOCATION

DOLPHIN MINE

SUBJECT

UPPER PIT
- 100m contour

north



GRASSY KING ISLAND

PLAN NUMBER 04DM13 - 154 104