
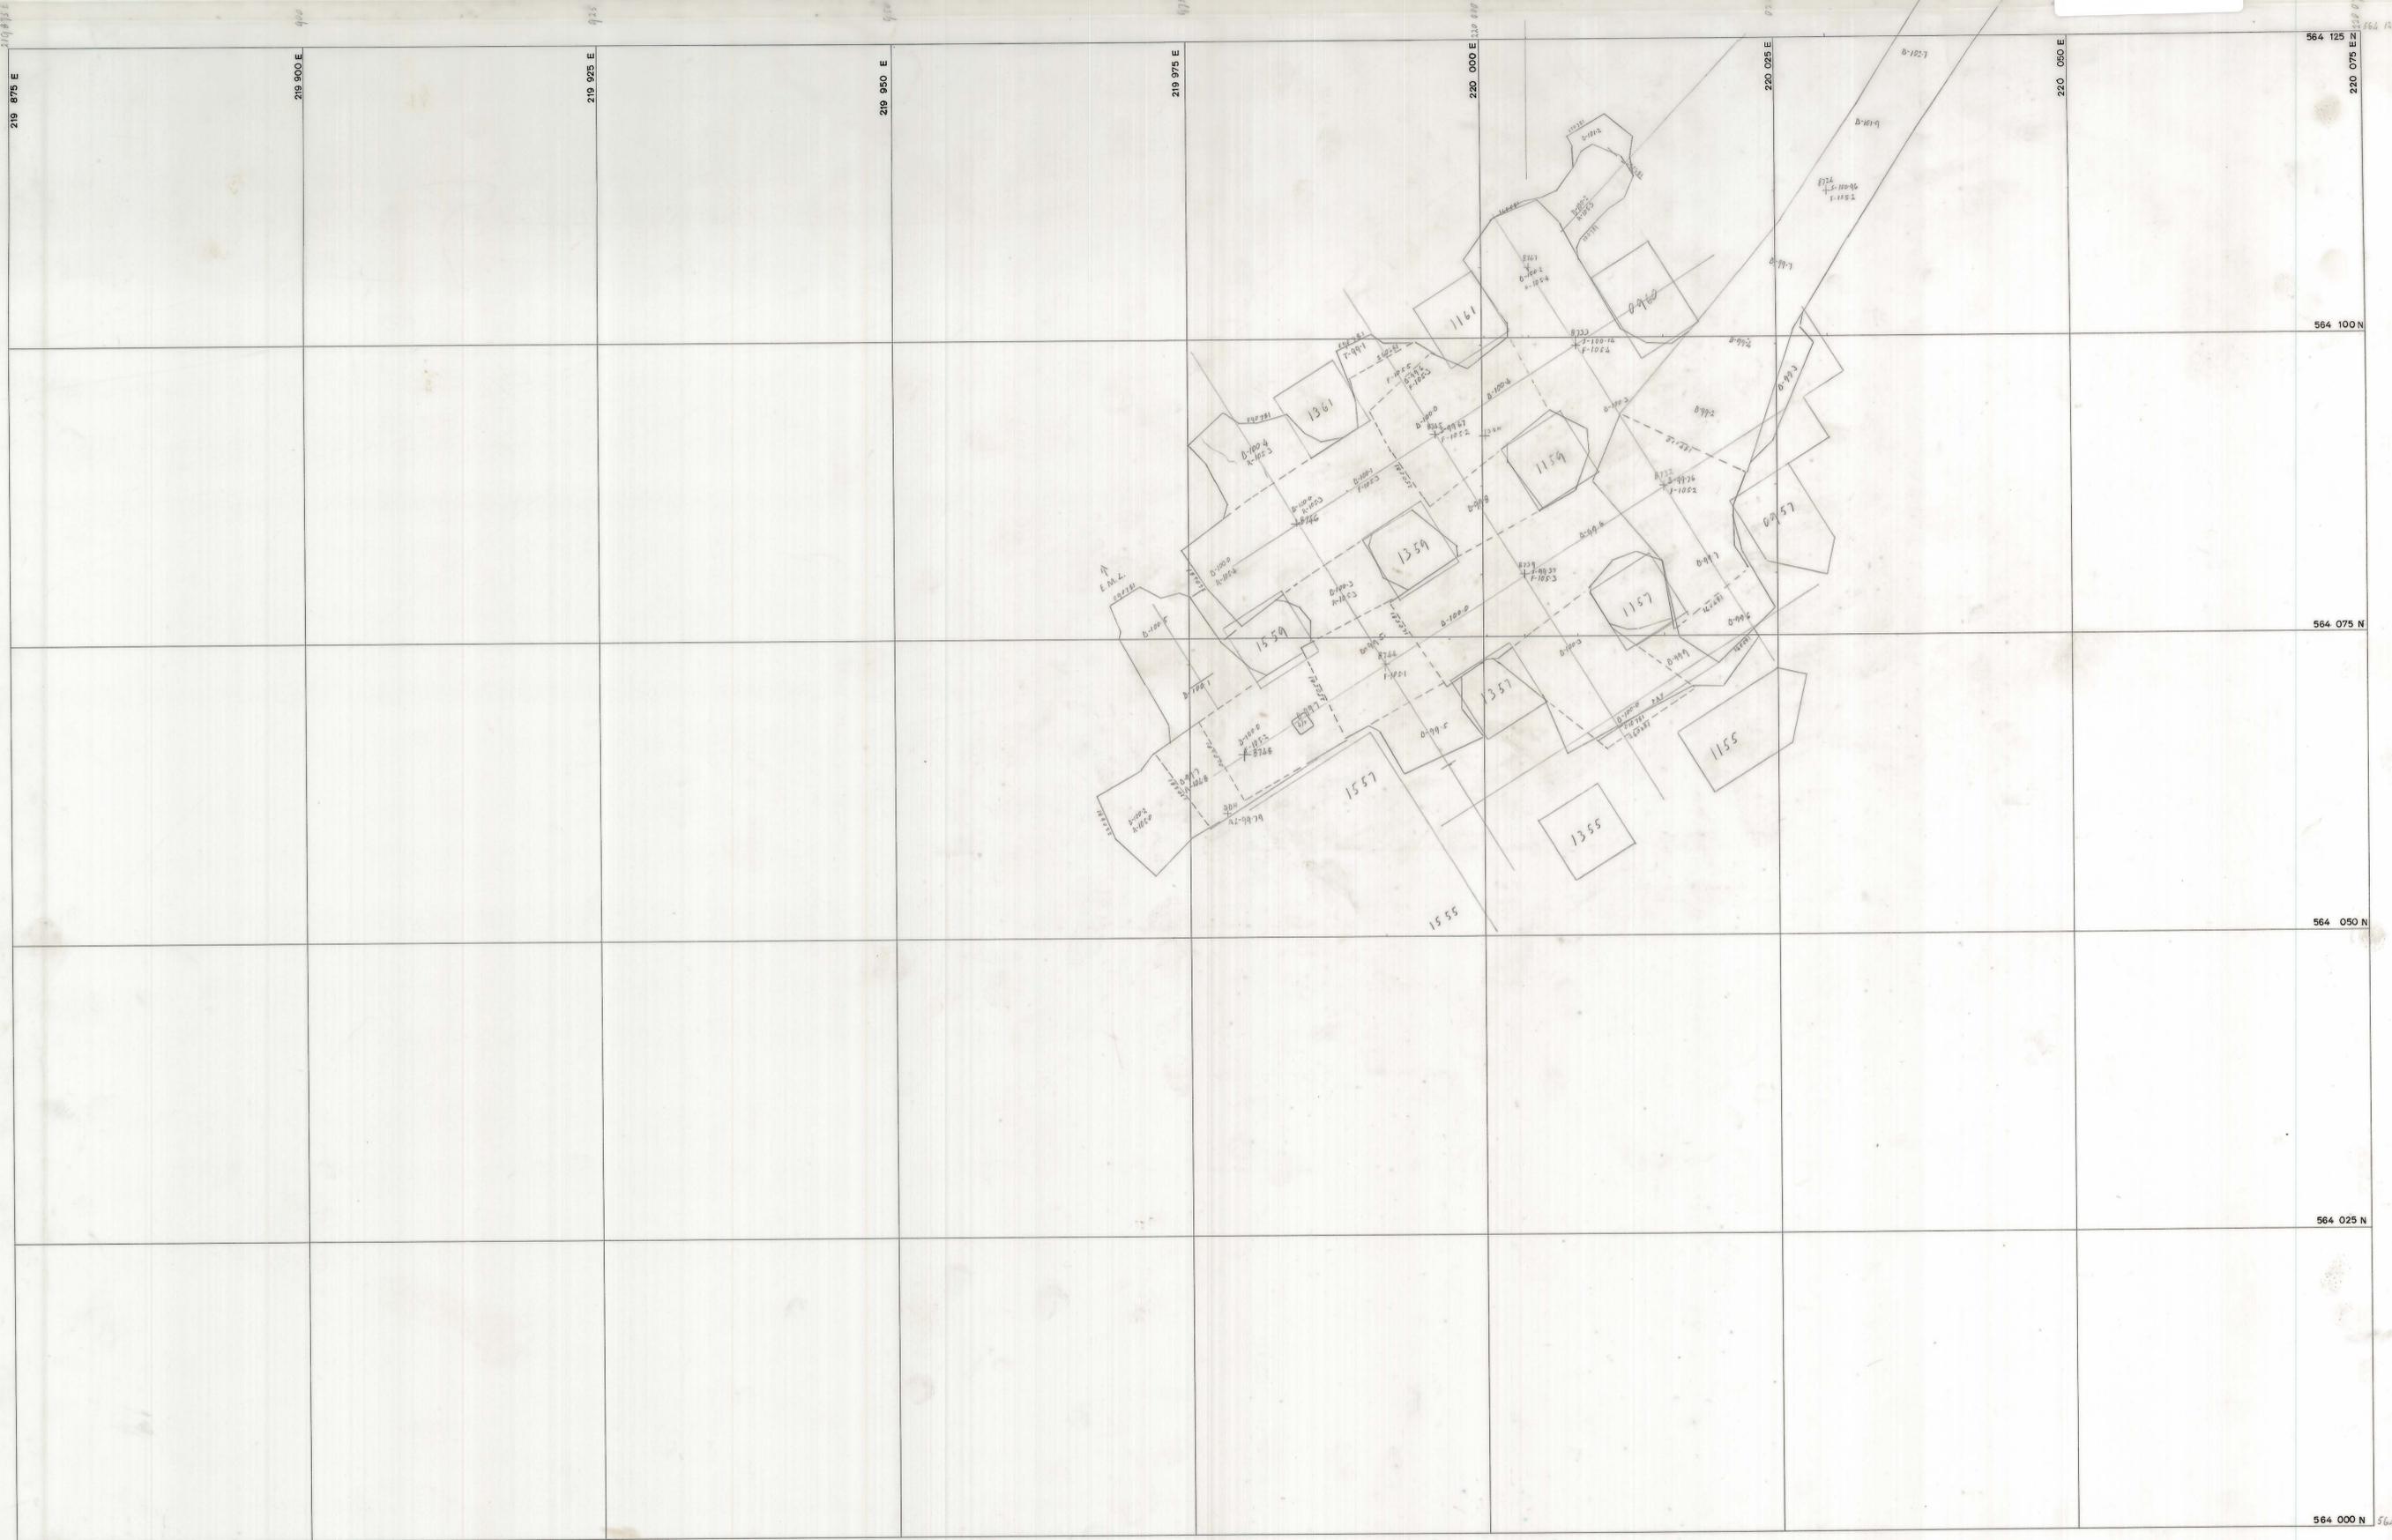


04DM13-154 105

Upper Pit  
1035

0374\_2059

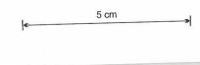

SCALE 1:

north

LOCATION

DOLPHIN MINE

SUBJECT

UPPER PIT  
-1035m contour



GRASSY KING ISLAND

PLAN NUMBER

04DM13 - 154 105