


27 JUN 1981

04 DM 13-154 106

Upper Pit
- 107

0374-2060

5 cm

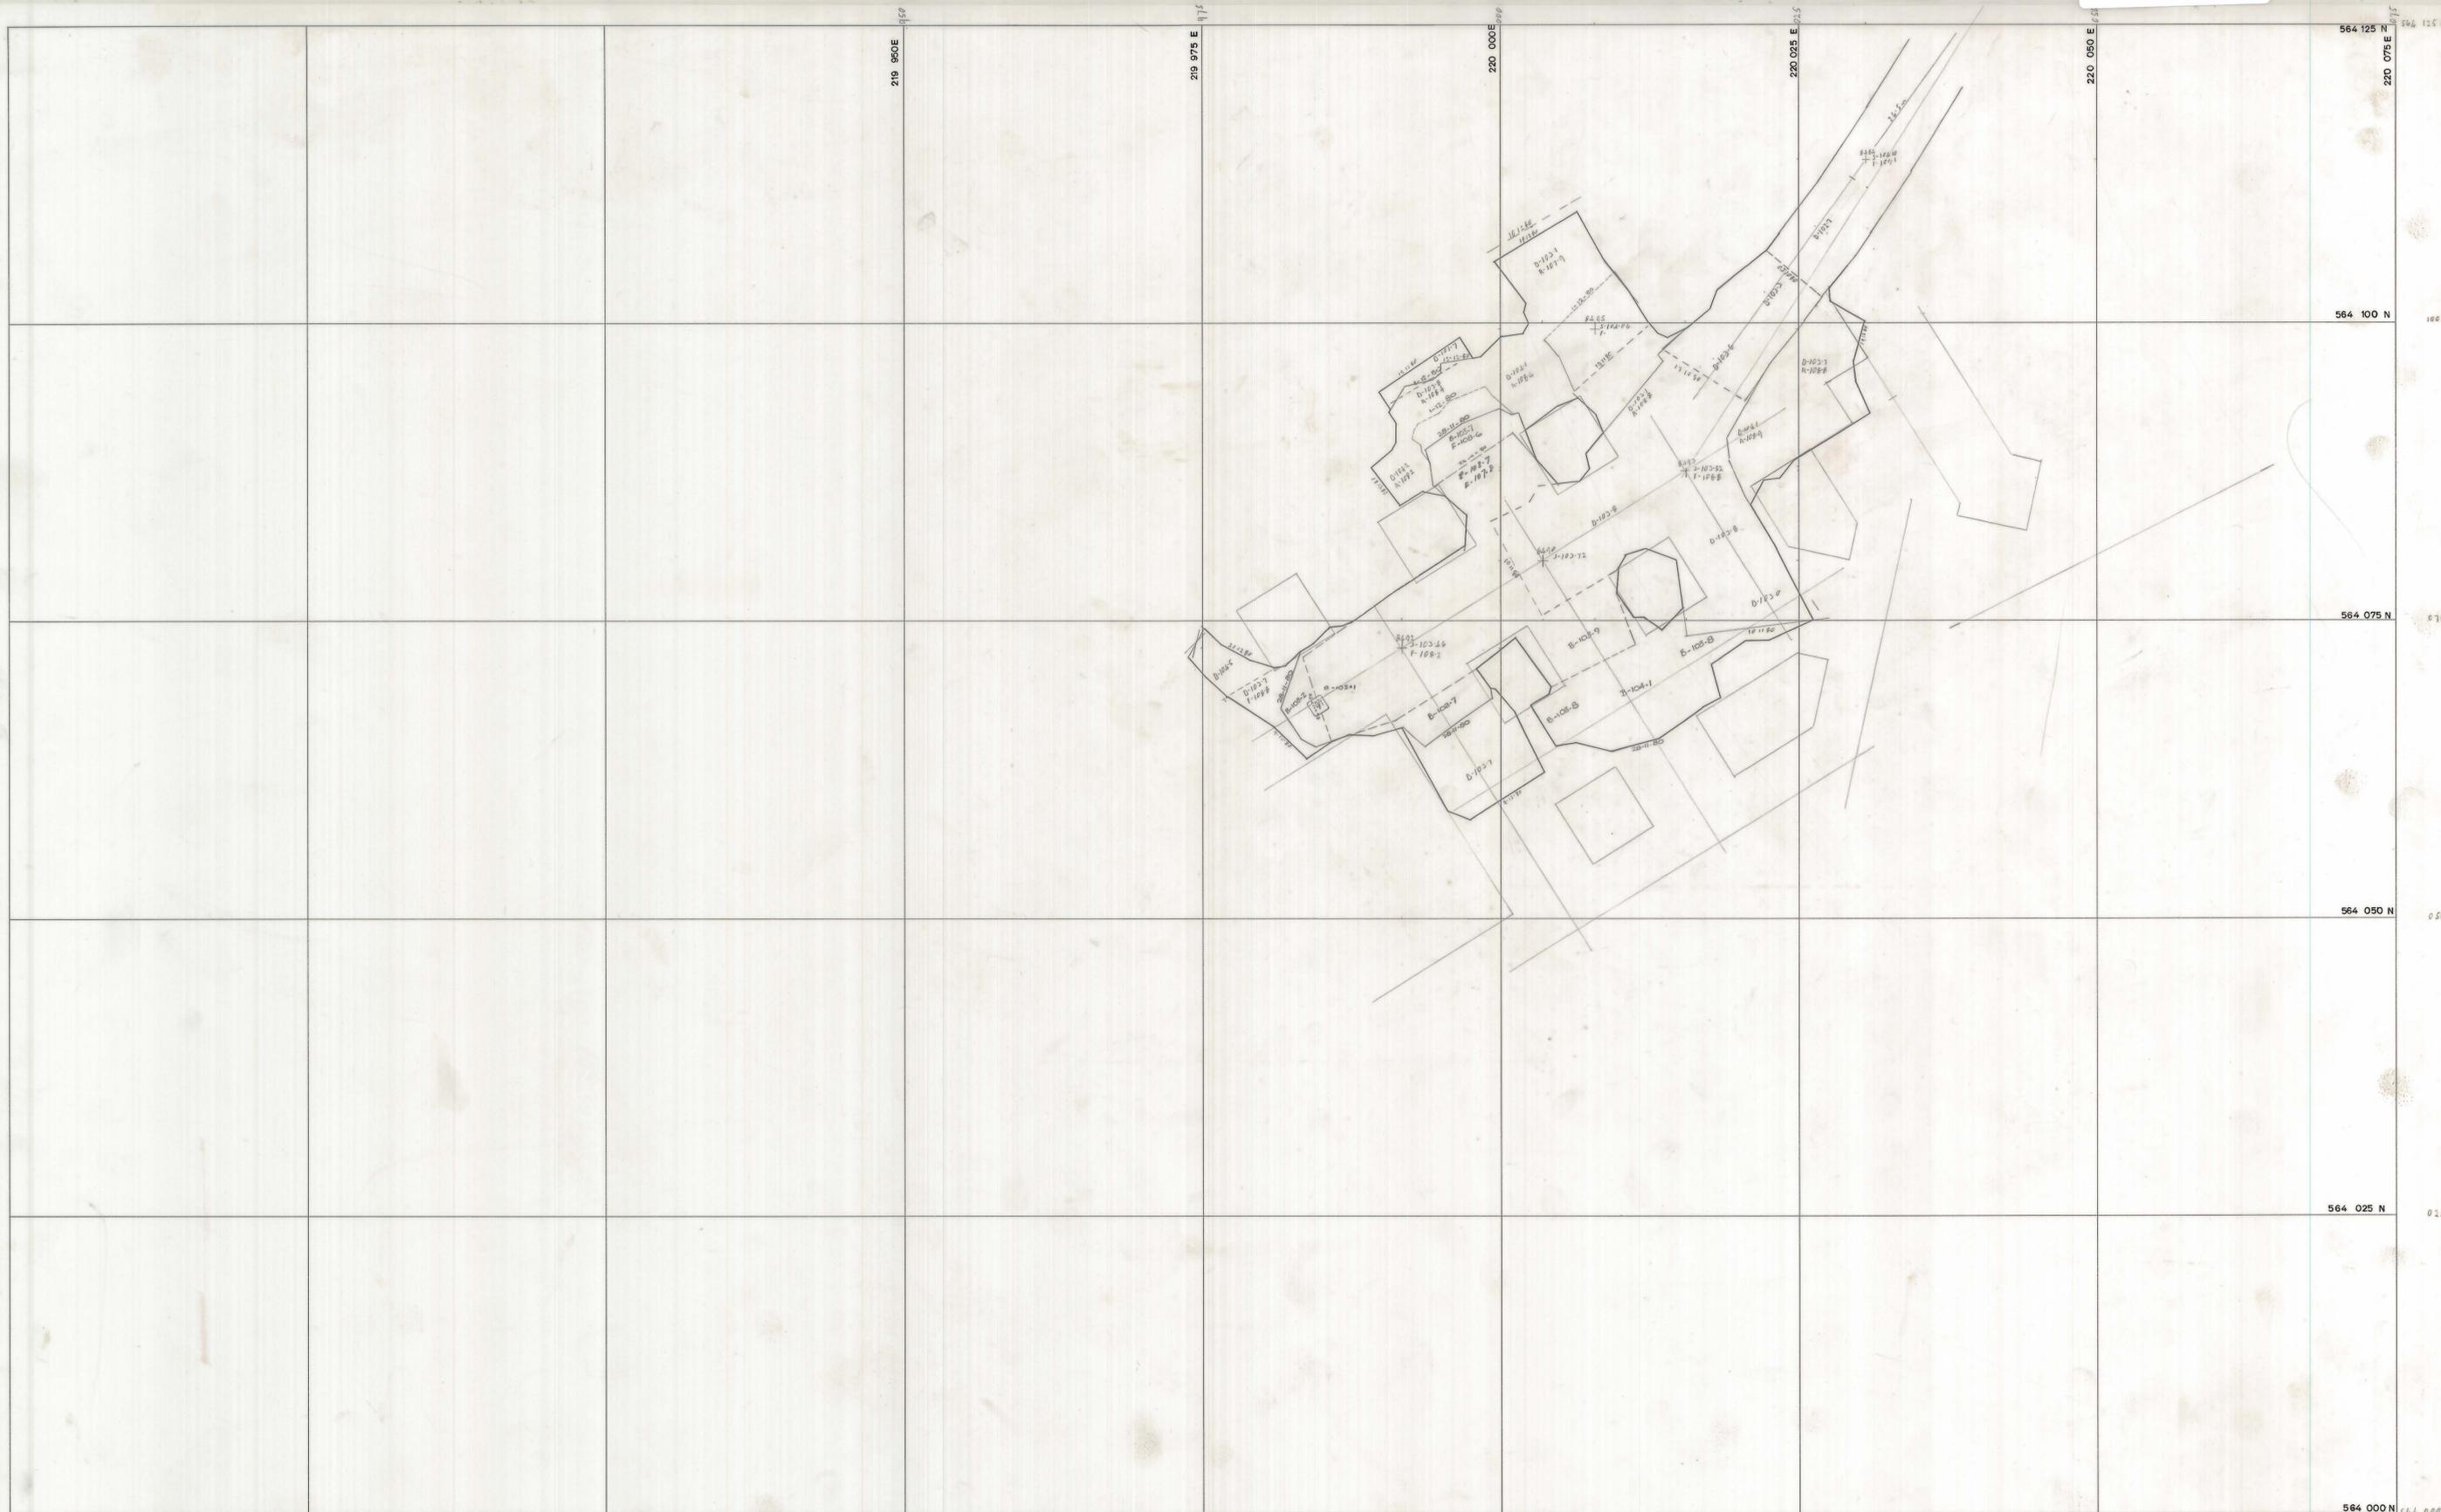

SCALE 1:

LOCATION

DOLPHIN MINE

SUBJECT

UPPER PIT
-107m contour

north

KING ISLAND SCHEELITE
A DIVISION OF WARRAN INTERNATIONAL

GRASSY KING ISLAND

PLAN NUMBER
04DM13 - 154 106