


O4DM15 - 155 104

179  
Upper Central  
1:9 12

0374-2061

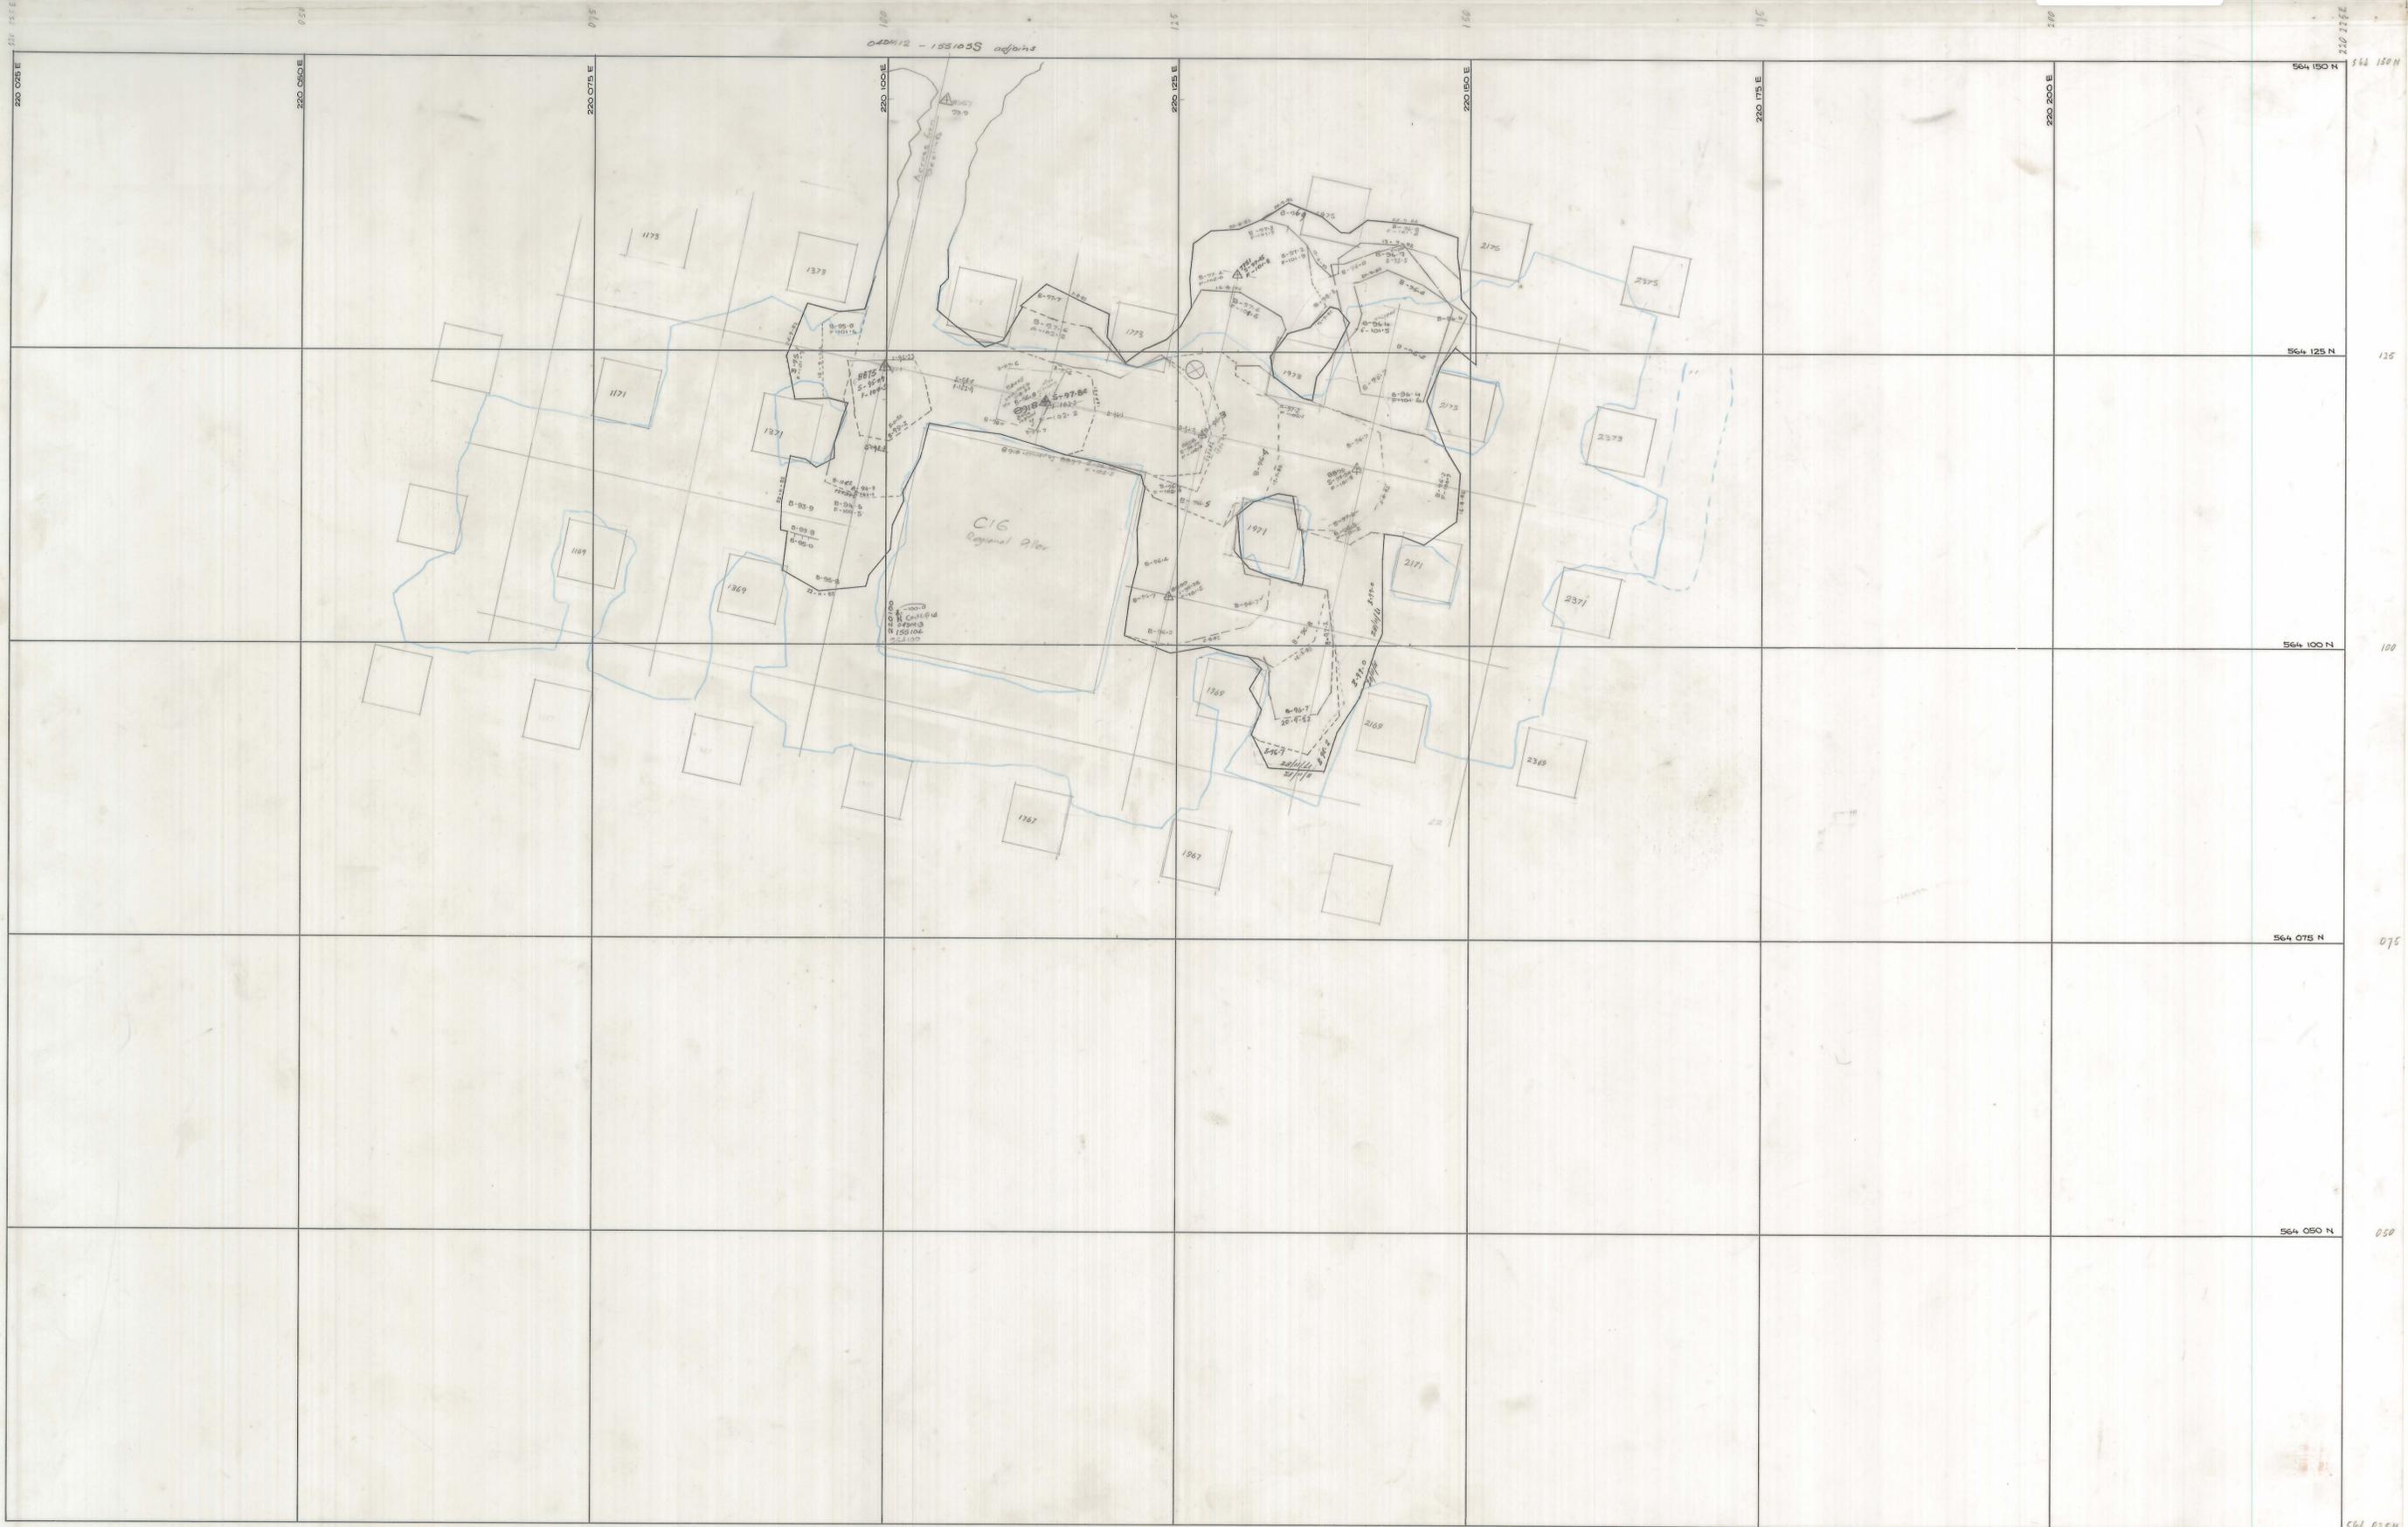

	<p>SCALE 1: 250</p>	<p>North</p>	<p>LOCATION DOLPHIN MINE</p> <p>SUBJECT CENTRAL STOPE - 100 m Contour lift 14</p>	<p>KING ISLAND SCHEELITE A DIVISION OF WARMAN INTERNATIONAL</p> <p>GRASSY KING ISLAND</p> <p>PLAN NUMBER O4DM15 - 155 104</p>
--	---------------------	--------------	---	---