

27 JUN 1981


5 cm

04DM13-154 115

C PIT

137

0374-2073

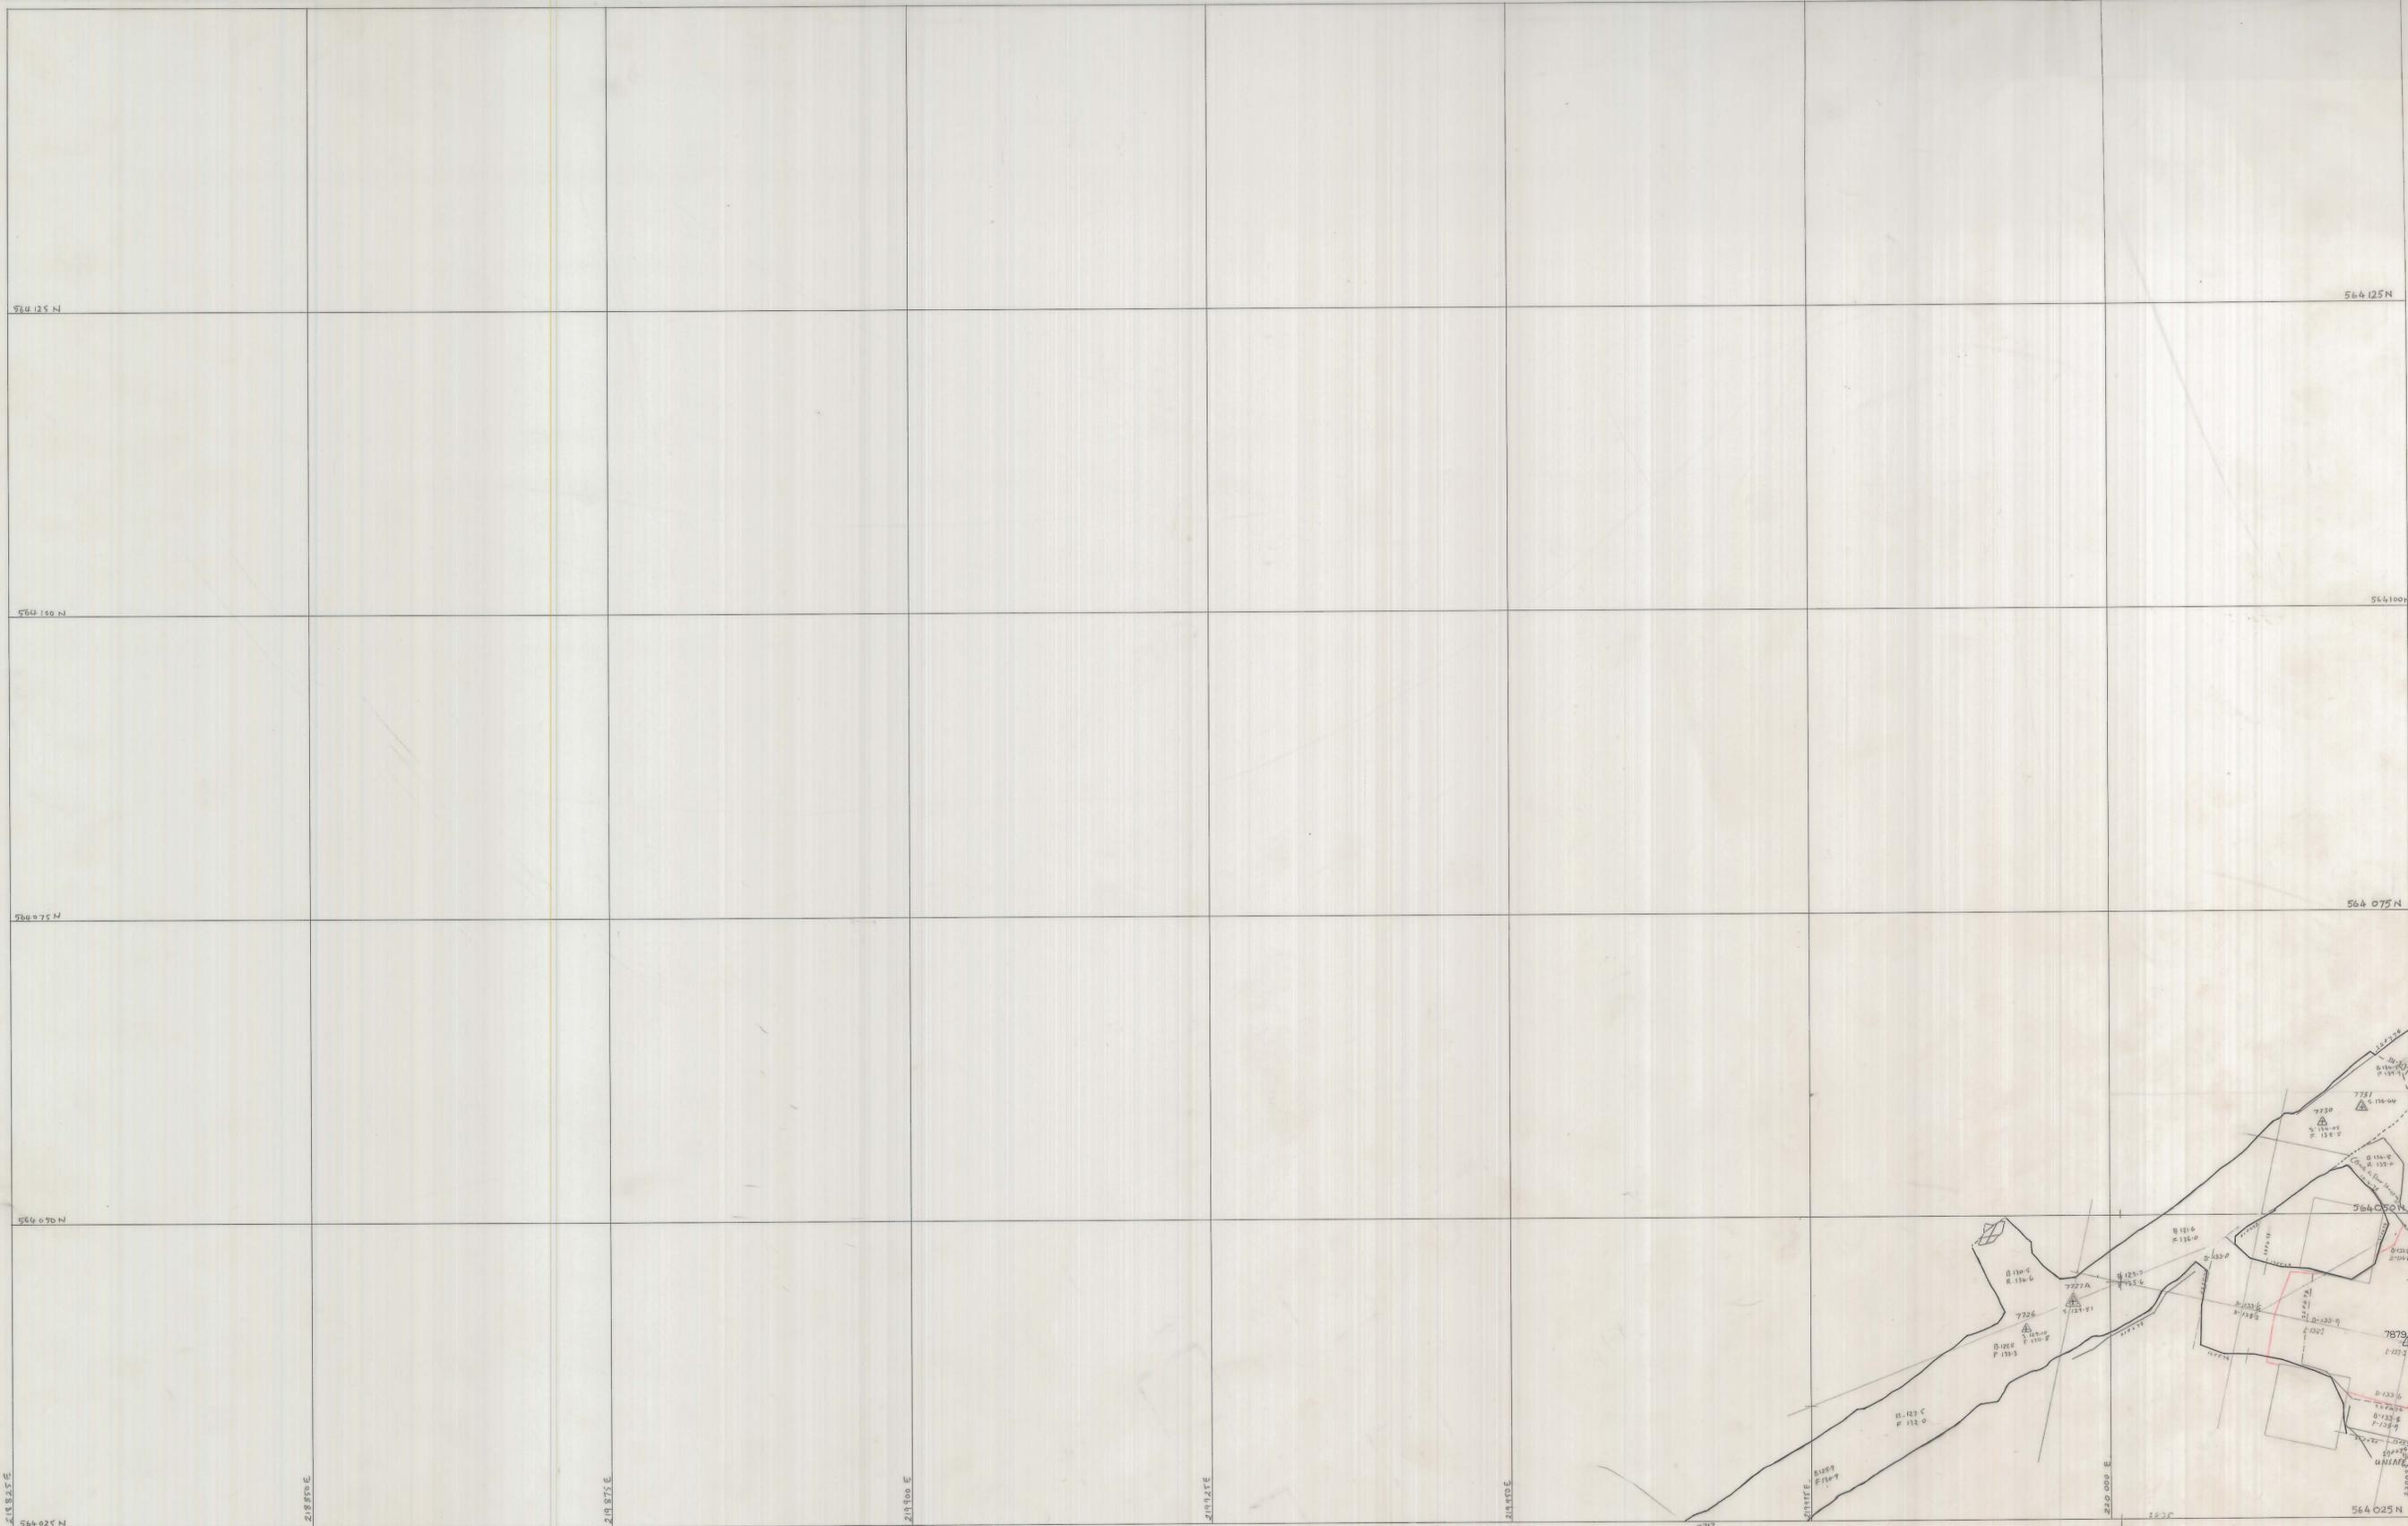

SCALE 1:250

(INFORMATION TAKEN FROM PLAN N° 04DM12-1003)

LOCATION J16 DOLPHIN MINE

SUBJECT C PIT STOPE
-137m CONTOUR

north

KIS KING ISLAND SCHEELITE
A DIVISION OF WARMAN INTERNATIONAL

GRASSY KING ISLAND

PLAN NUMBER 04DM13-154 115