


5 cm

27 JUN 1981

04DM12 - 145 137 S

M 9

0374-2082

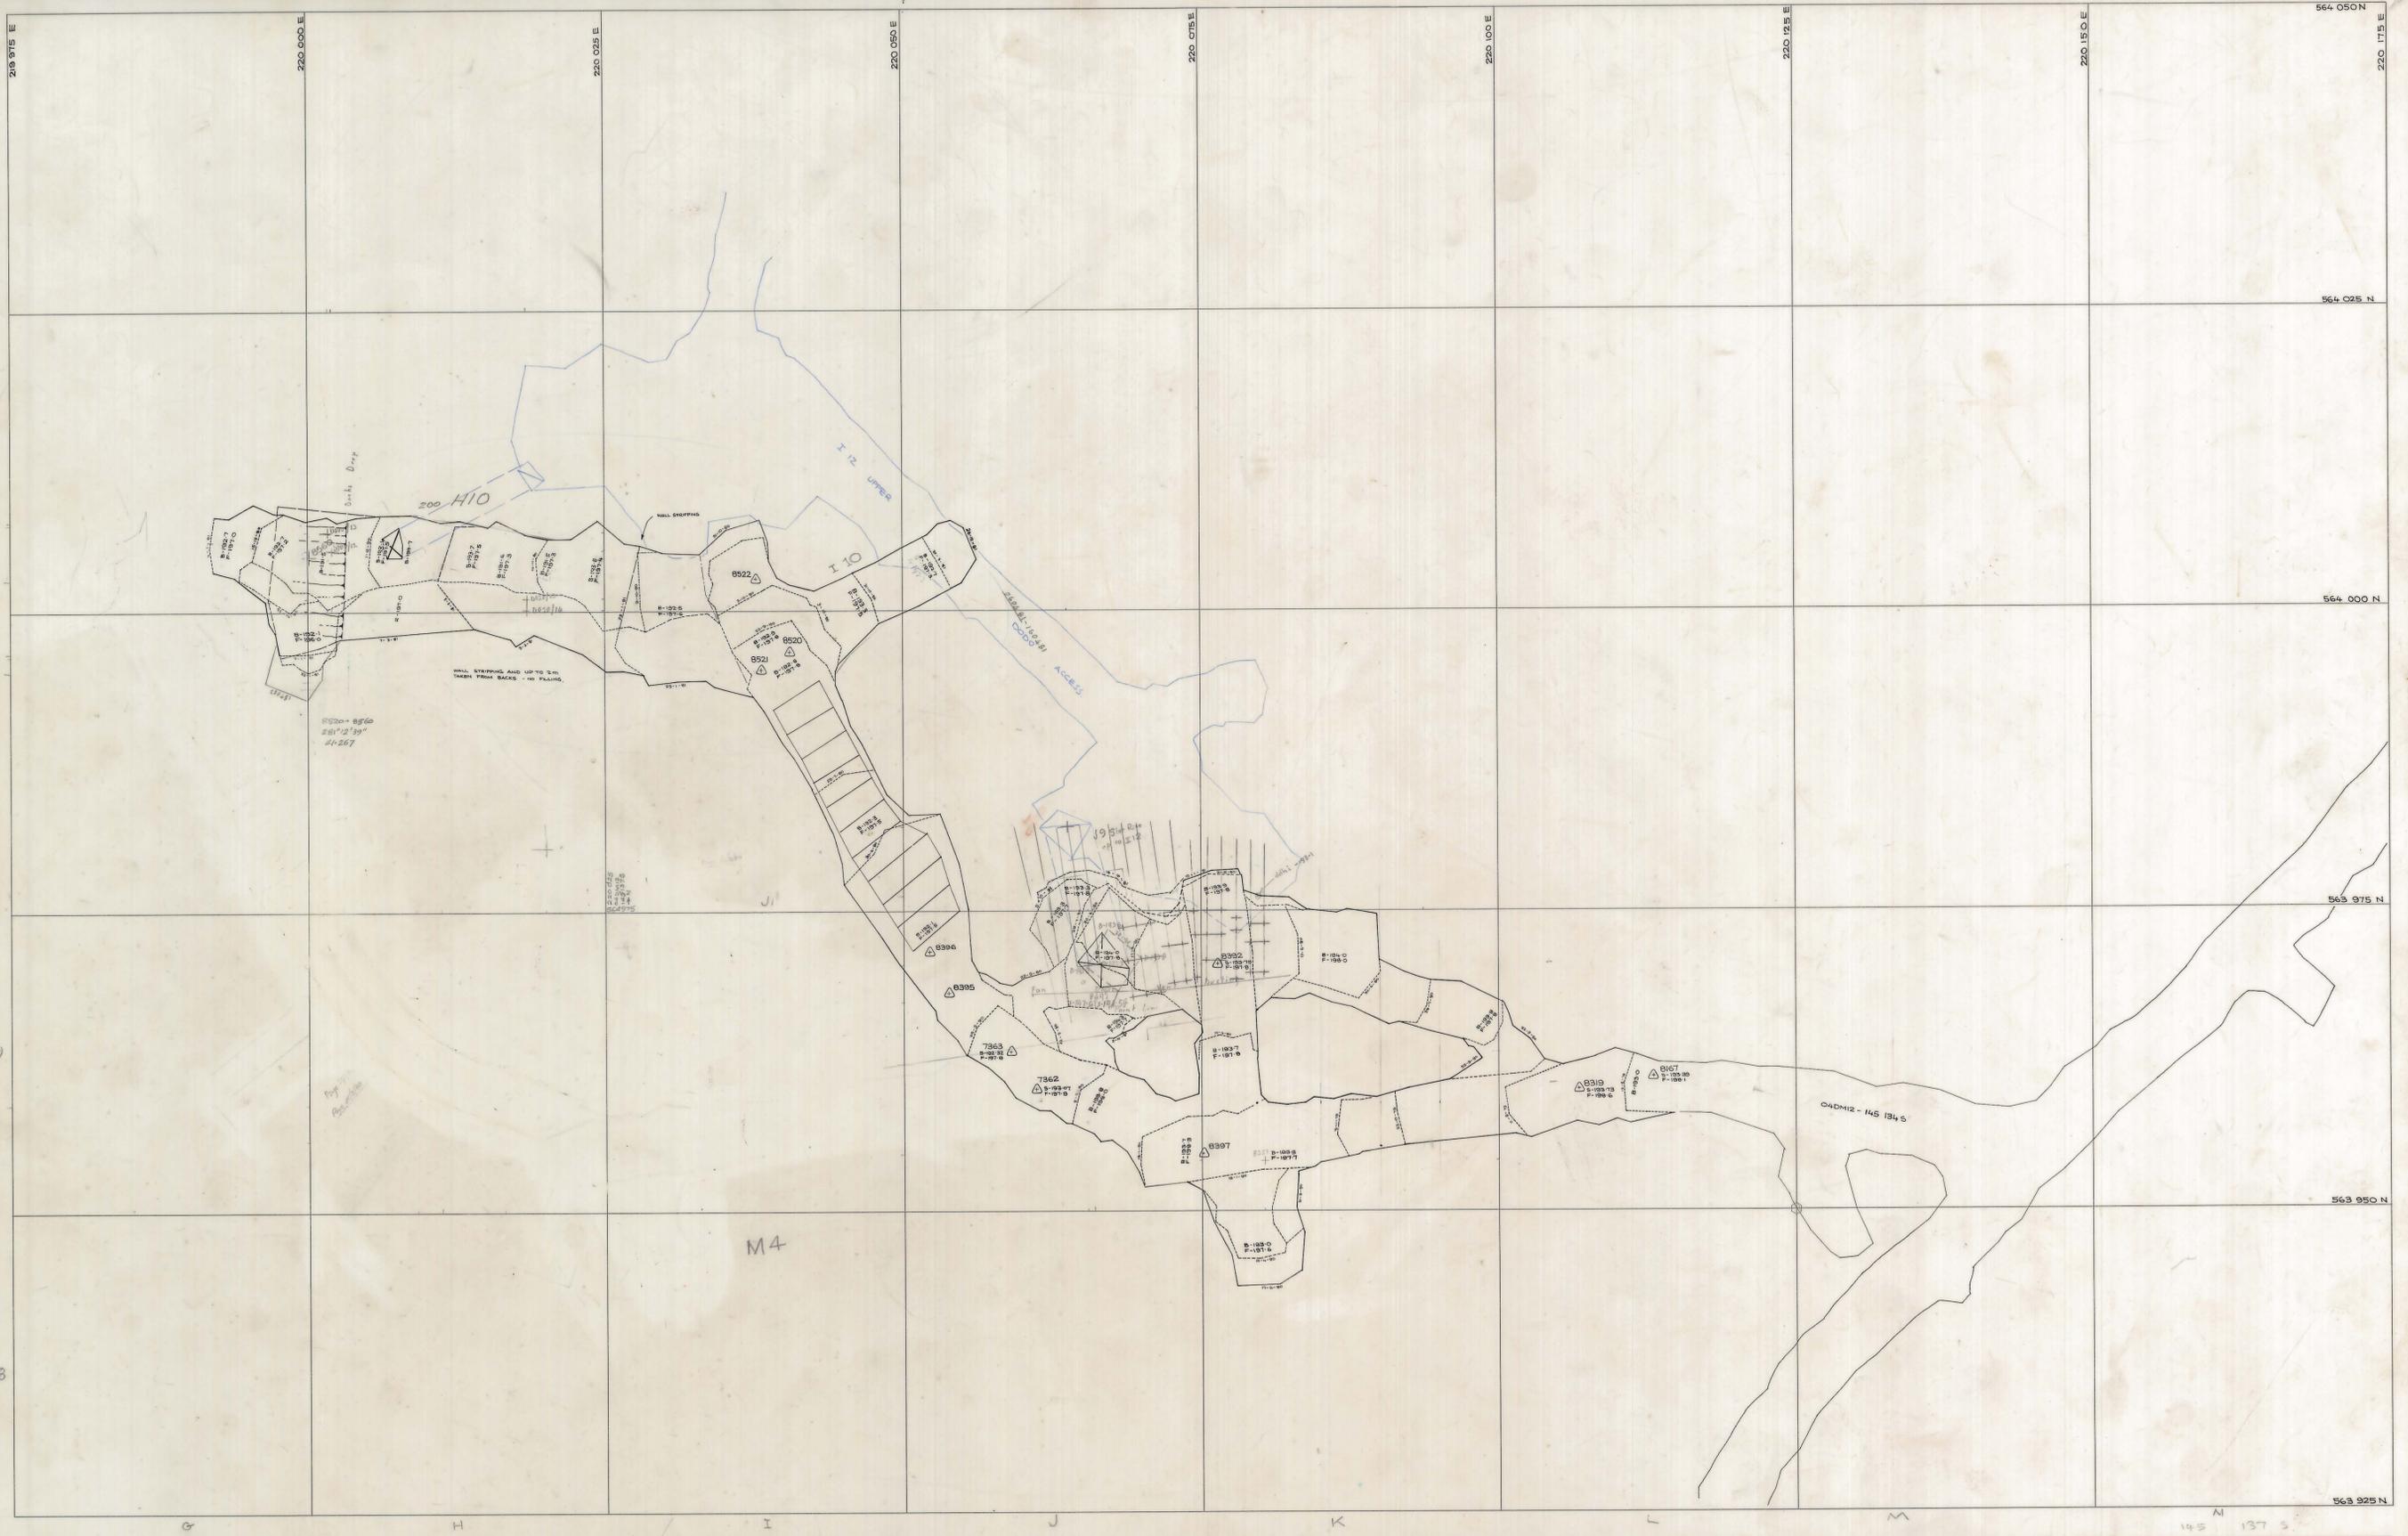

M4

SCALE 1:250

M9 design drawing 03DM02-1013 superseded
03 DM07-3011 ?

LOCATION

DOLPHIN MINE

SUBJECT

M 9
LOWER PIT DAG ACCESS

north



GRASSY KING ISLAND

PLAN NUMBER

04DM12 - 145 137 S