


04DM12-155142 -225 ZONE DEVELOPMENT

0374-2083

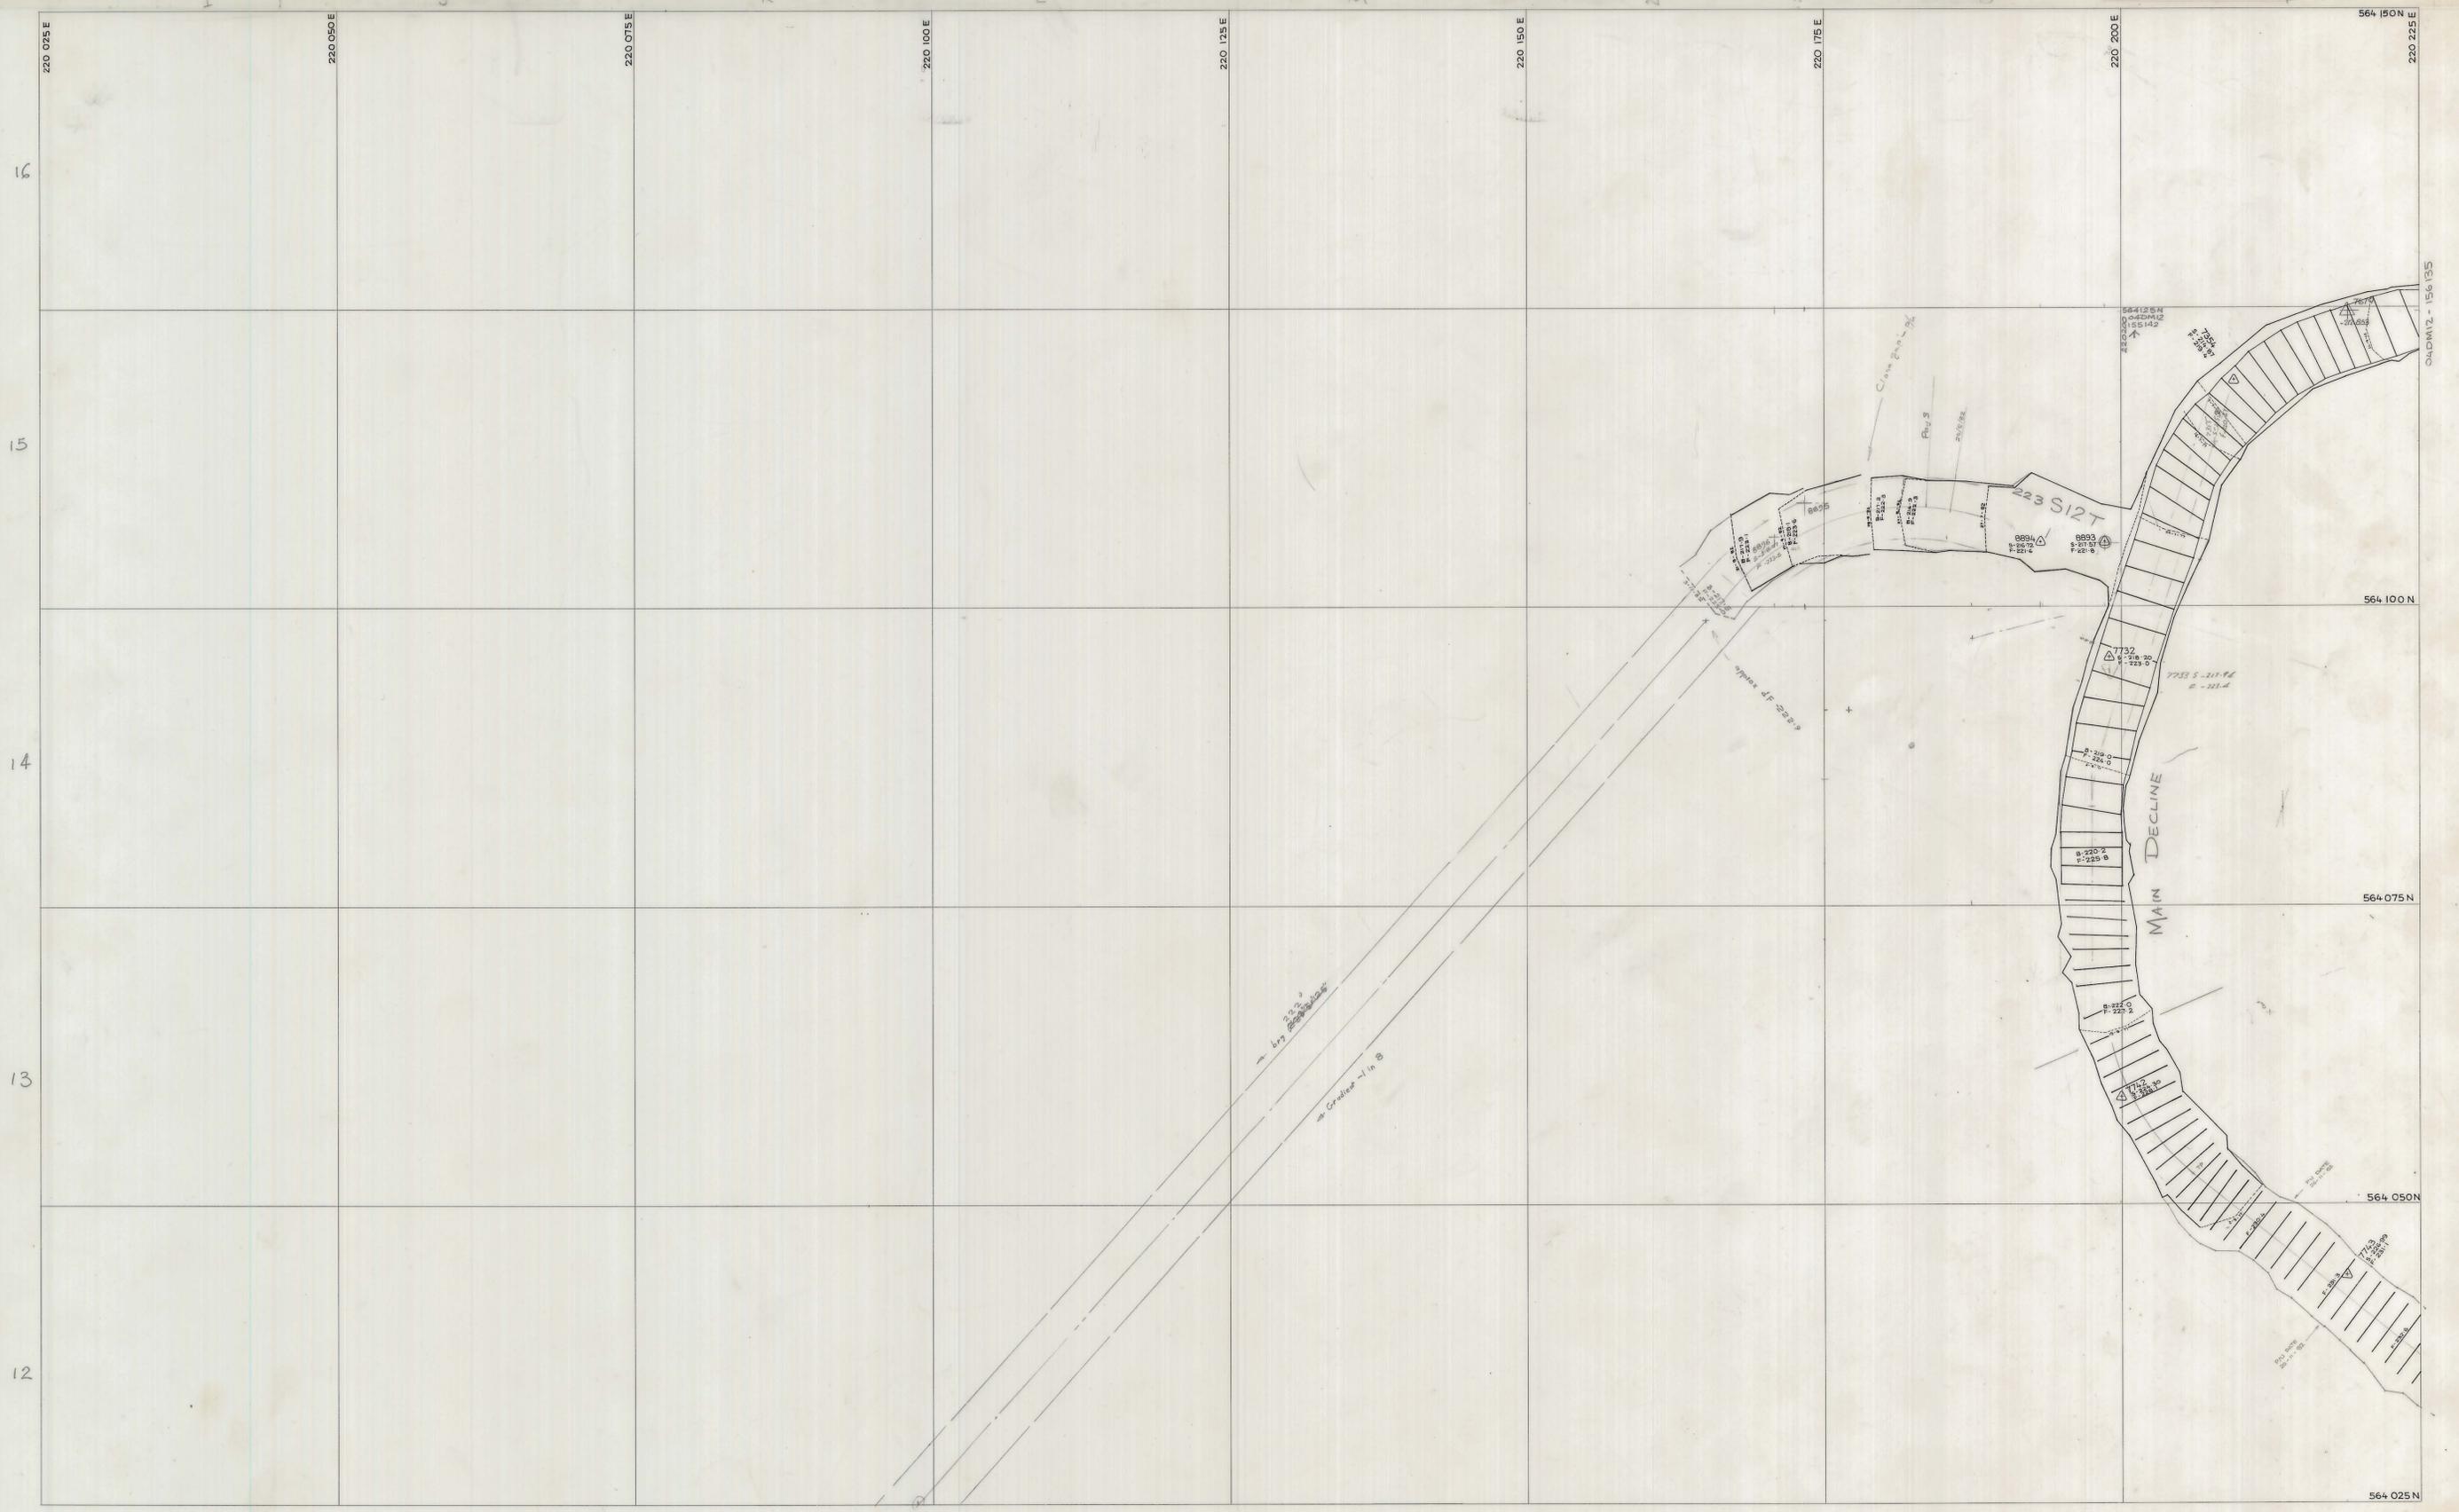

<p>Reference 1:50 Scale 888011-102126 1:50 Scale 888012-102127 223 S12T design drawing 0374-2083-1027</p>	<p>SCALE 1 : 250</p>	<p>north</p>	<p>LOCATION DOLPHIN MINE</p> <p>SUBJECT - 225 ZONE DEVELOPMENT</p>	<p>KIS KING ISLAND SCHEELITE A DIVISION OF WARMAN INTERNATIONAL</p> <p>GRASSY KING ISLAND</p> <p>PLAN NUMBER 55 142 04DM12 - 1</p>
--	----------------------	--------------	--	--