


0374-210

04BH15-104

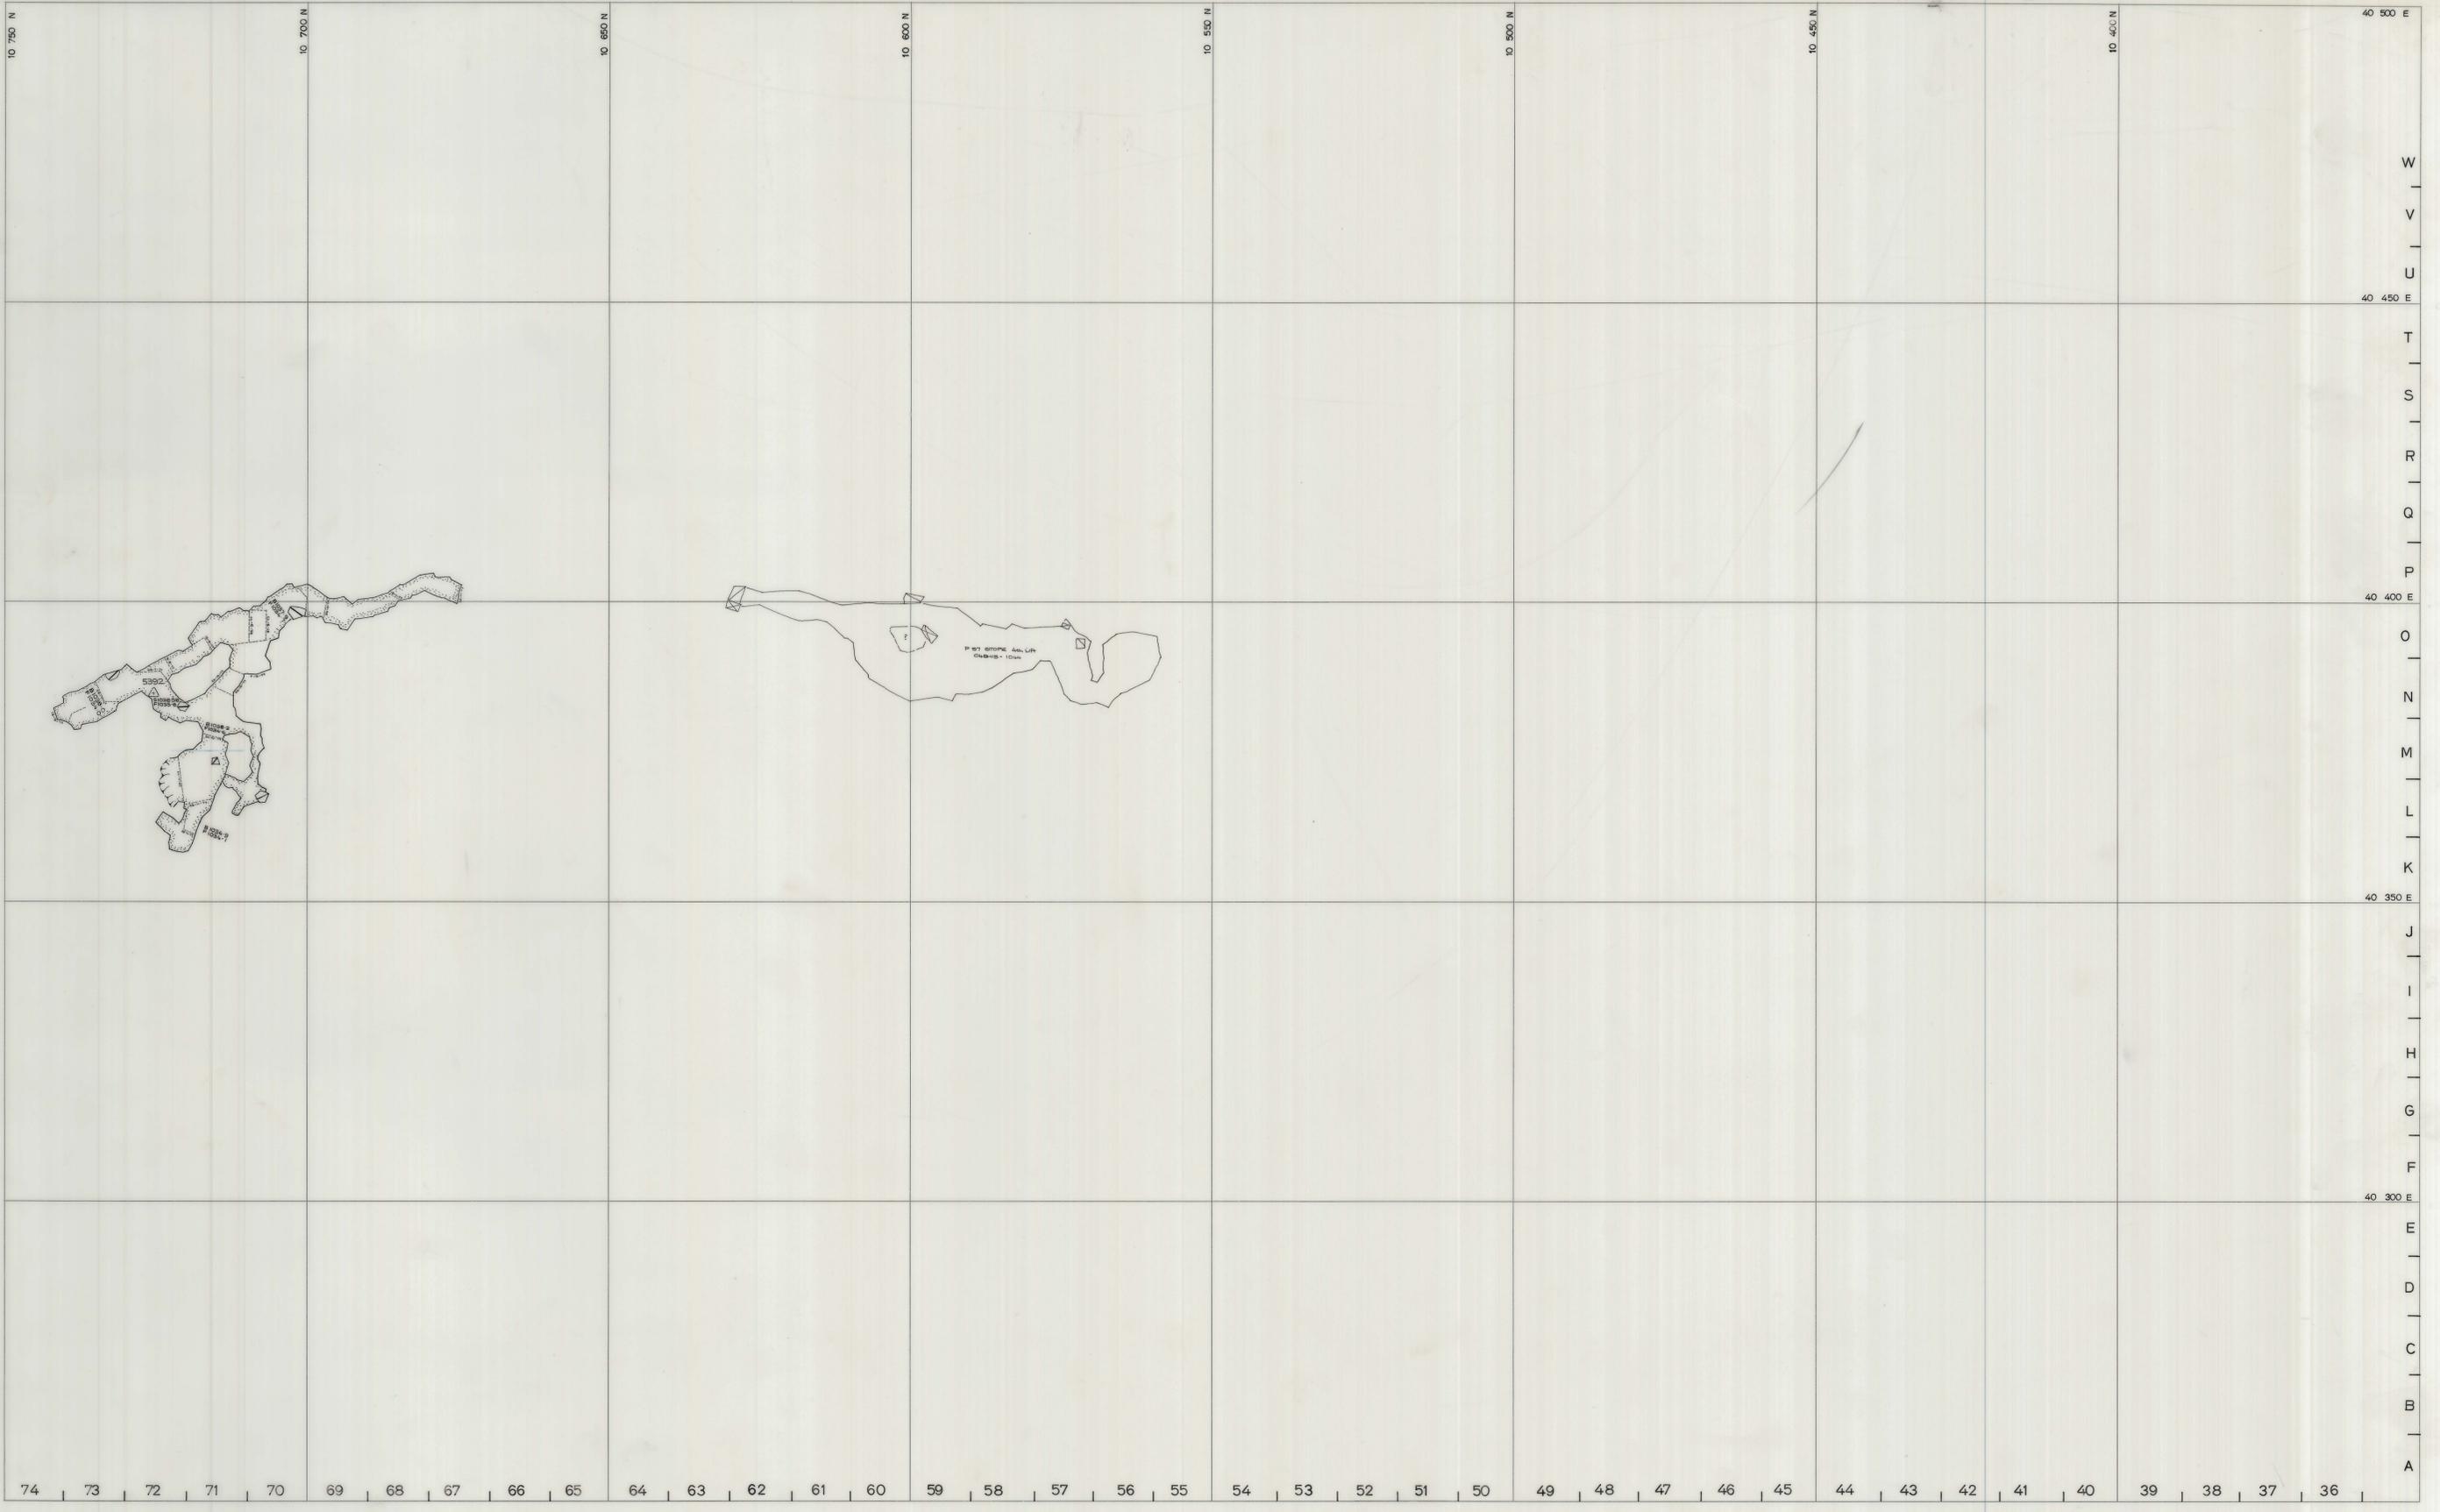

	<p>SCALE 1:500</p> <p>5 cm</p> <p>north</p>	<p>LOCATION BOLD HEAD MINE</p> <p>SUBJECT P 70 STOPE B LENS MAIN</p>	<p>KIS KING ISLAND SCHEELITE A DIVISION OF WARMAN INTERNATIONAL</p> <p>GRASSY KING ISLAND</p> <p>PLAN NUMBER 04BH15-104</p>
--	---	--	--