


04DM12 - 136 159

0374-2101

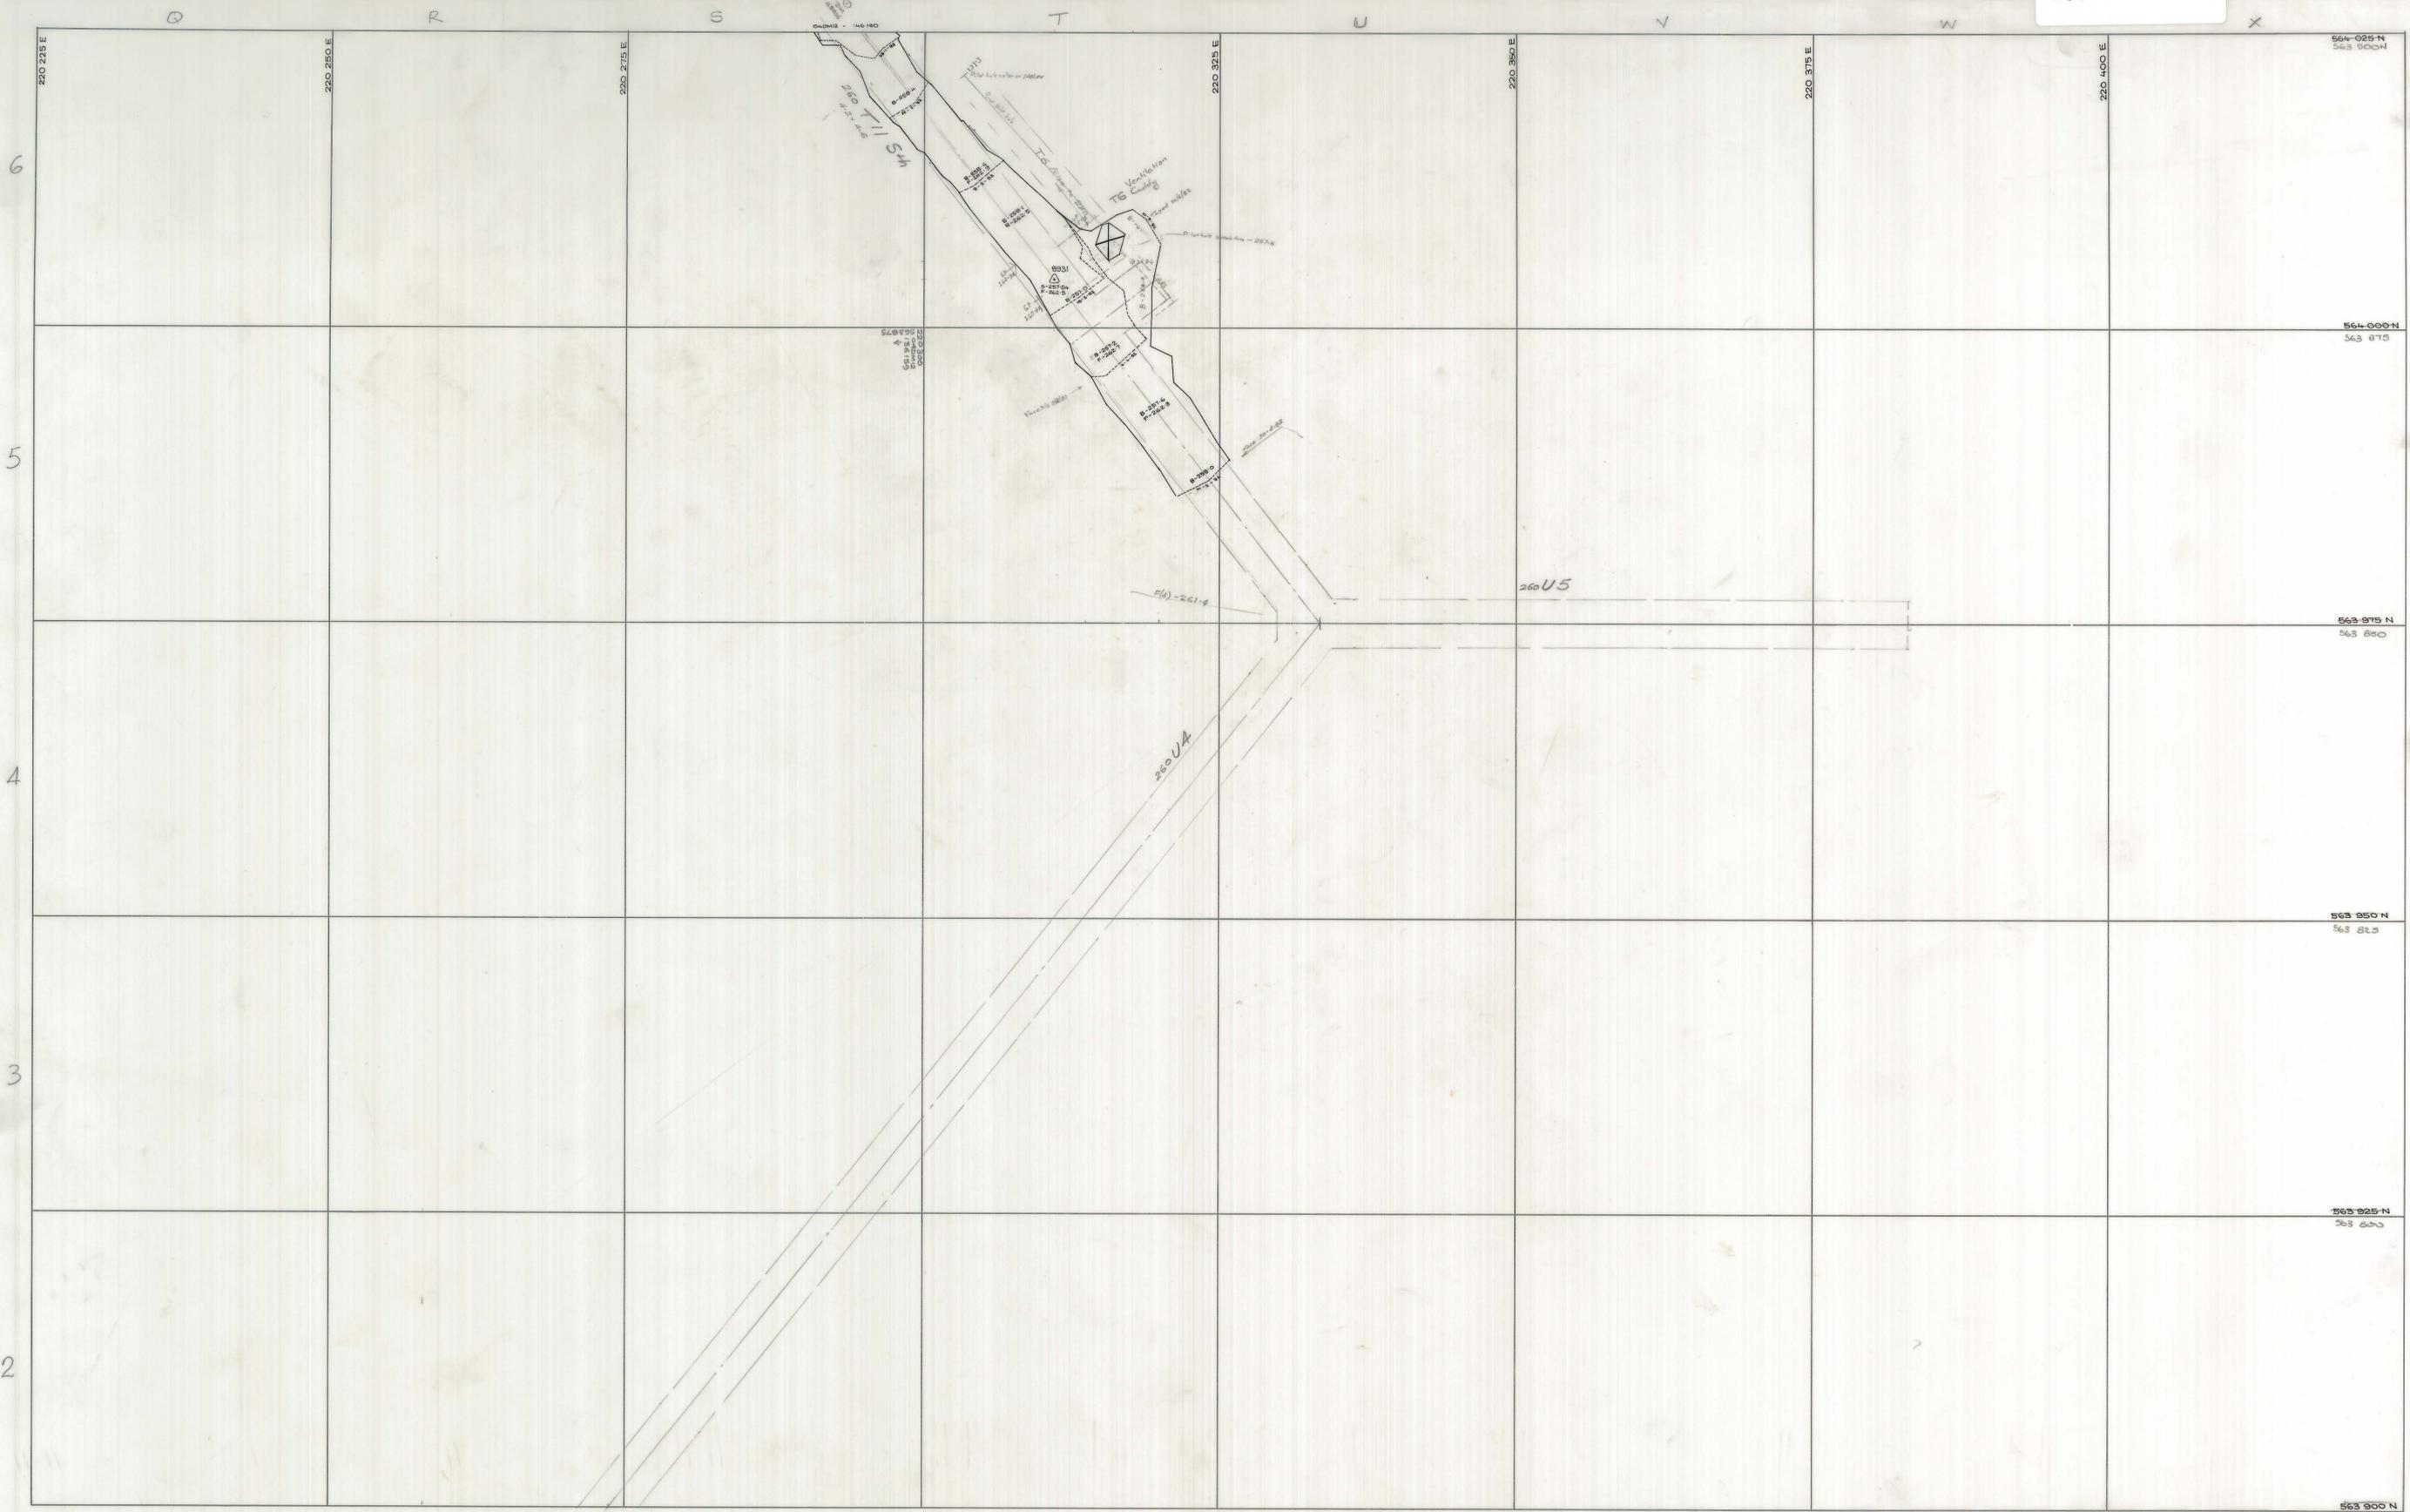

SCALE 1: 250

Design plan 03DM05-1002, 03DM05-3013  
T1/S4, Calc Sit 155  
T1/S4, Plan Plan 524



north

LOCATION

DOLPHIN MINE

SUBJECT

T8 DRILL DRIVE

**KIS** KING ISLAND SCHEELITE  
A DIVISION OF WARMAN INTERNATIONAL

GRASSY KING ISLAND

PLAN NUMBER

04DM12 - 136 159