




0374-2104



SCALE 1: 250

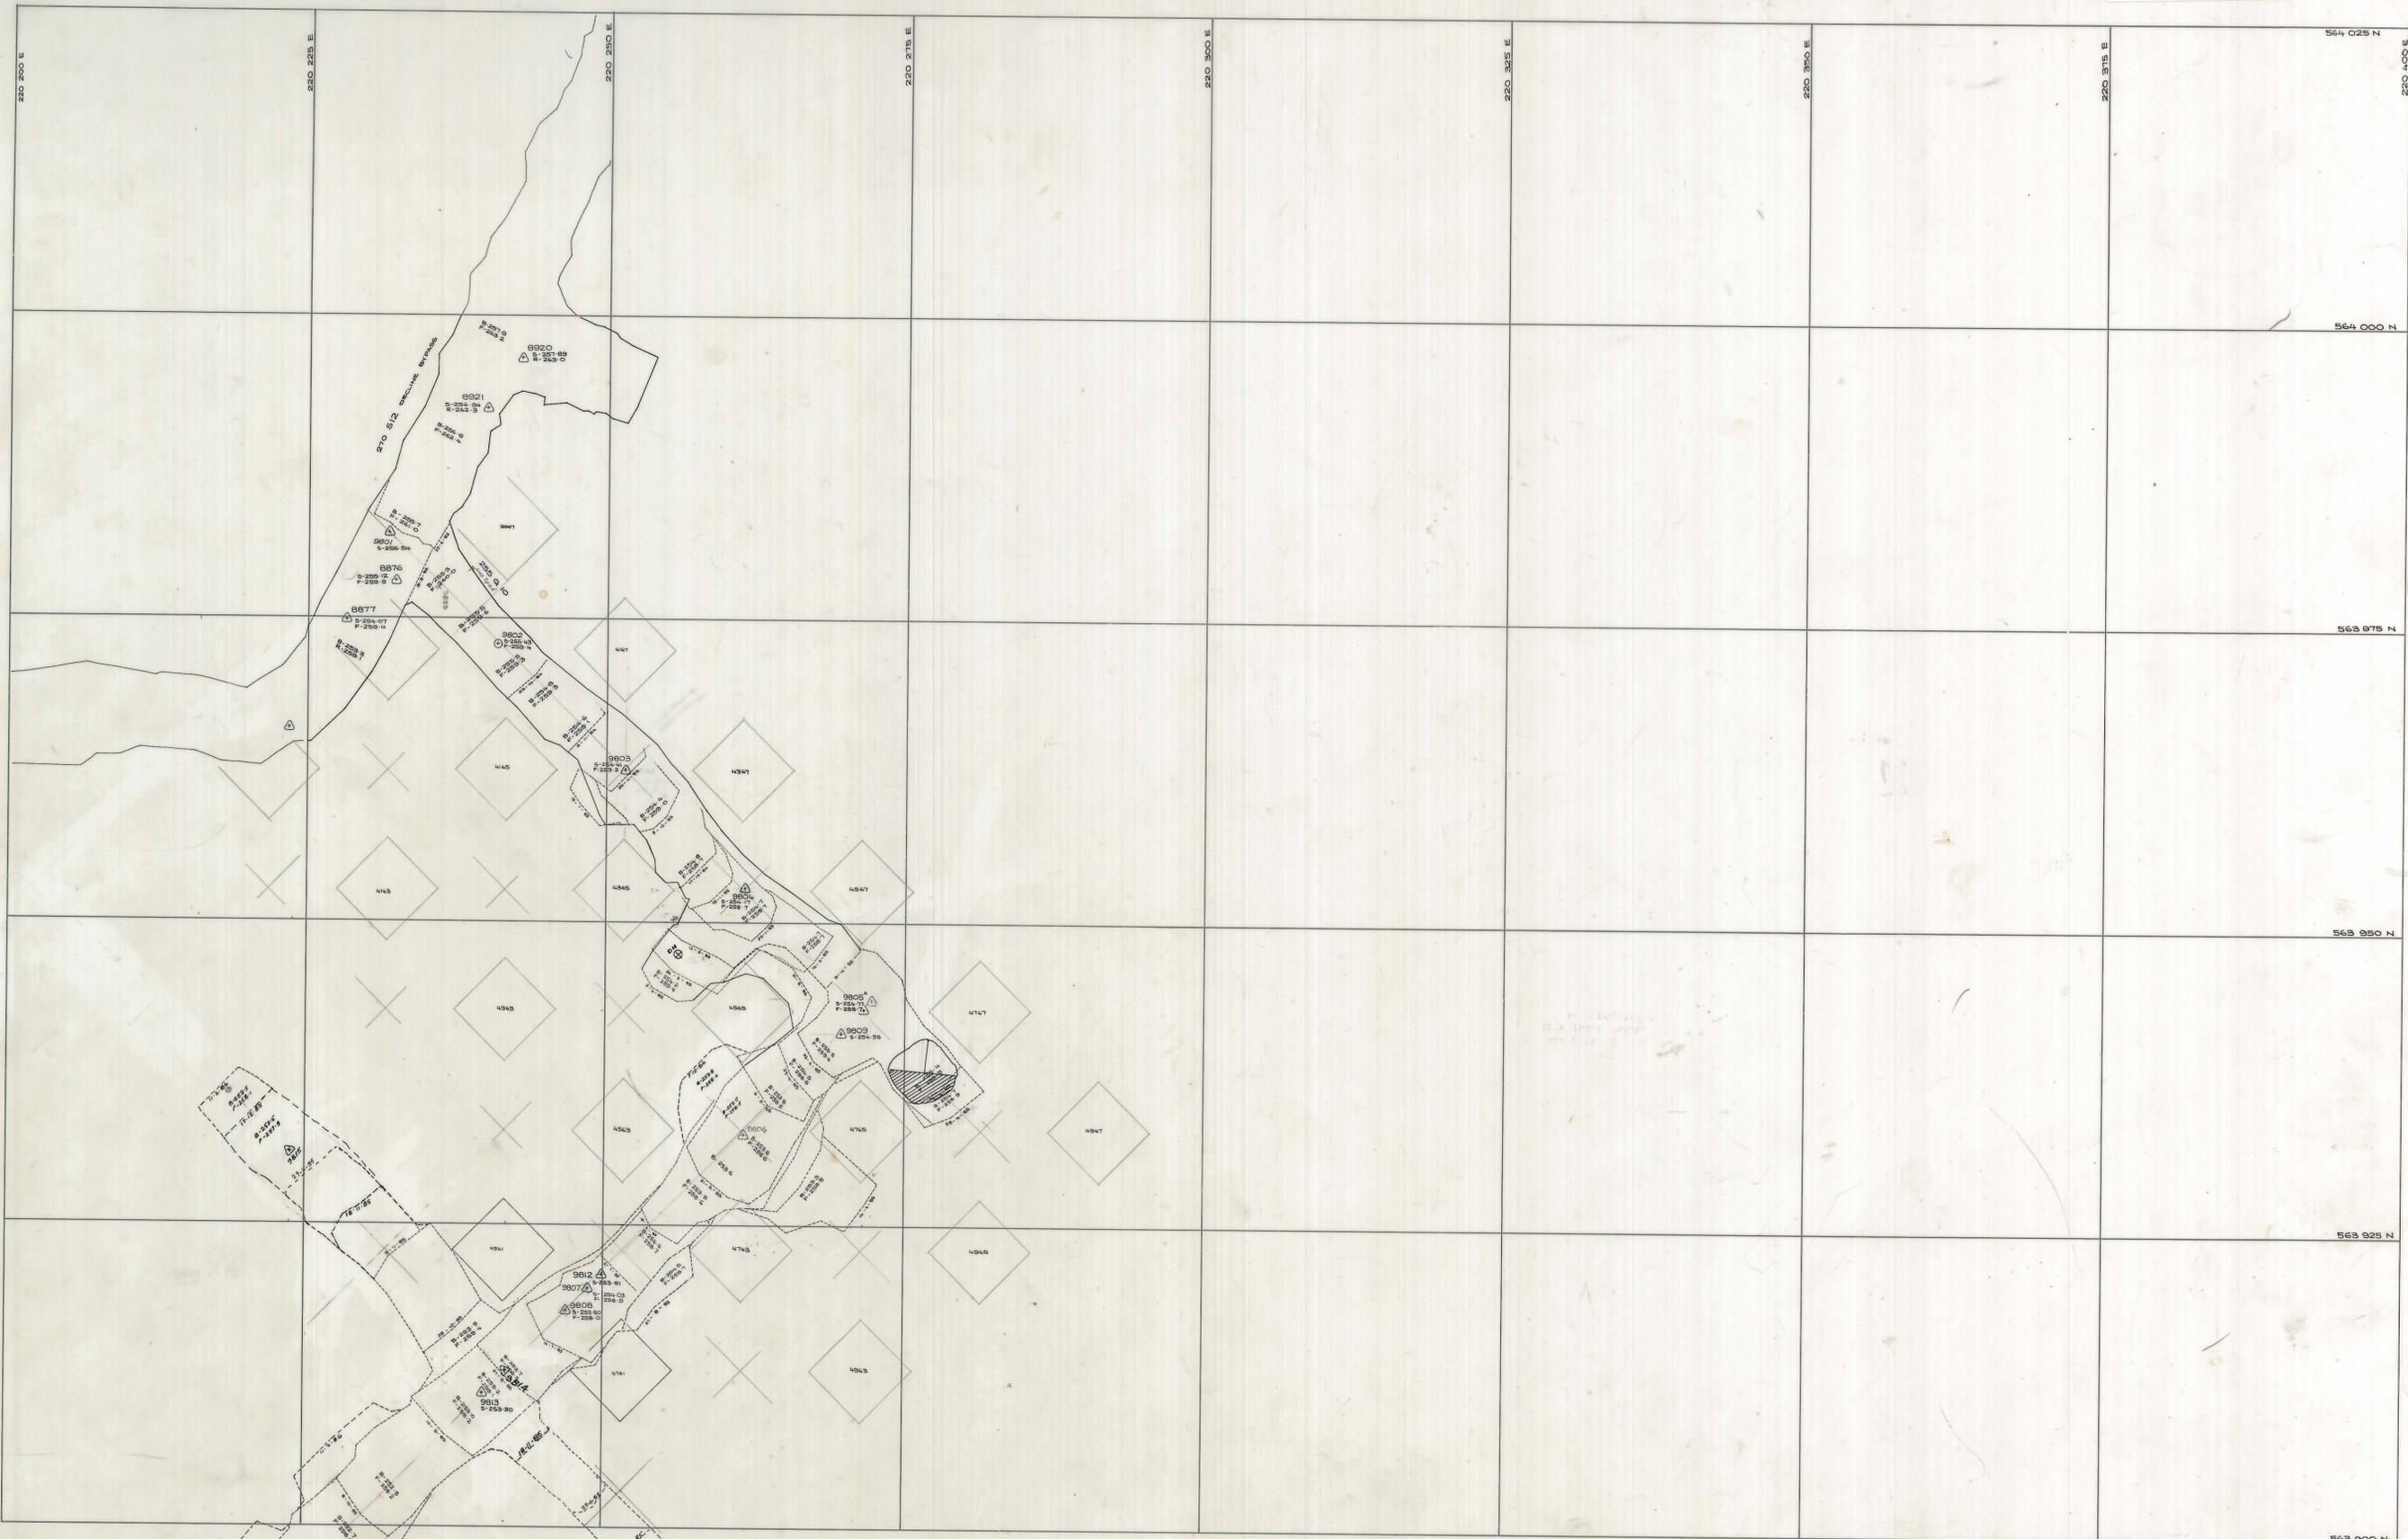

LOCATION DOLPHIN MINE

SUBJECT LOWER CENTRAL STOPE



GRASSY KING ISLAND

PLAN NUMBER 04DM13 - 146 154