


0374-2107

930  
Upper Pit  
147 17

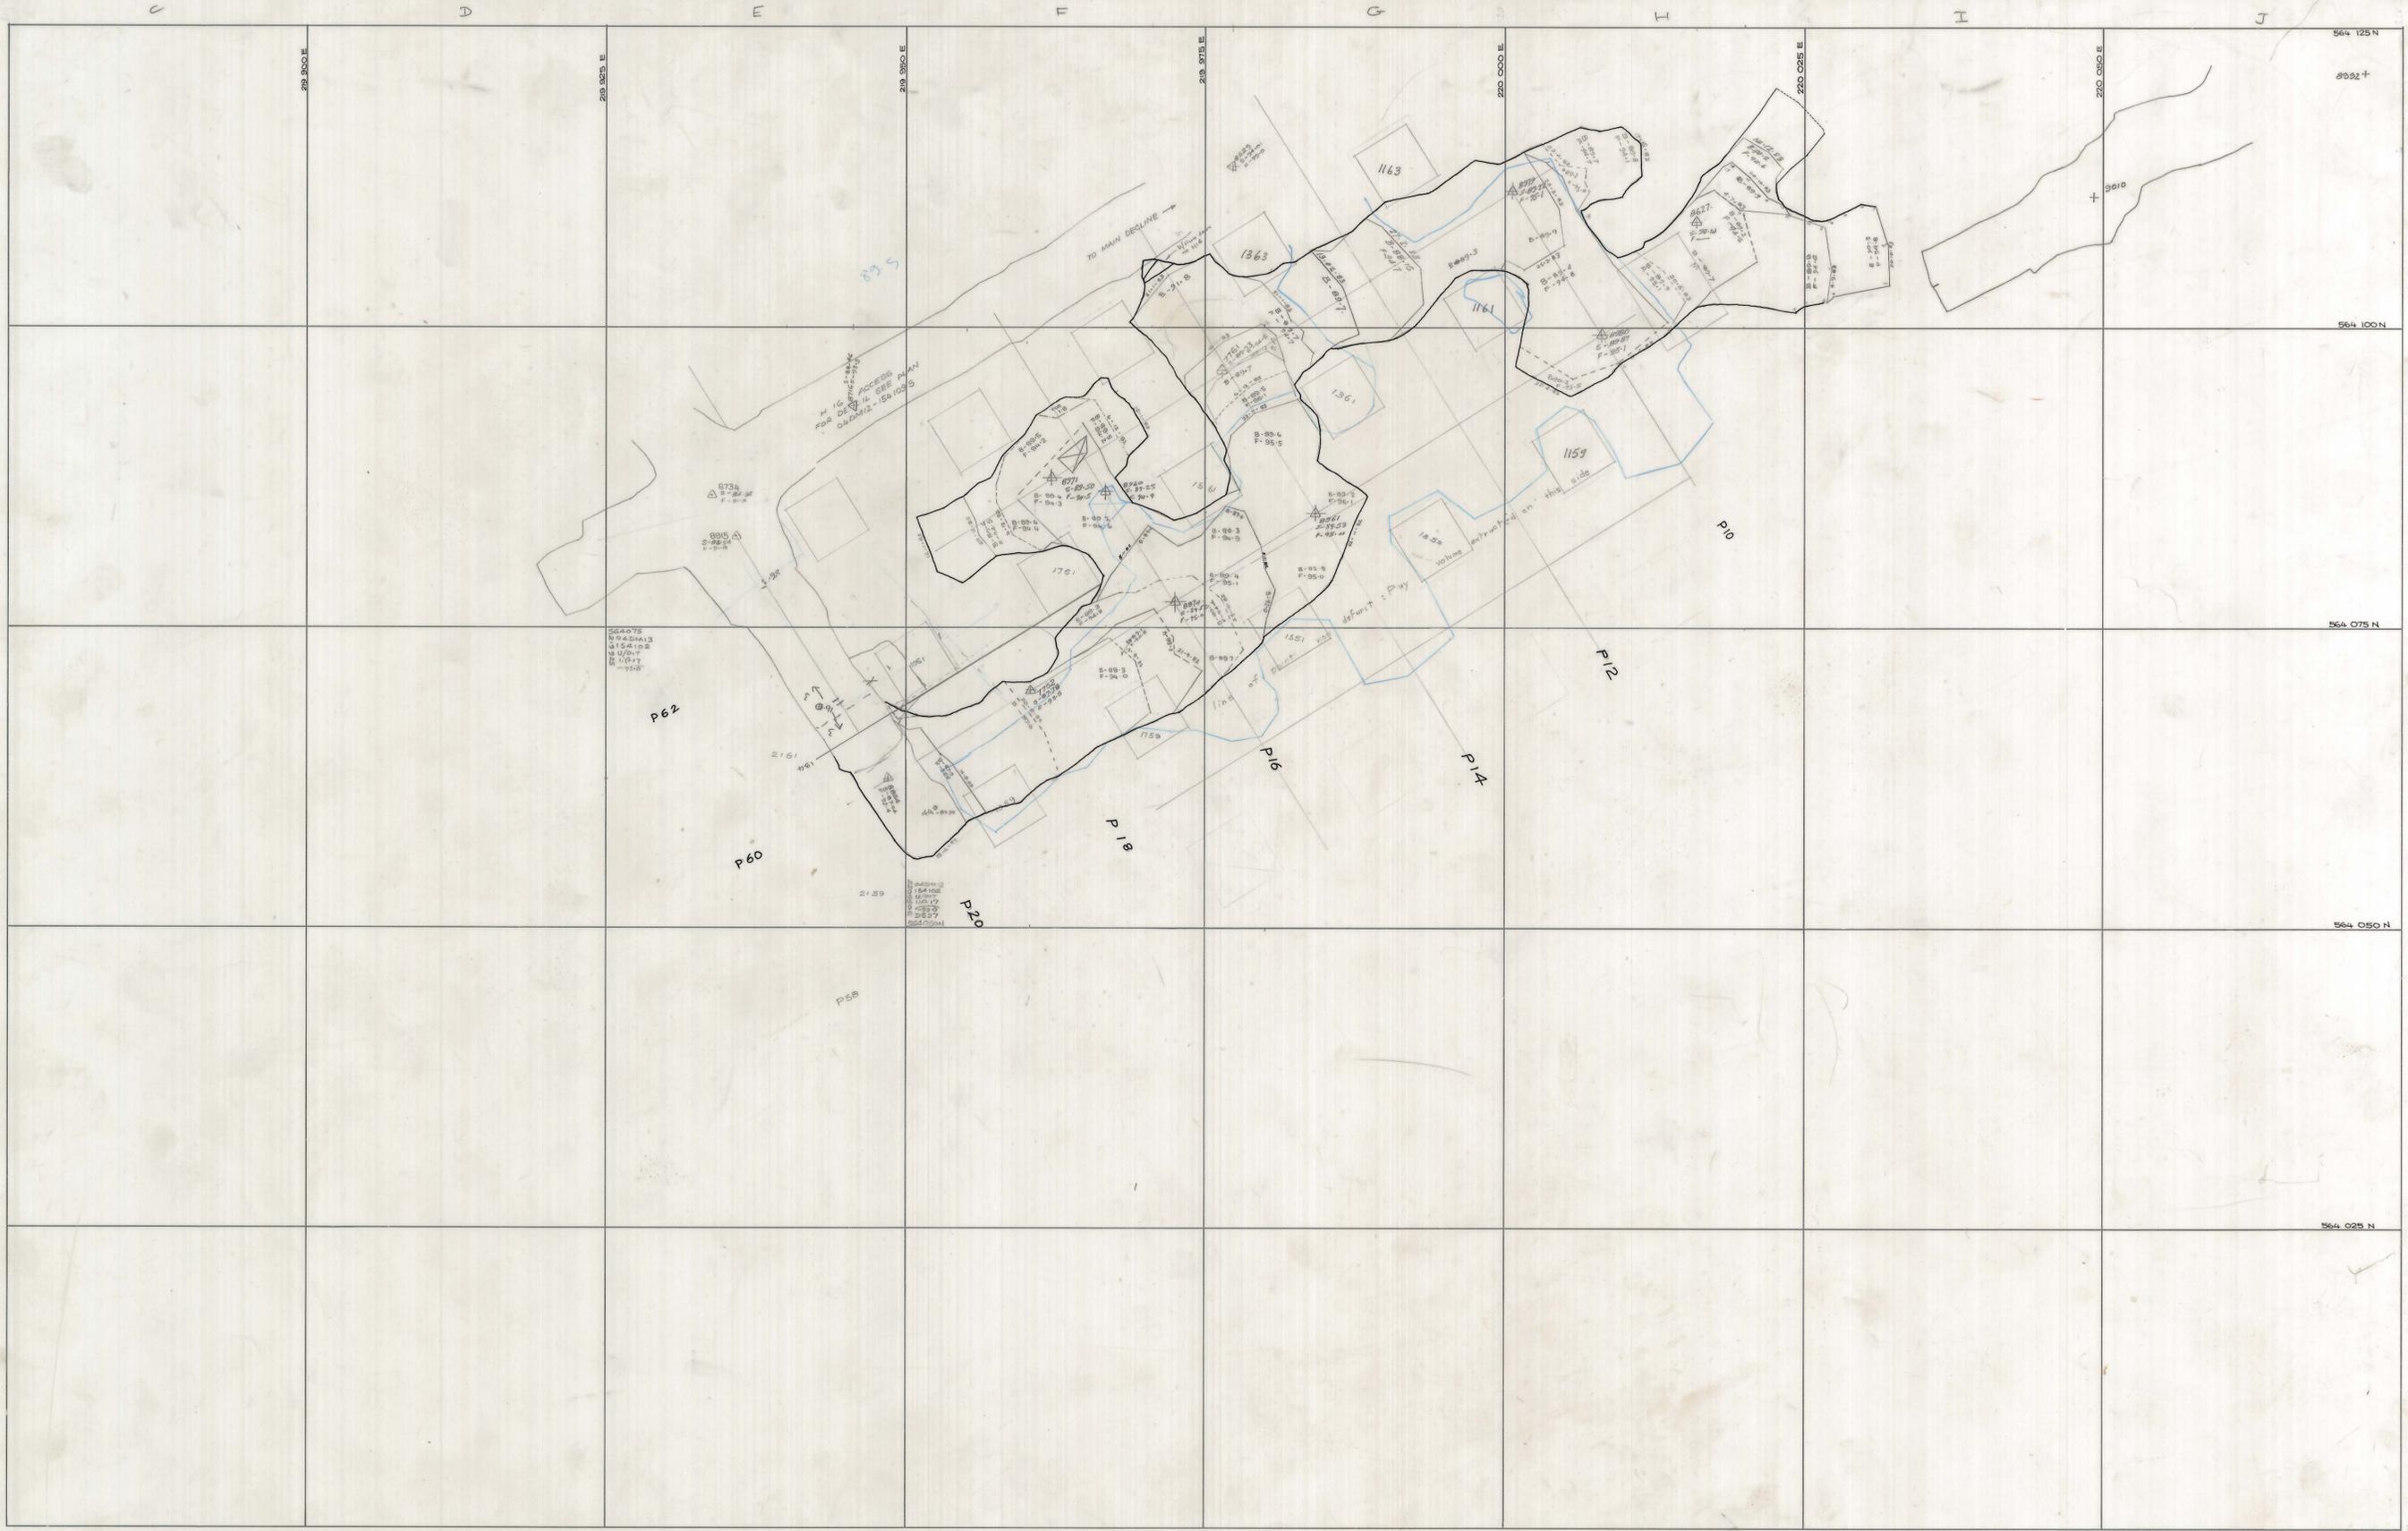

<p>SCALE 1:250</p> <p>Date Sheet D627</p>	<p>north</p>	<p>LOCATION DOLPHIN MINE</p> <p>SUBJECT UPPER PIT STOPE - 93.0 m CONTOUR</p>	<p>KING ISLAND SCHEELITE A DIVISION OF WARMAN INTERNATIONAL</p> <p>GRASSY KING ISLAND</p> <p>PLAN NUMBER 04DM13 - 154 102</p>
---	--------------	--	---