


5 cm

0374\_2109

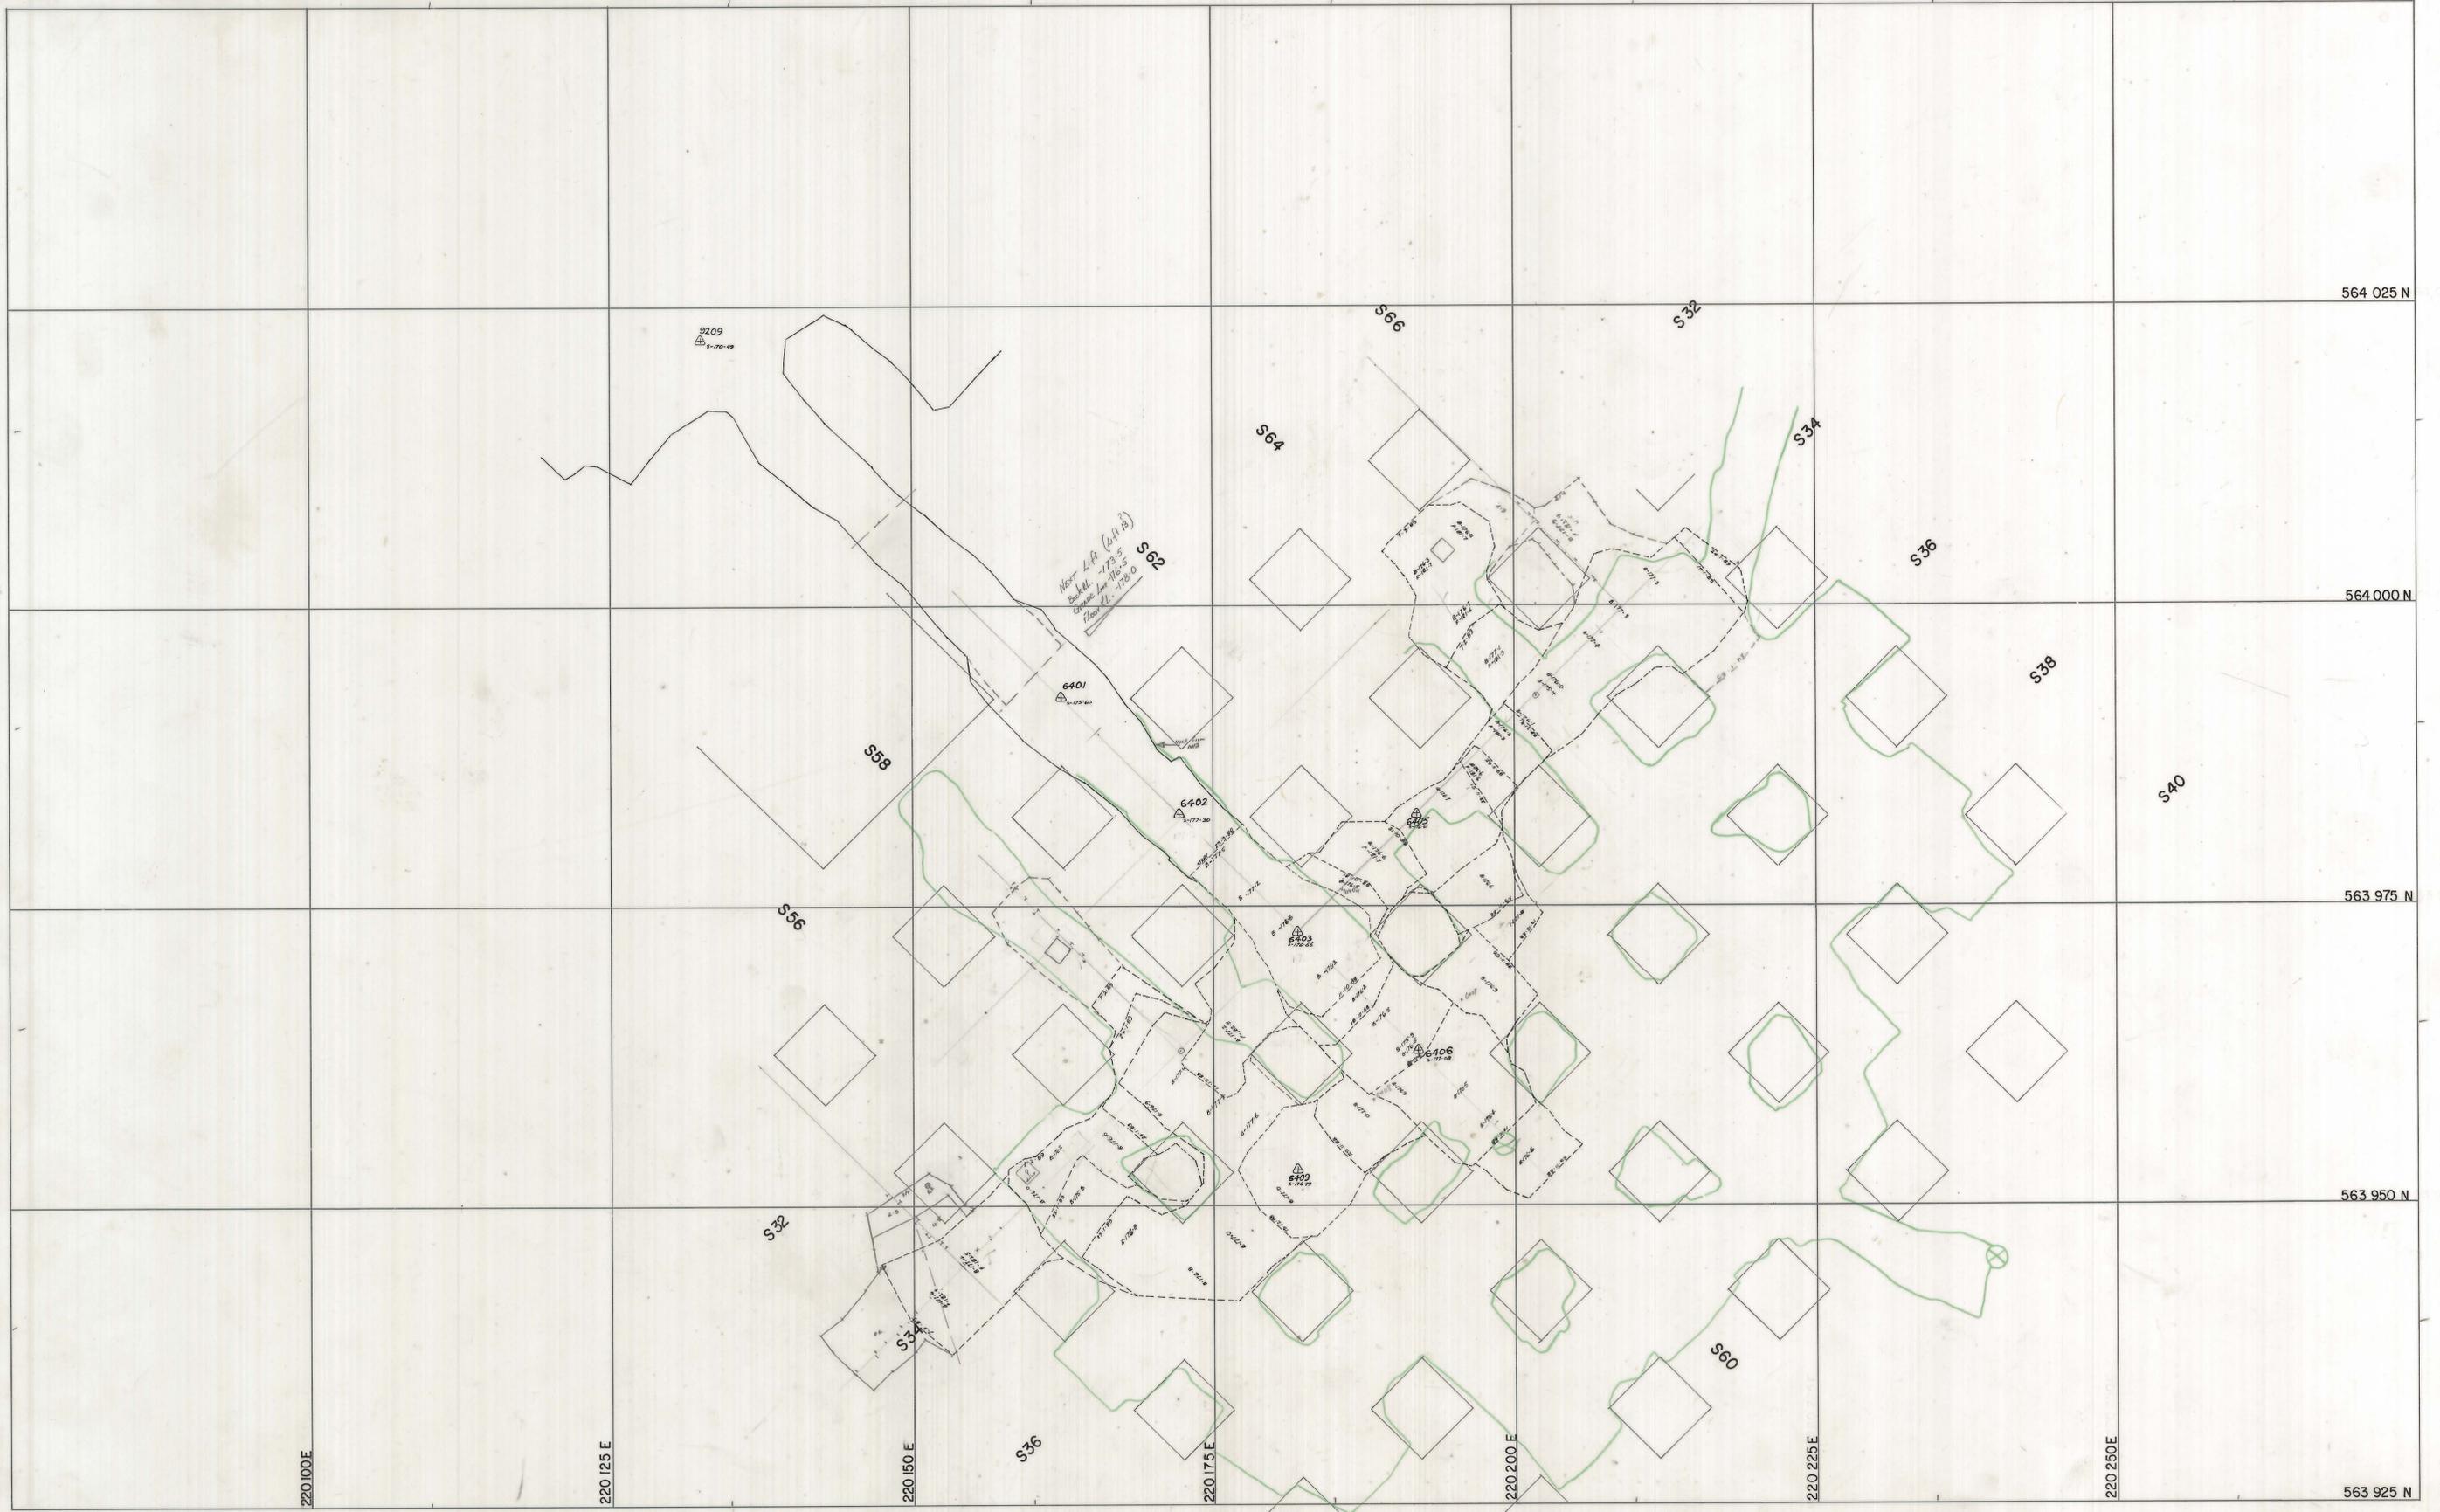

<p>SCALE 1: 250</p>		<p>LOCATION</p> <p>SUBJECT</p> <p>LOWER PIT STOPE Lift 12</p>	<p>GRASSY KING ISLAND</p> <p>PLAN NUMBER WP 177</p>
---------------------	--	---	---