


0374-211

04BH15-106-90

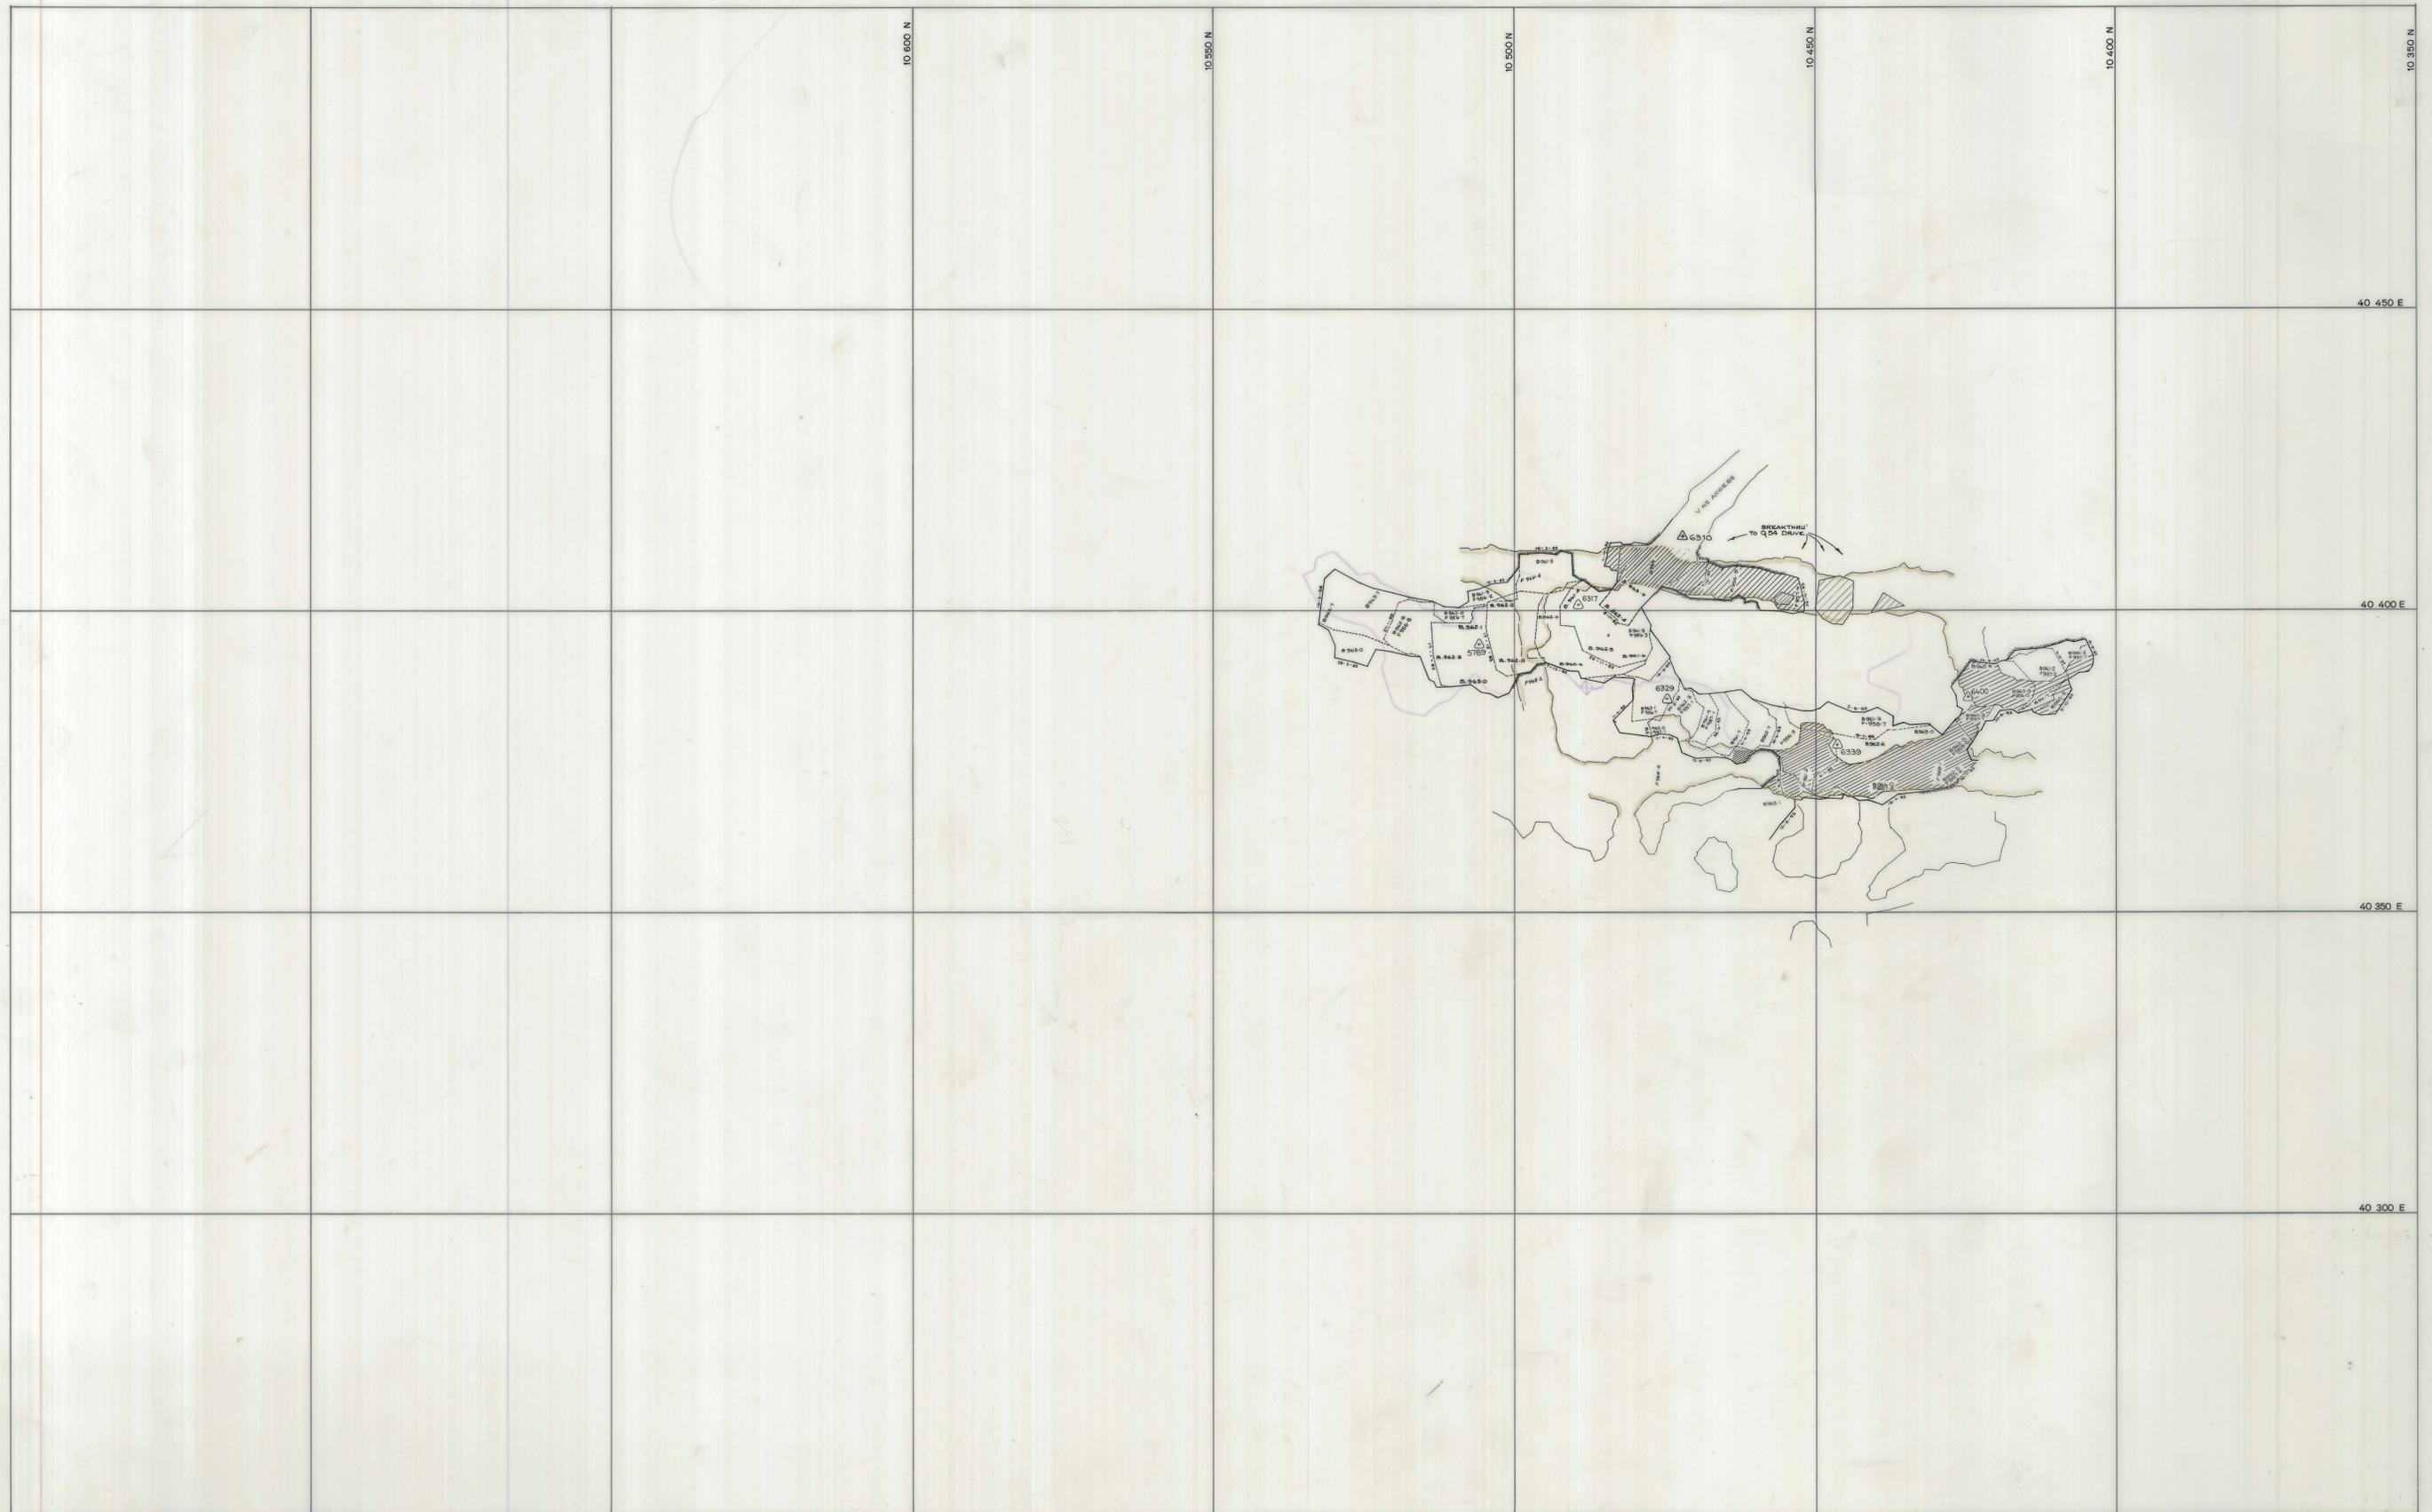

	<p>SCALE 1: 500</p> <p>5 cm</p>		<p>LOCATION BOLD HEAD MINE</p> <p>SUBJECT 0 46 STOPE 10th Lift</p>	<p>KING ISLAND SCHEELITE A DIVISION OF WARMAN INTERNATIONAL</p> <p>GRASSY KING ISLAND</p> <p>PLAN NUMBER 04BH15 - 106 - 90</p>
--	---------------------------------	--	--	--