


0374-2111

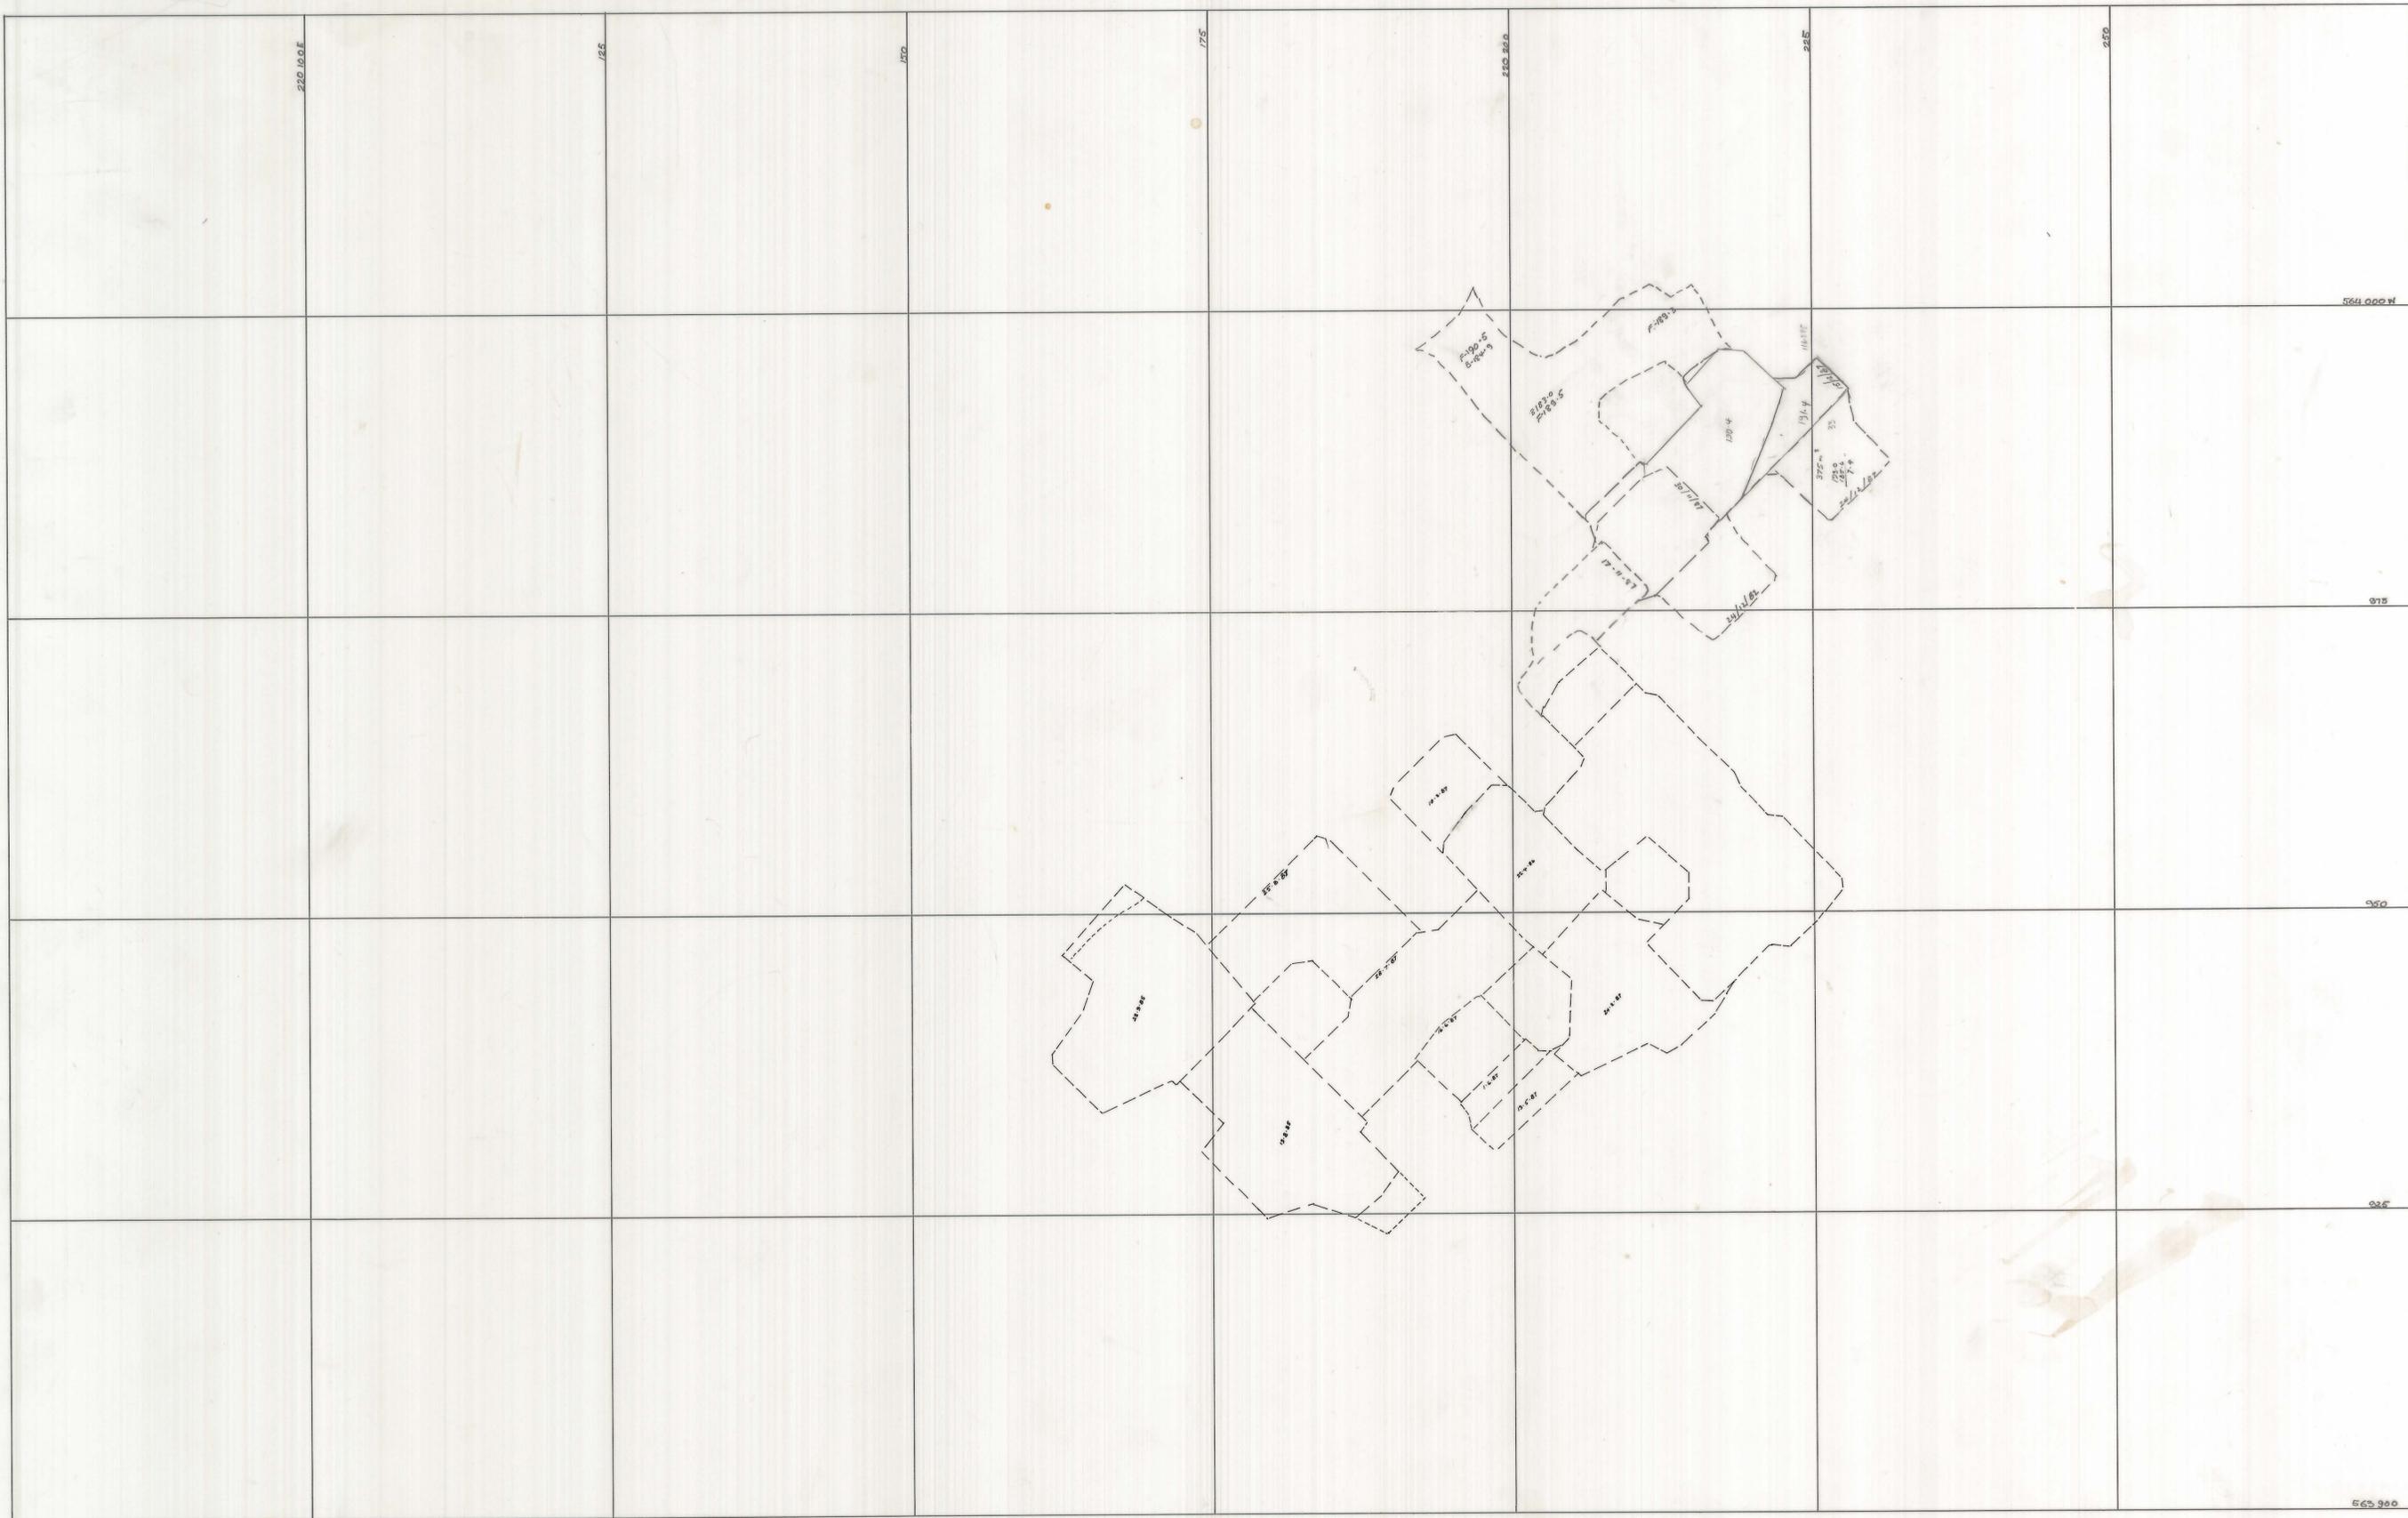

	<p>SCALE 1: 250</p>	<p>north</p>	<p>LOCATION</p> <p>SUBJECT</p> <p>LOWER PIT STOPE Lift 10 SILL</p>	<p>GRASSY KING ISLAND</p> <p>PLAN NUMBER</p>
--	---------------------	--------------	--	--