


5 cm

0374-2114

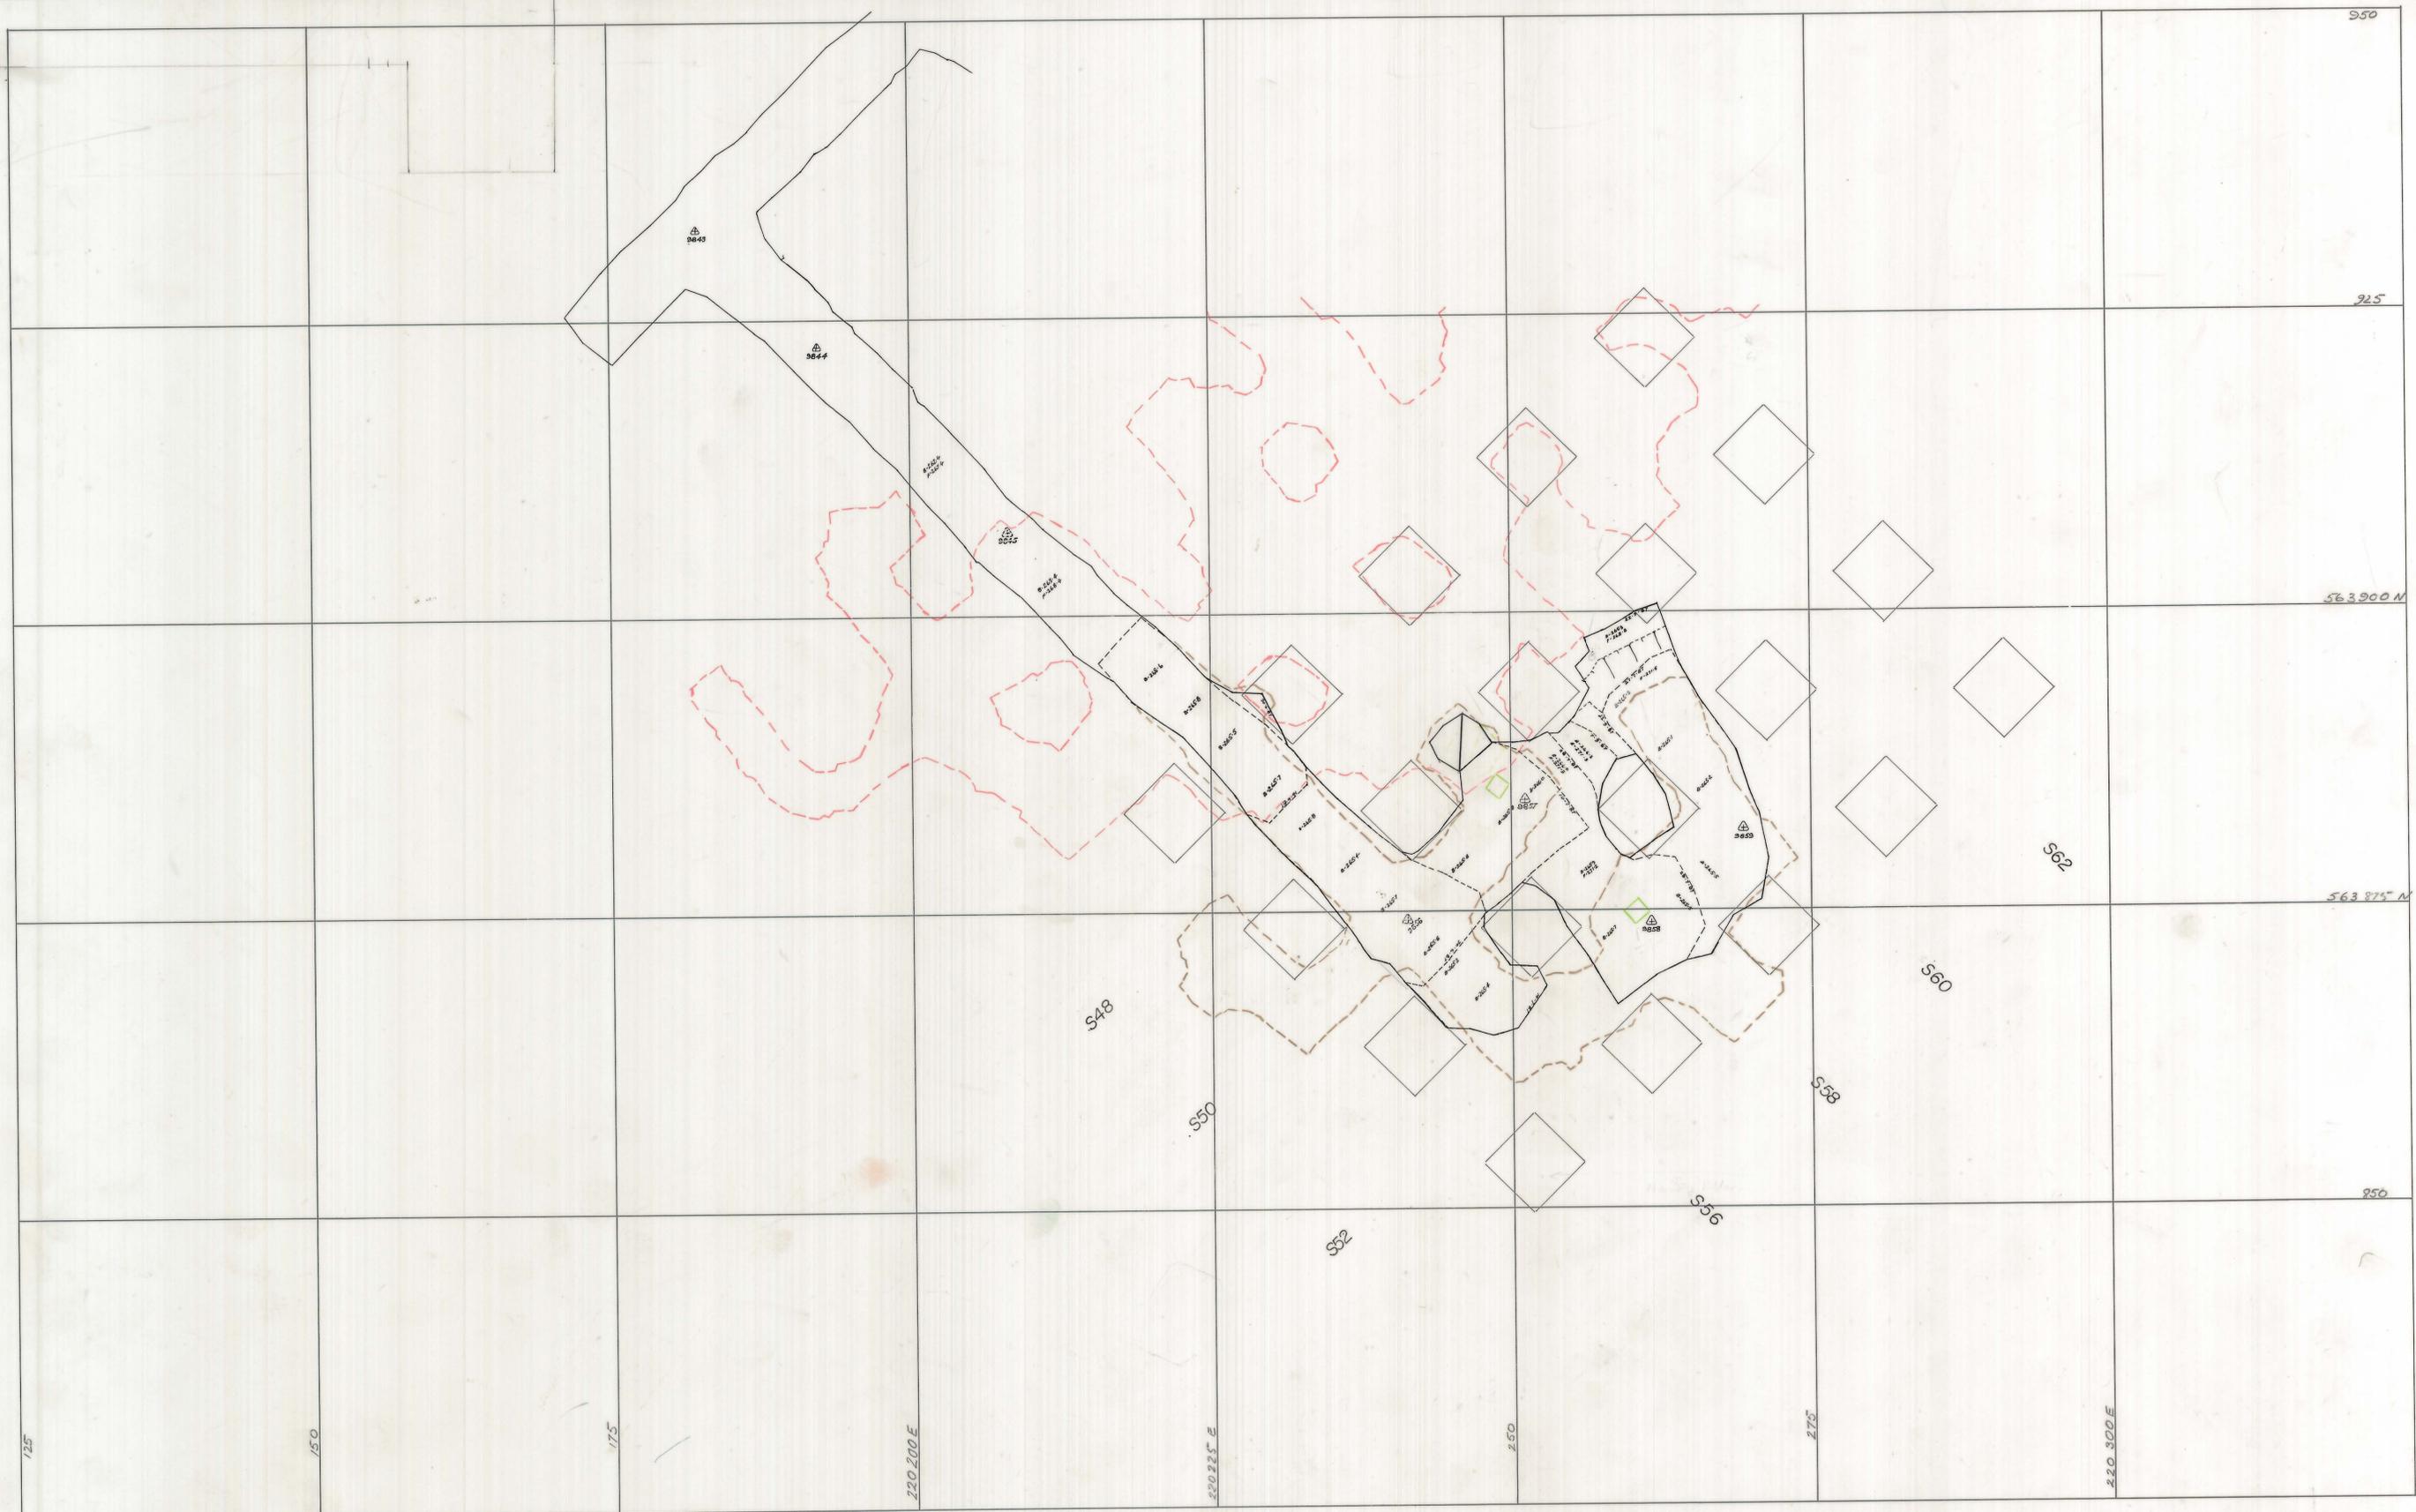

	<p>SCALE 1: 250</p>		<p>LOCATION SWAN</p> <p>SUBJECT Lift 1</p>	<p>GRASSY KING ISLAND</p> <p>PLAN NUMBER WP 2655</p>
--	---------------------	--	--	--