




04DM12 - 136 164 S

0374-2116

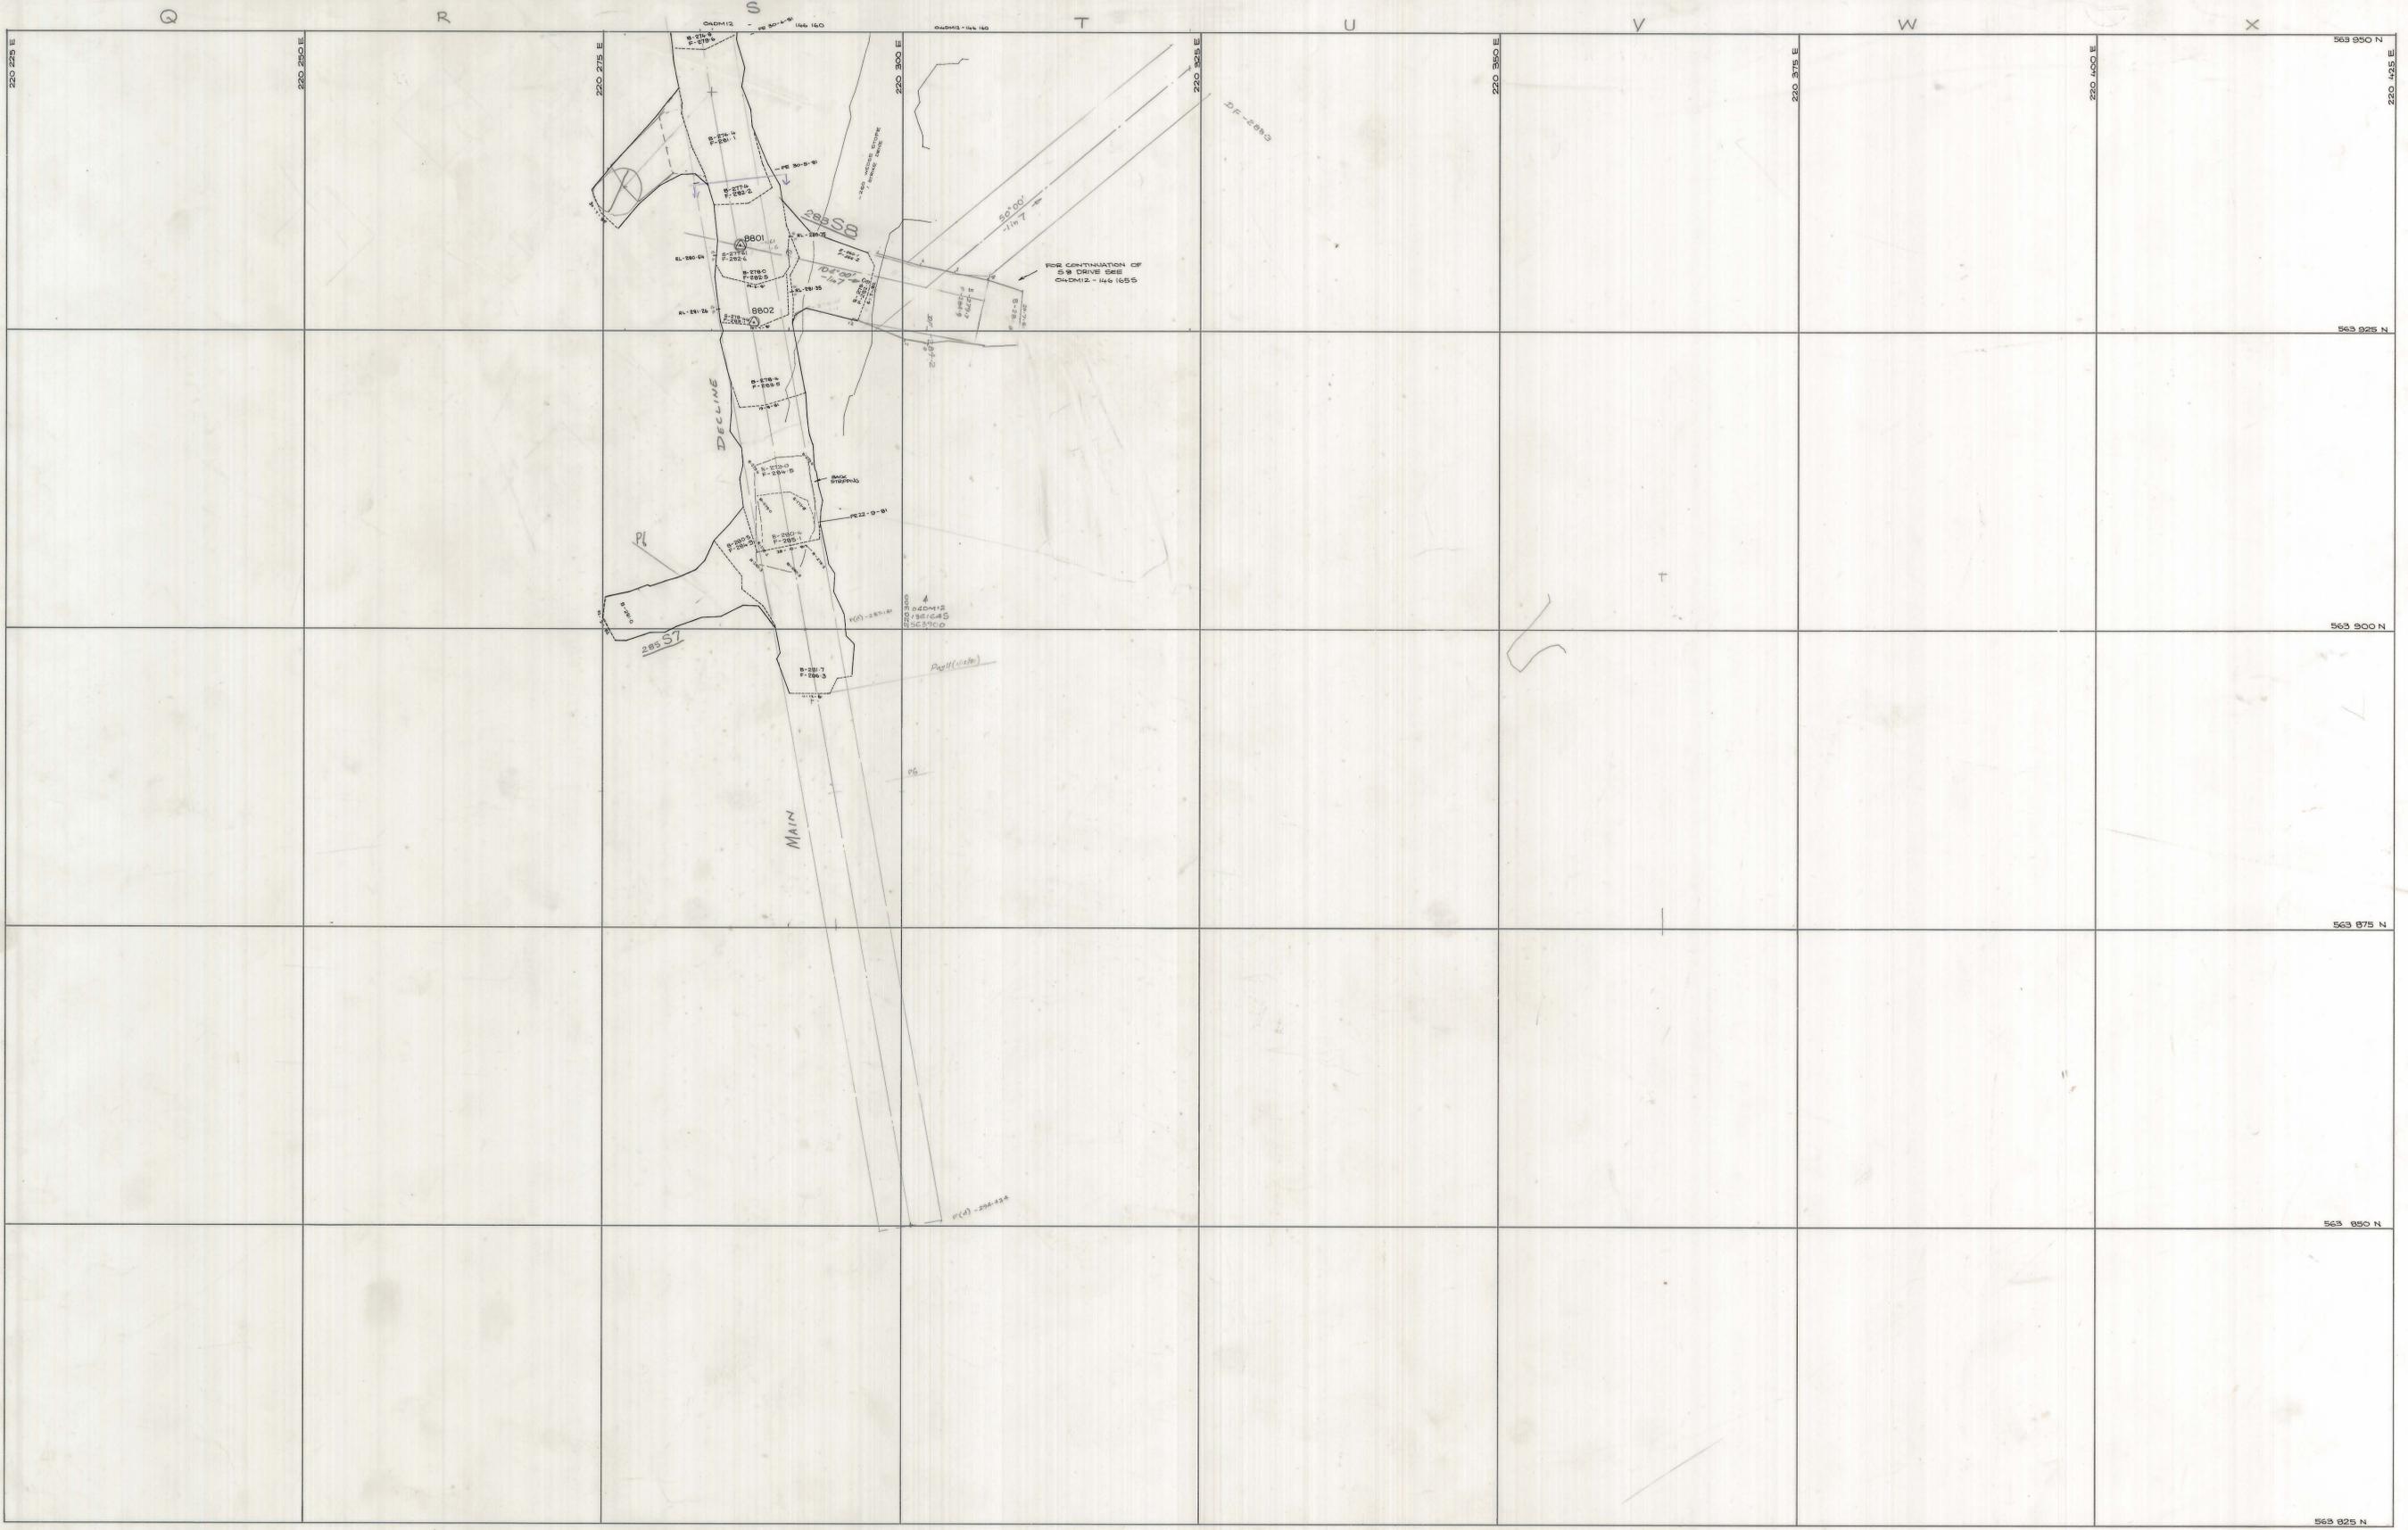

<p>SCALE 1:250</p> <p>Drawn: 23/09/03 - 2003 M.P. Date: 2003/11/19 283 S8 using 03DM12-136164 S</p>	<p>north</p>	<p>LOCATION: DOLPHIN MINE</p> <p>SUBJECT: MAIN DECLINE -280 region</p>	<p>GRASSY KING ISLAND</p> <p>PLAN NUMBER: 04DM12 - 136 164 S</p>
---	--------------	--	--