


5 cm

27 JUN 1981

04DM12-146136

- 200m
S12
Mid Wedge
Access

0374_2120

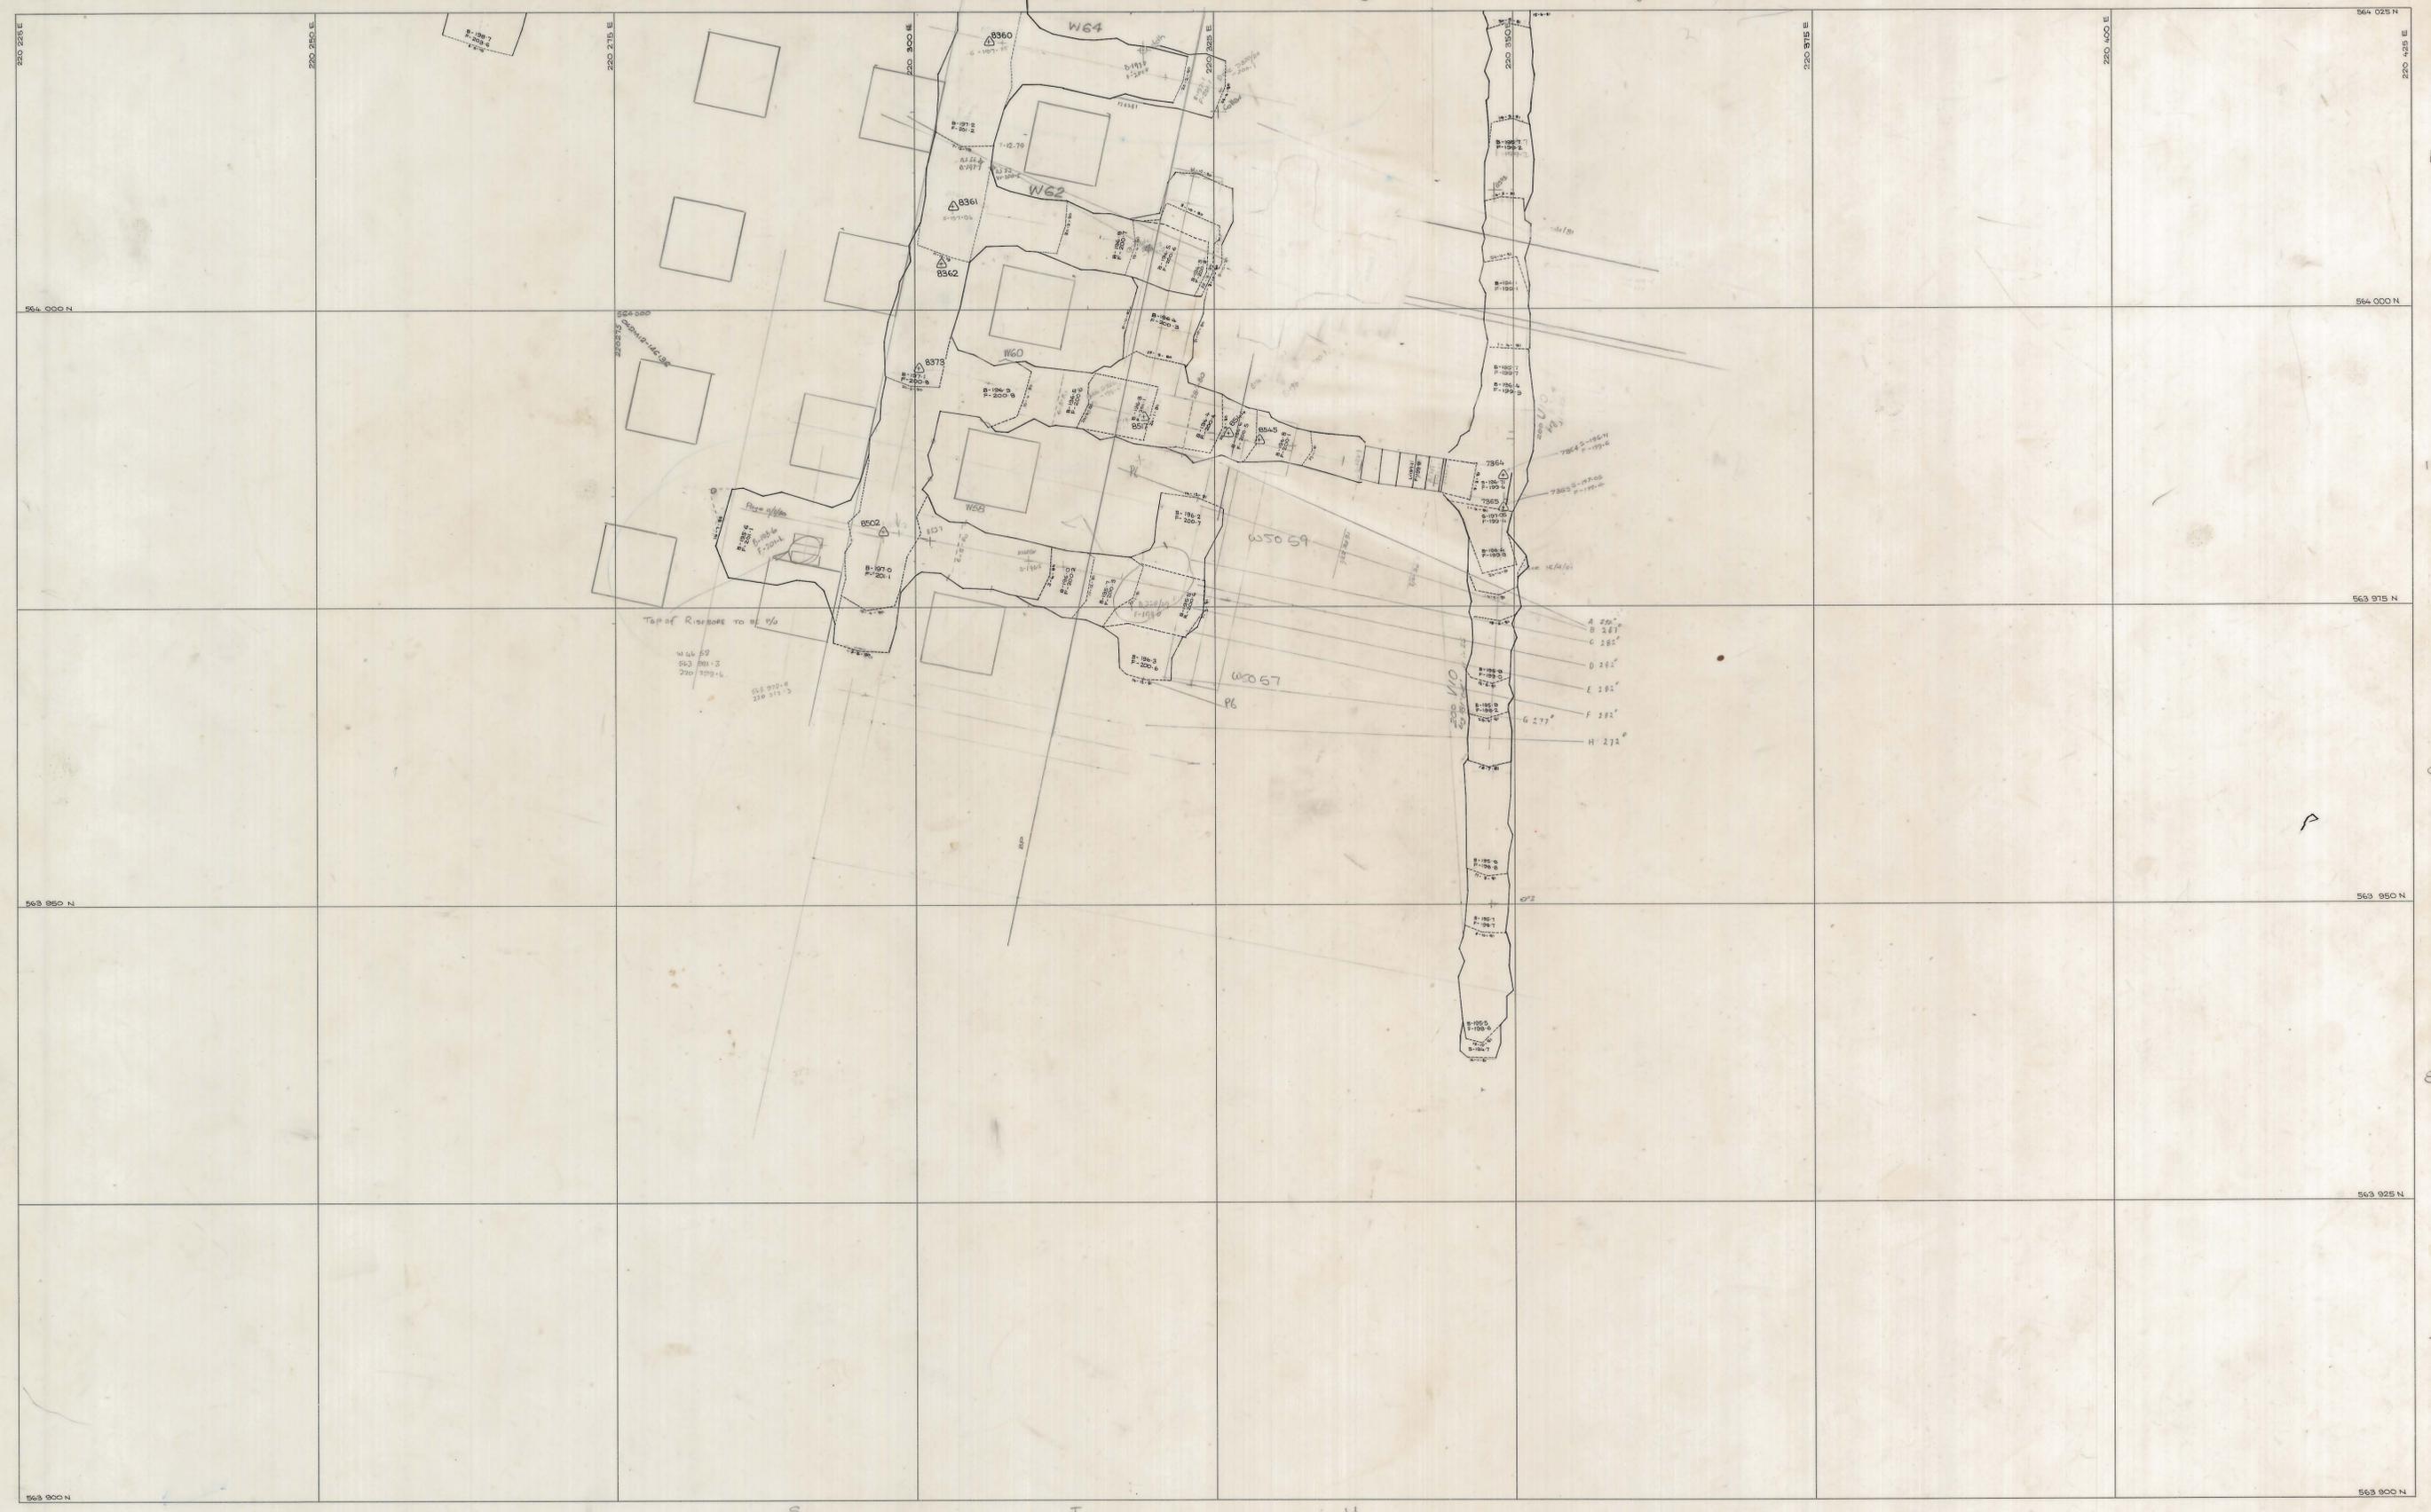

<p>SCALE 1: 250</p> <p>U10 & V10 design 03DM12-146136</p>	 <p>north</p>	<p>LOCATION DOLPHIN MINE</p> <p>SUBJECT</p> <p>S 12 MID WEDGE ACCESS</p>	 <p>GRASSY KING ISLAND</p> <p>PLAN NUMBER 04DM12 - 146 136</p>
---	--	--	---