


5 cm

27 JUN 1981

04DM12-1451255

0374-2121

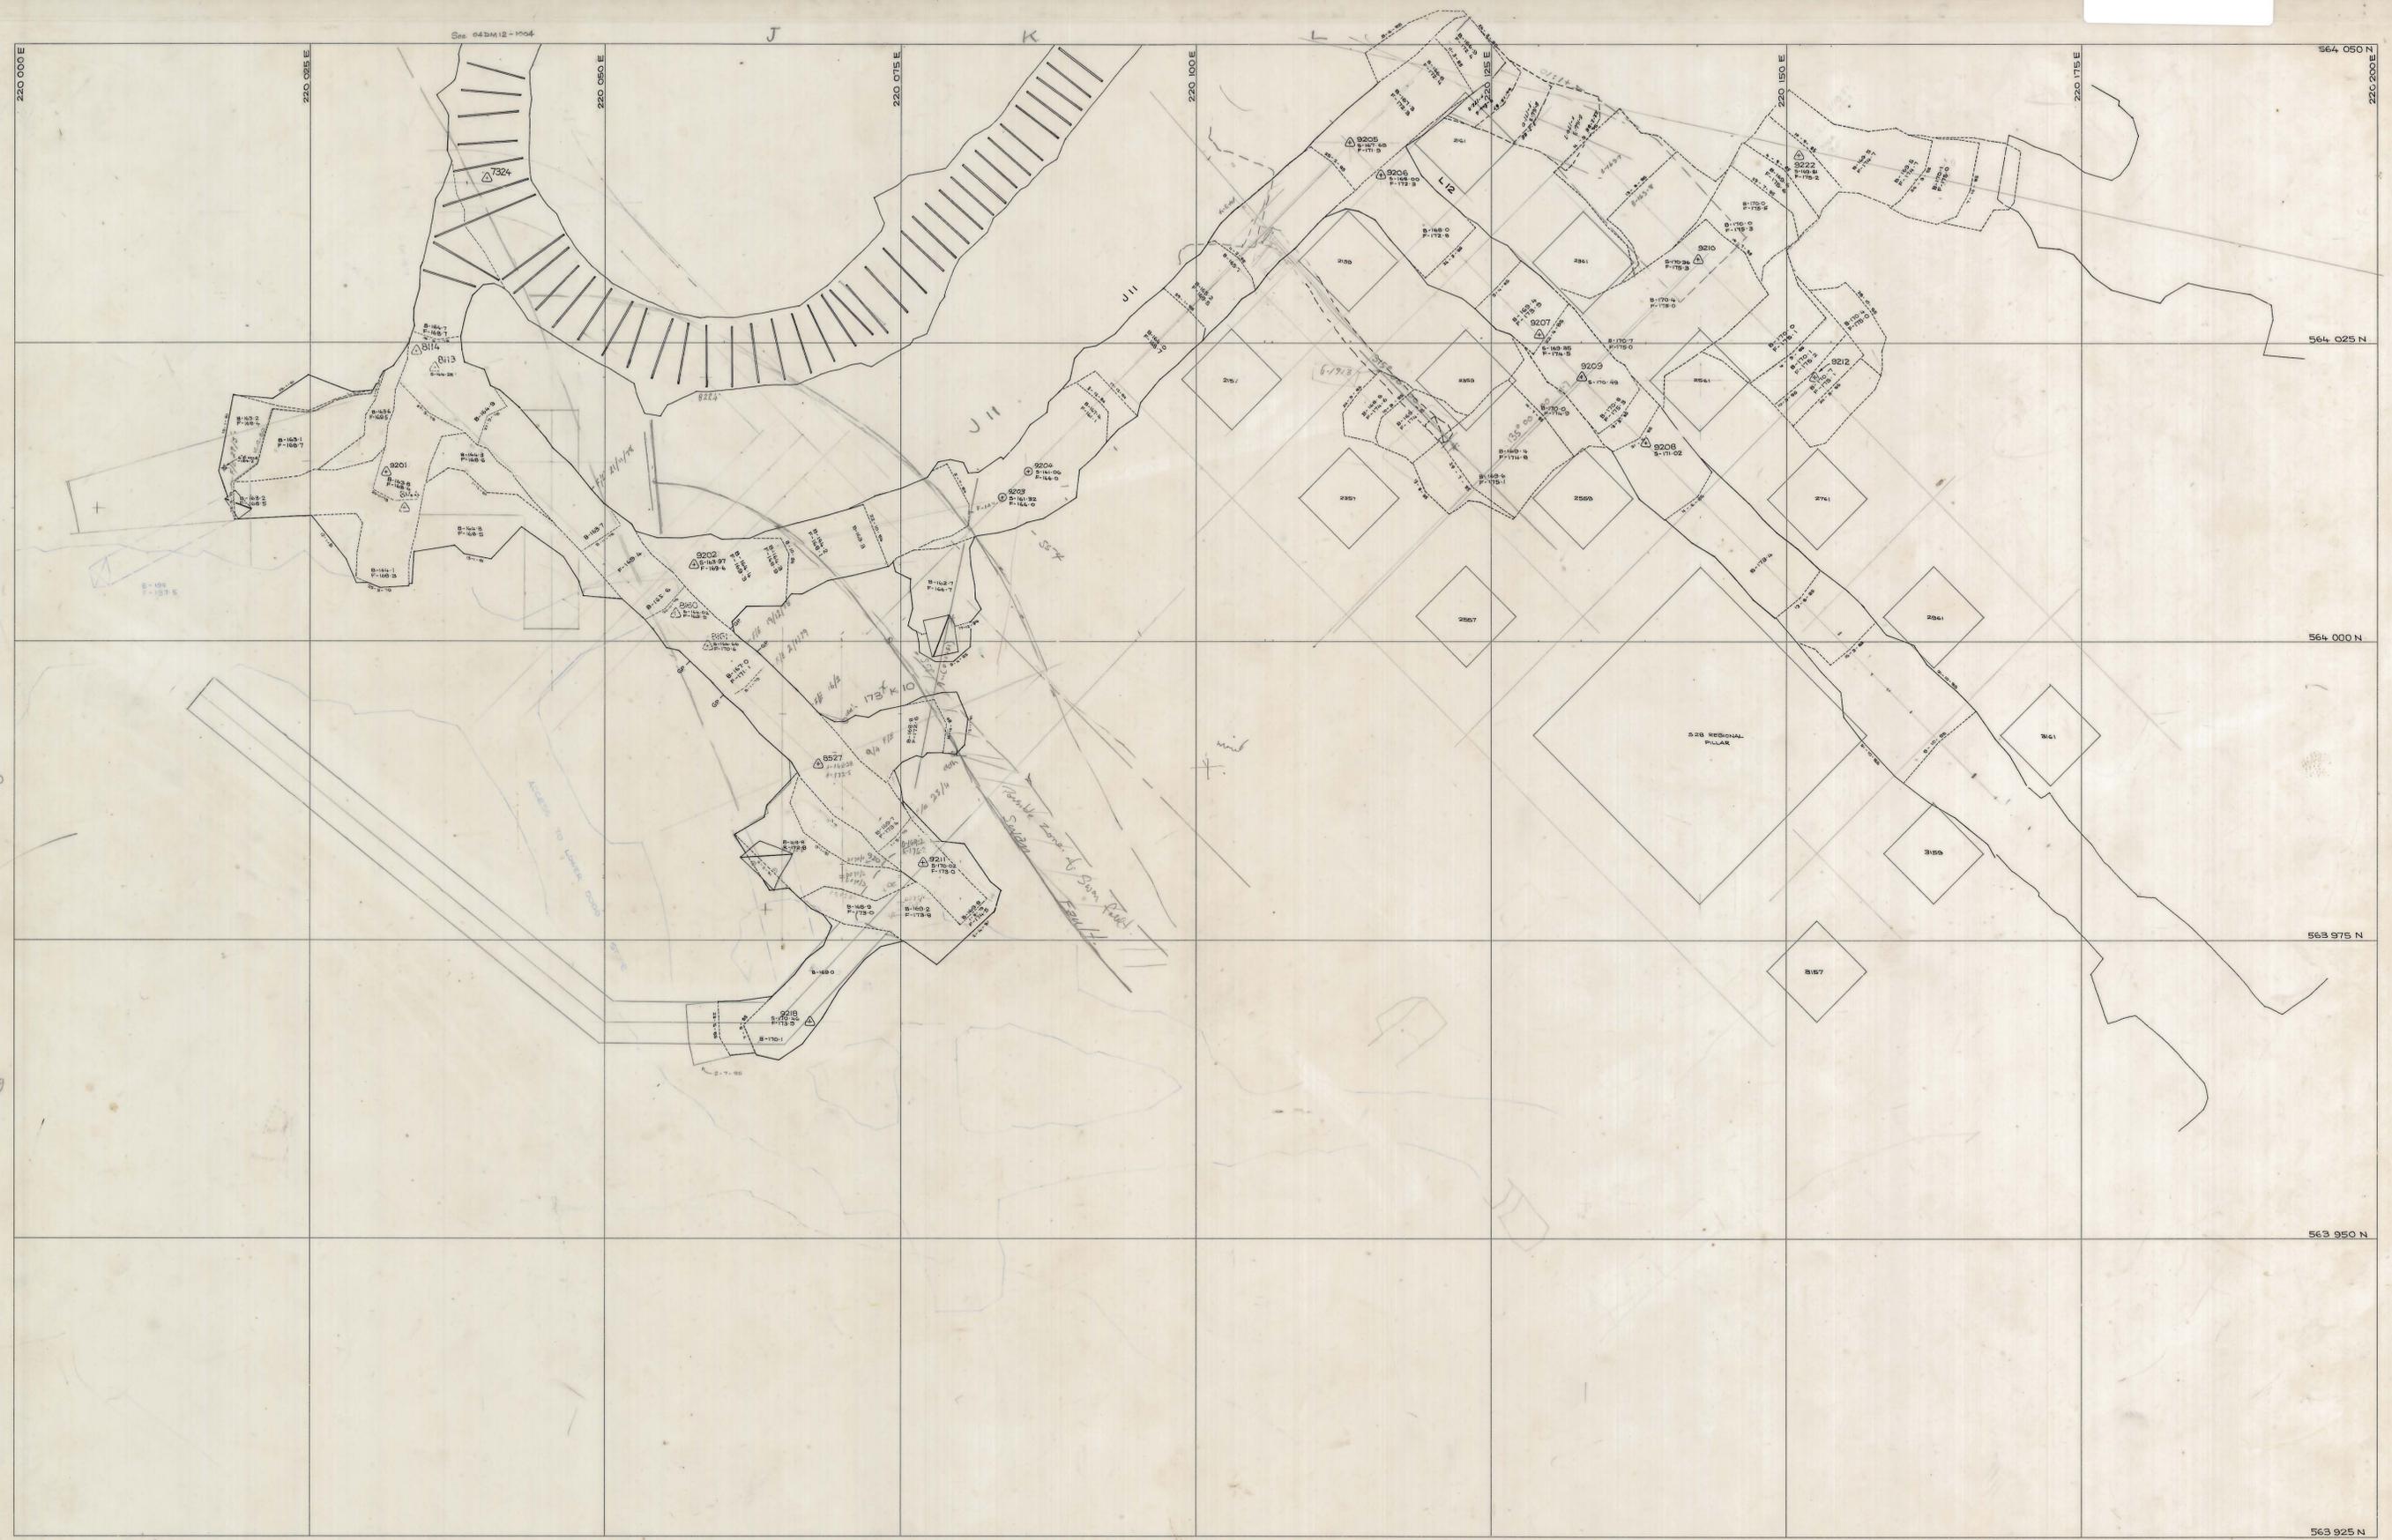

SCALE 1:250

LOCATION DOLPHIN MINE

SUBJECT ACCESS TO *Meo Per,*
OREBODY
Per Dwg - Central ~ 170m RL

KIS KING ISLAND SCHEELITE
A DIVISION OF WARMAN INTERNATIONAL

GRASSY KING ISLAND

PLAN NUMBER 04DM12 -

north