


5 cm

27 JUN 1981

0374-2122

04DM12-145-134S

N13  
O10

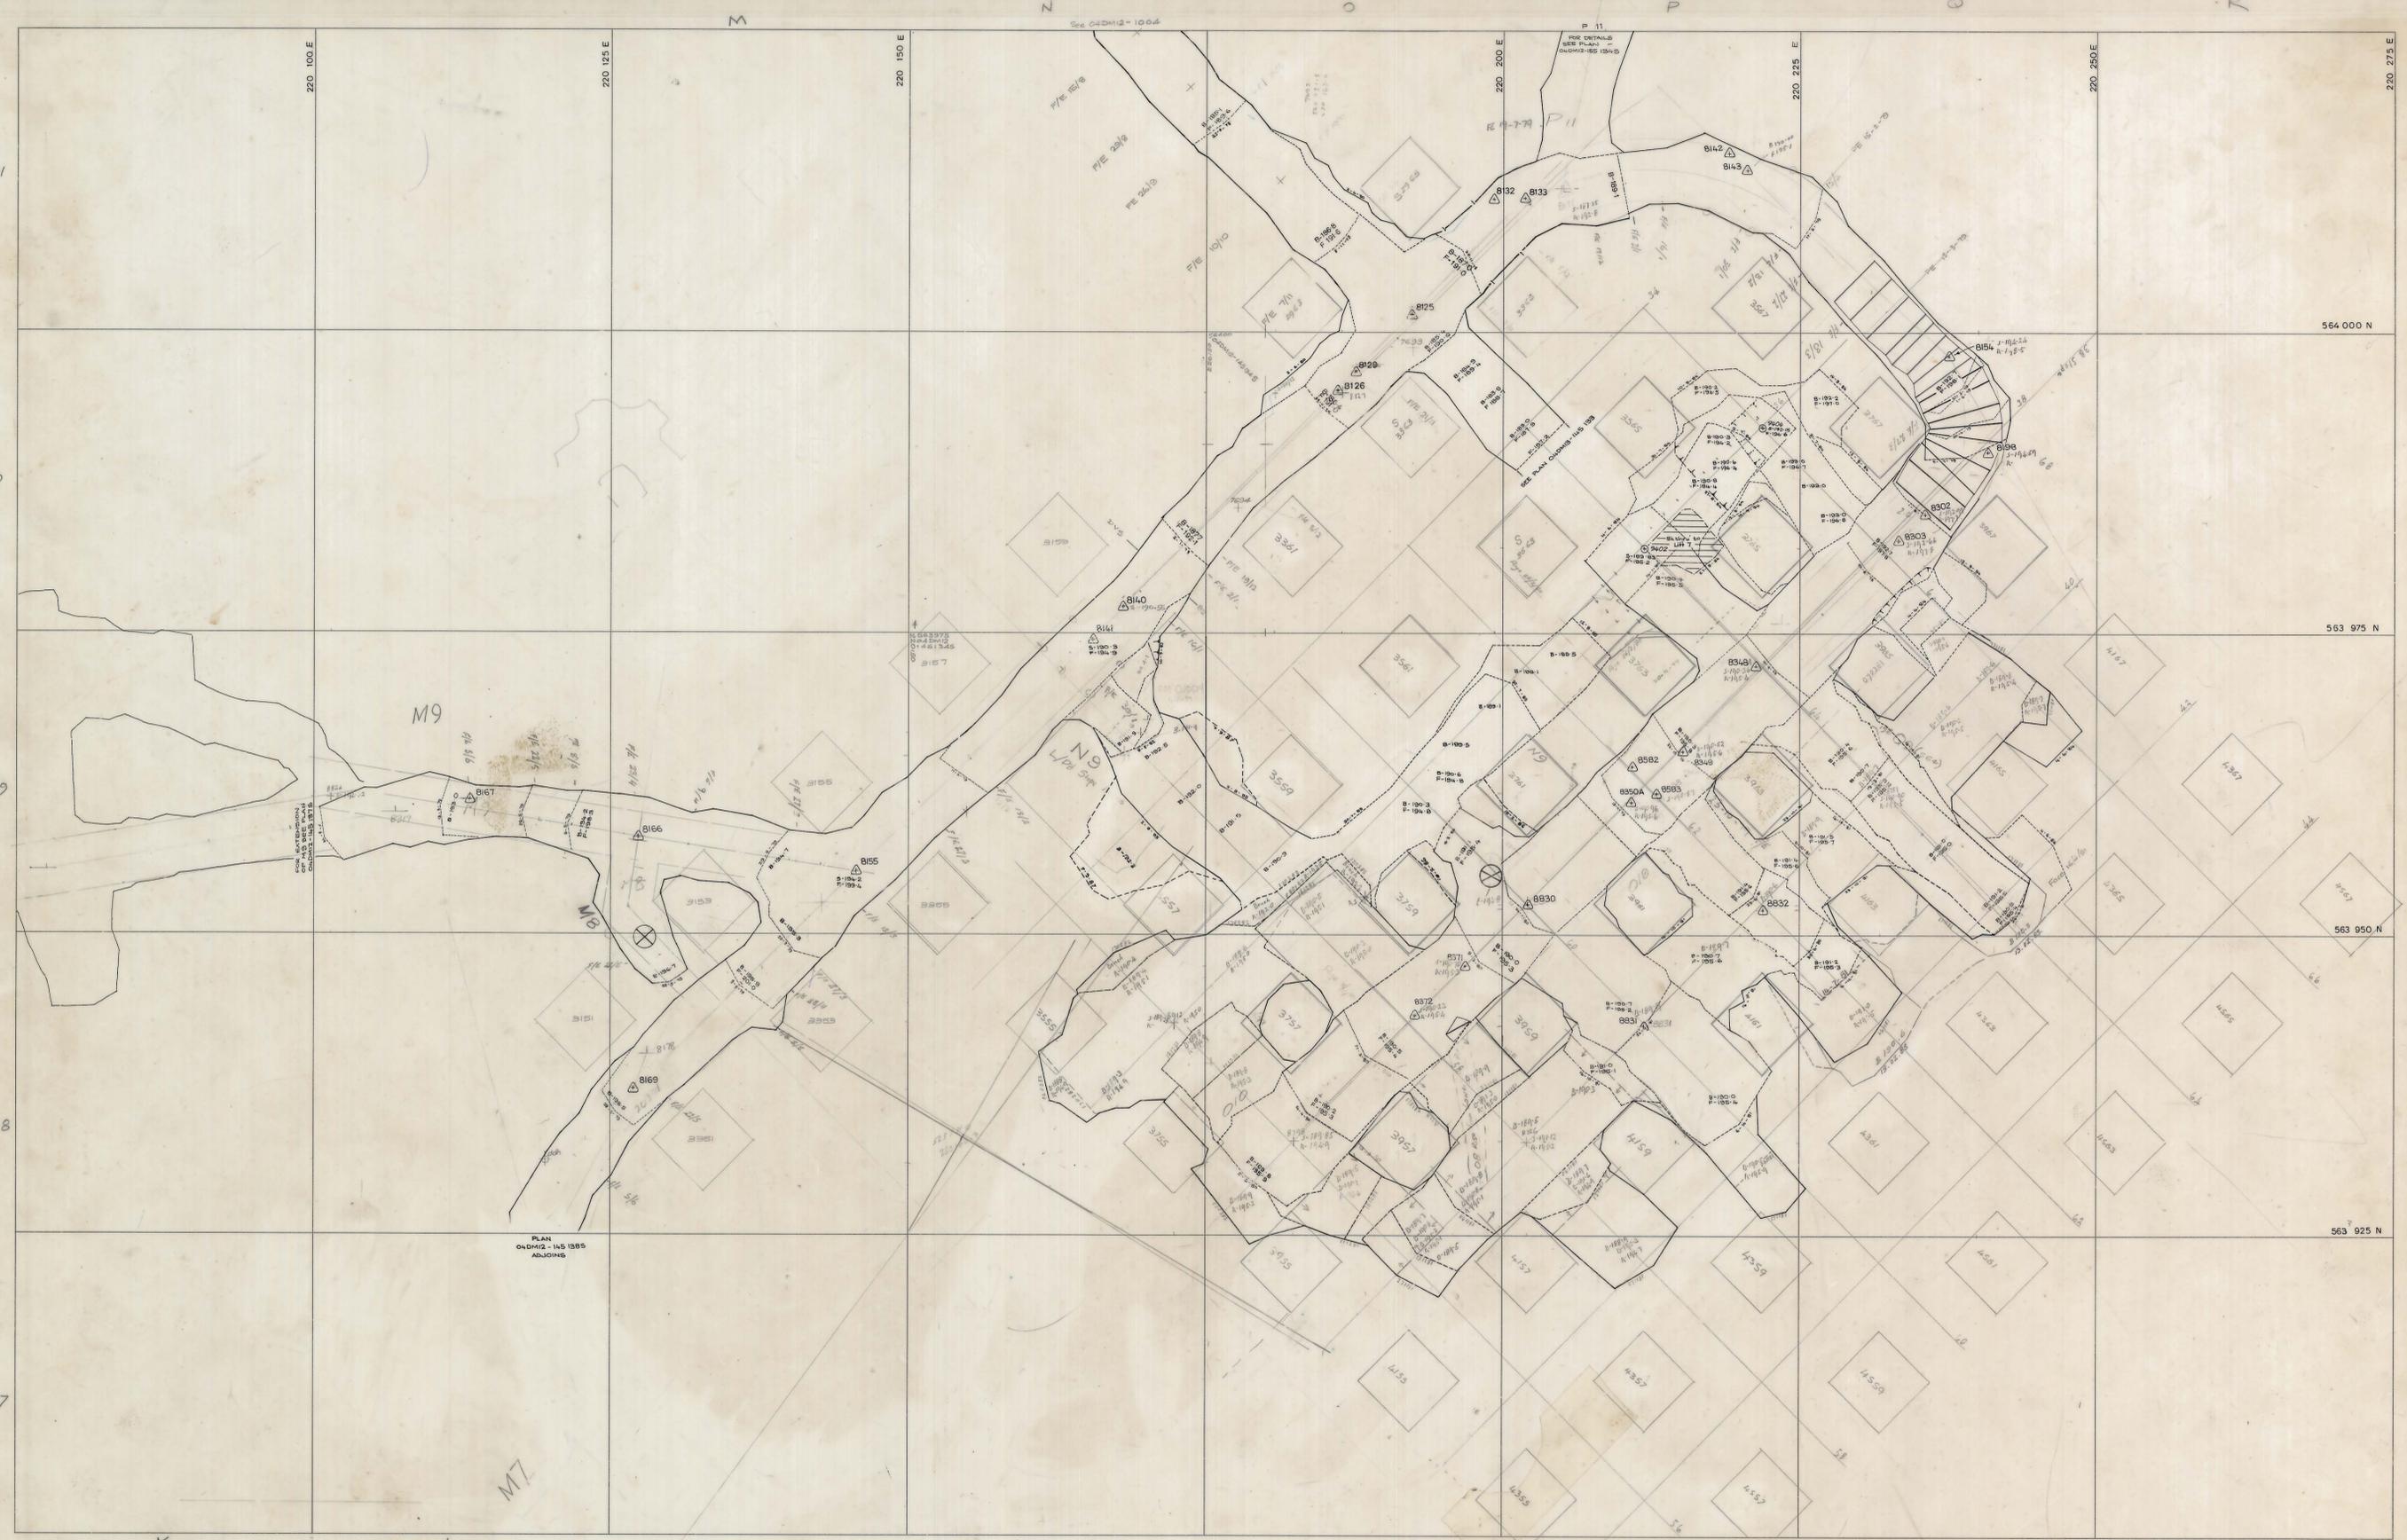

PLAN  
04DM12-145-134S  
AD-10185

SCALE 1:250

LOCATION

DOLPHIN MINE

SUBJECT

PIT STOPE ACCESS

N 13 O 10

north

**KIS** KING ISLAND SCHEELITE  
A DIVISION OF WARRIOR INTERNATIONAL

GRASSY KING ISLAND

PLAN NUMBER

04DM12 - 145 134 S