

5 cm


27 JUN 1981

0374-2133

04DM12 - 1002

-150m
ZONE
DEVELOPMENT

04DM12 - 1002

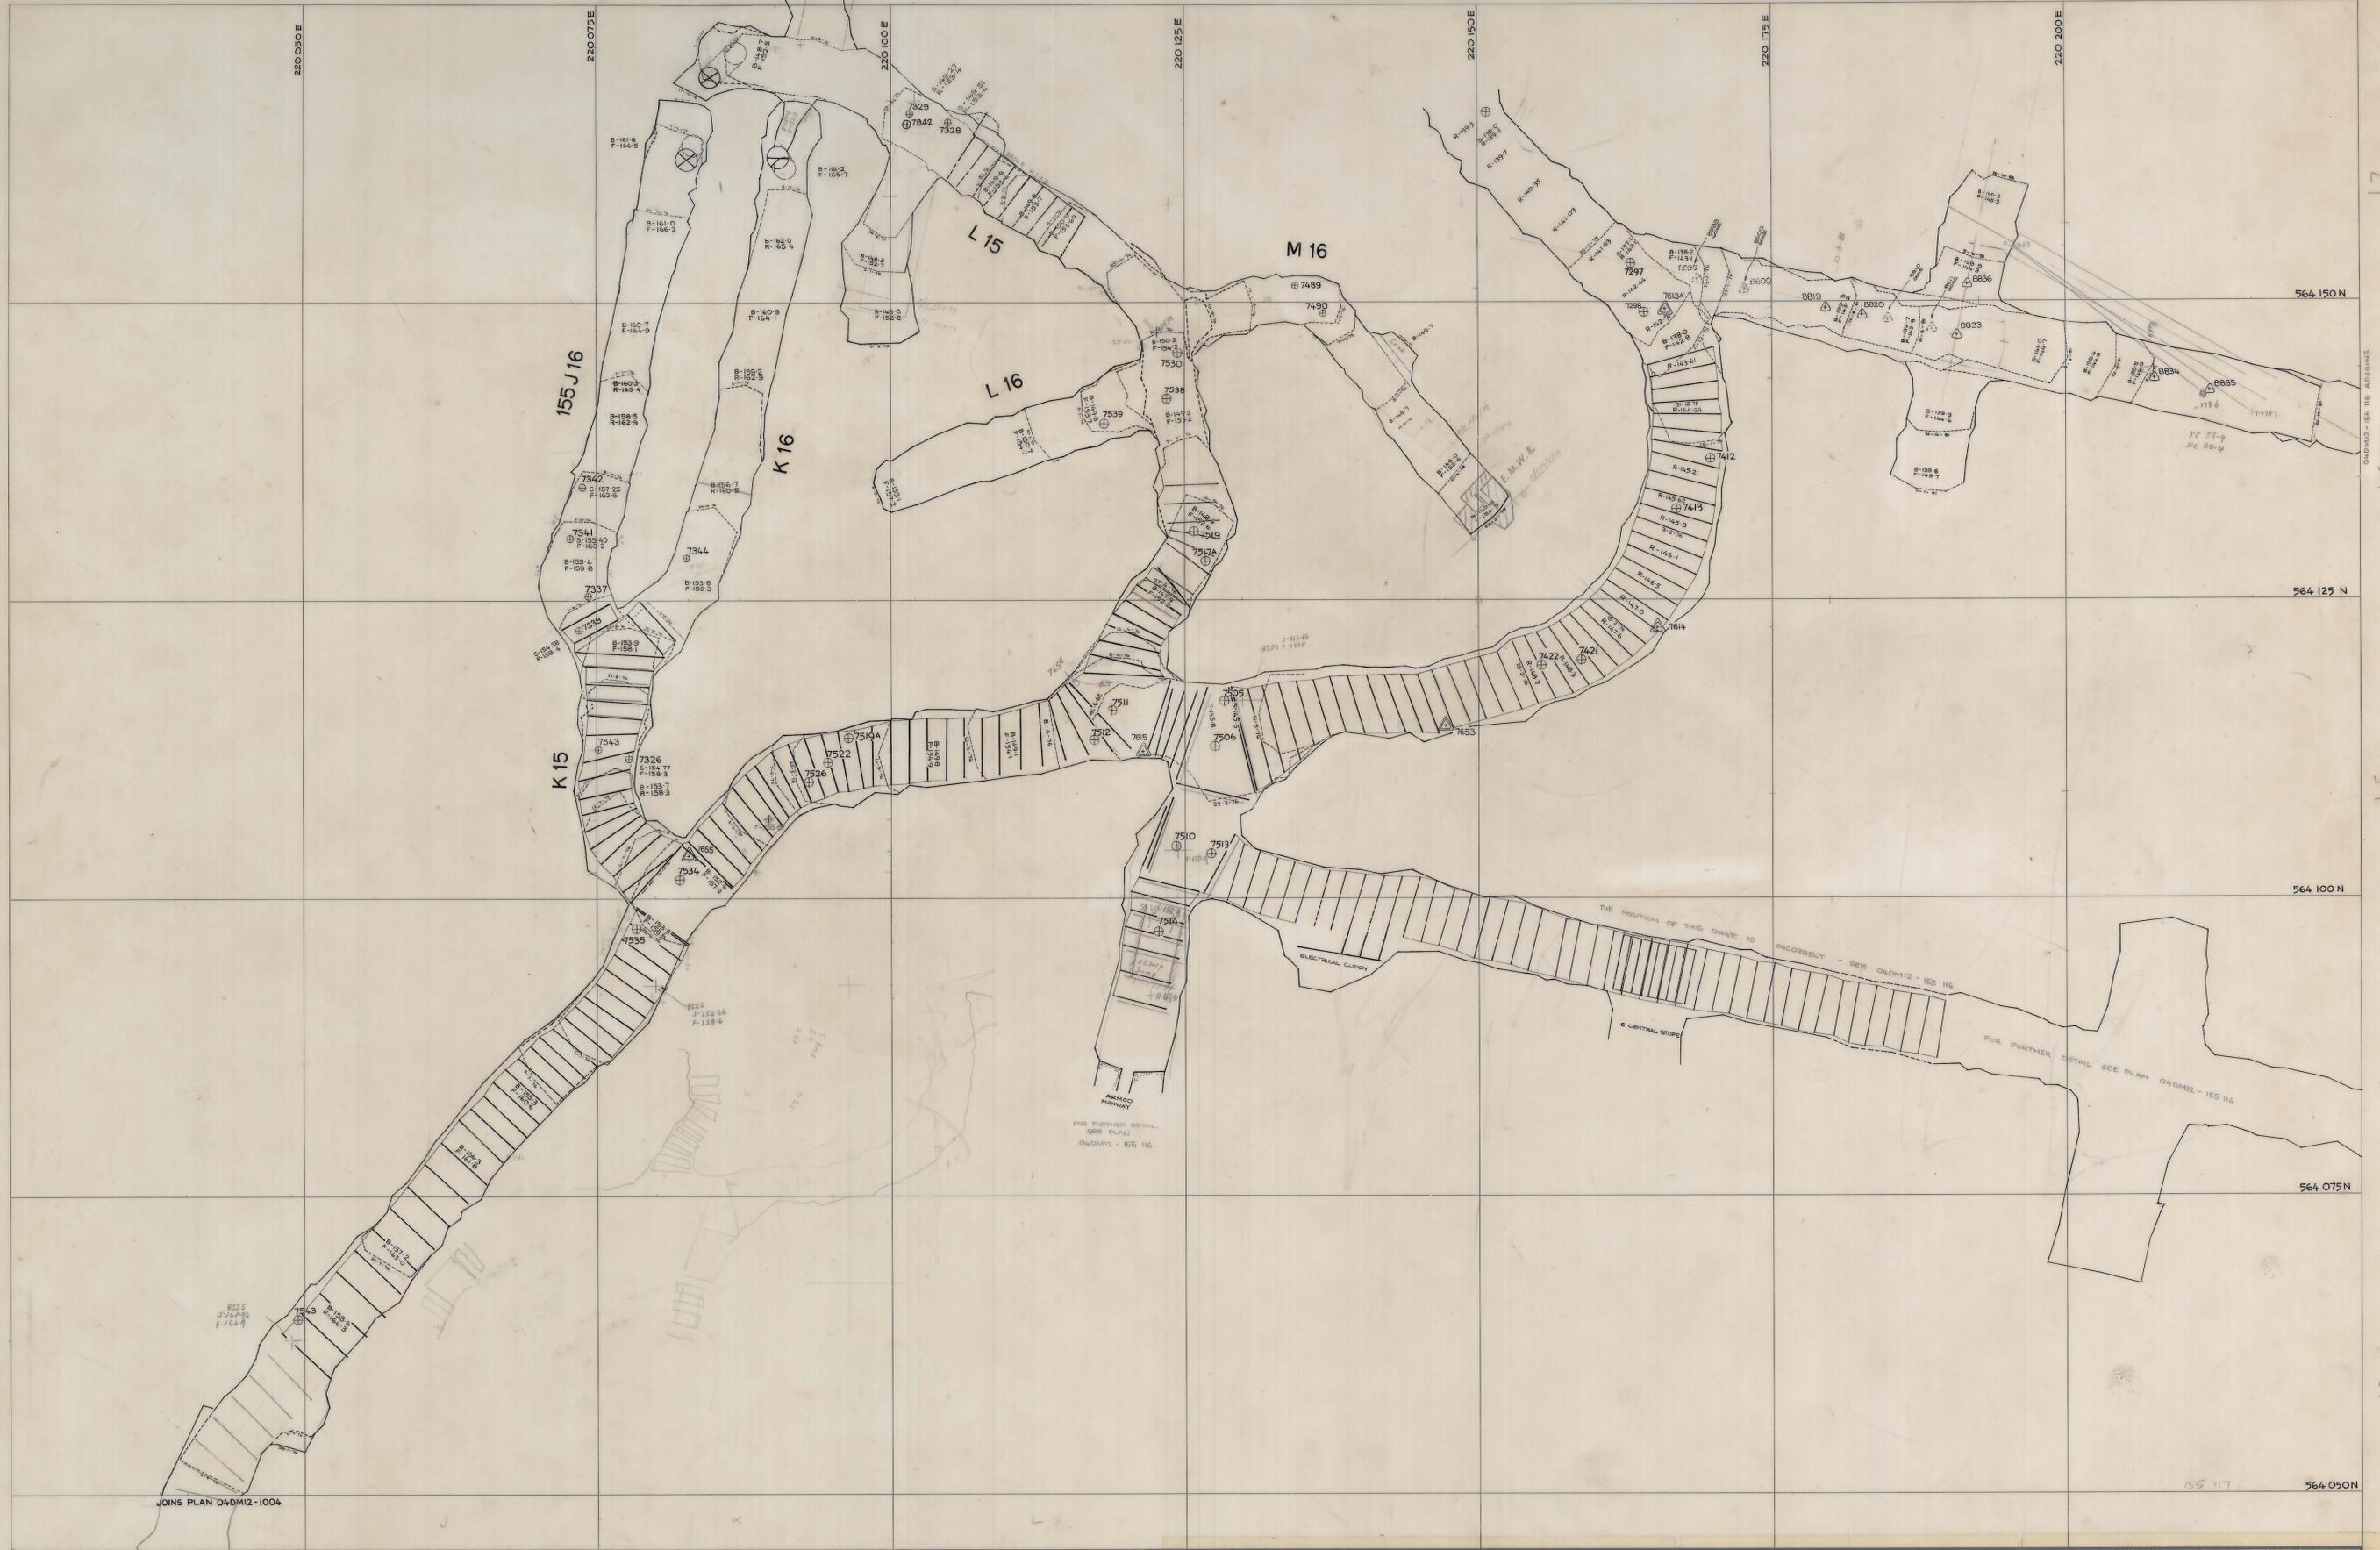

JOINS PLAN 04DM12-1004

SCALE 1:250

100 scale plans of this area, drawing 04DM11-0002
04DM11-1010

200 scale plans of this area, drawing 04DM11-1005
04DM11-3004 716 X136 Calc Steel m 154

LOCATION DOLPHIN MINE

SUBJECT

-150m ZONE DEVELOPMENT

north

KS KING ISLAND SCHEELITE
A DIVISION OF WARMAN INTERNATIONAL

GRASSY KING ISLAND

PLAN NUMBER **04DM12 - 1002**