


5 cm

27 JUN 1981

04DM12-156151

MAIN DECLINE

0374-2138

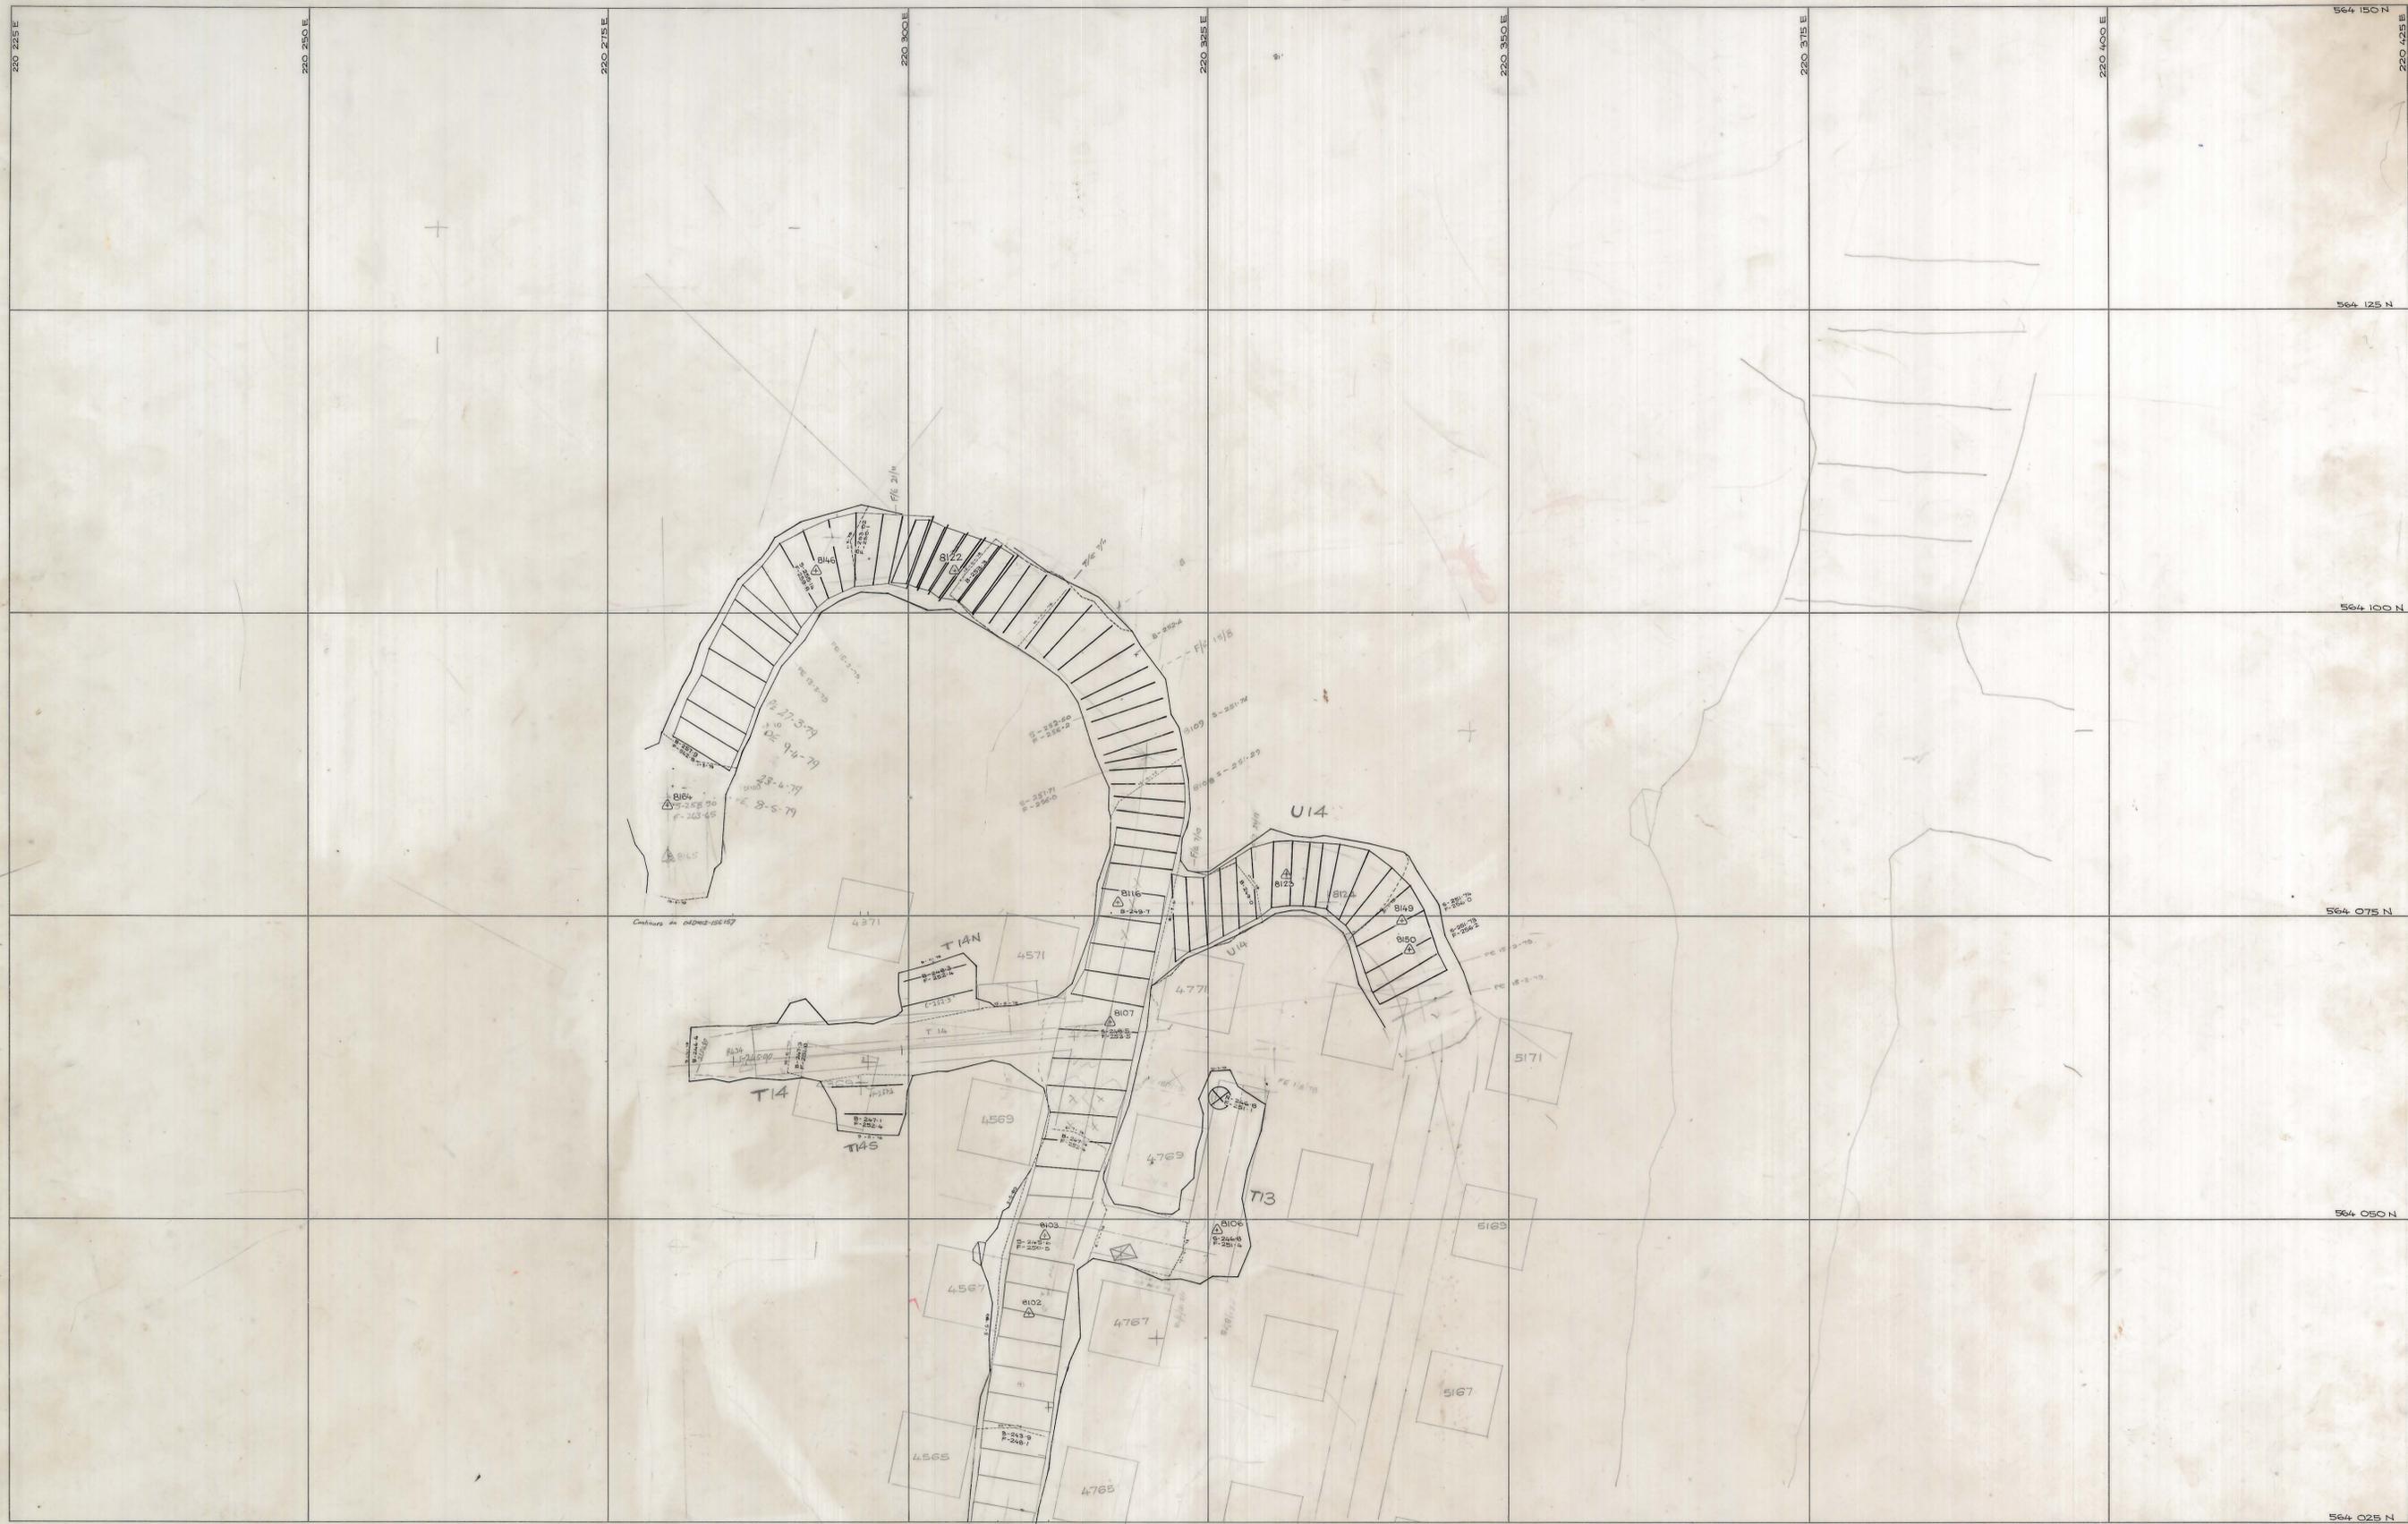

LOCATION DOLPHIN MINE

SUBJECT

MAIN DECLINE

north

**KIS** KING ISLAND SCHEELITE  
A DIVISION OF WARMAN INTERNATIONAL

GRASSY KING ISLAND

PLAN NUMBER

04DM12 - 156 151